


MAP TO ACCOMPANY APPLICATION TO CHANGE PLACE OF USE & ADD POINTS OF APPROPRIATION FOR DUNBAR SILVIES RIVER RANCH, LLC

TAX LOTS 4600 & 4700
IN SECTIONS 27 & 28, TOWNSHIP 23 SOUTH, RANGE 32 EAST, W.M.
HARNEY COUNTY, OREGON

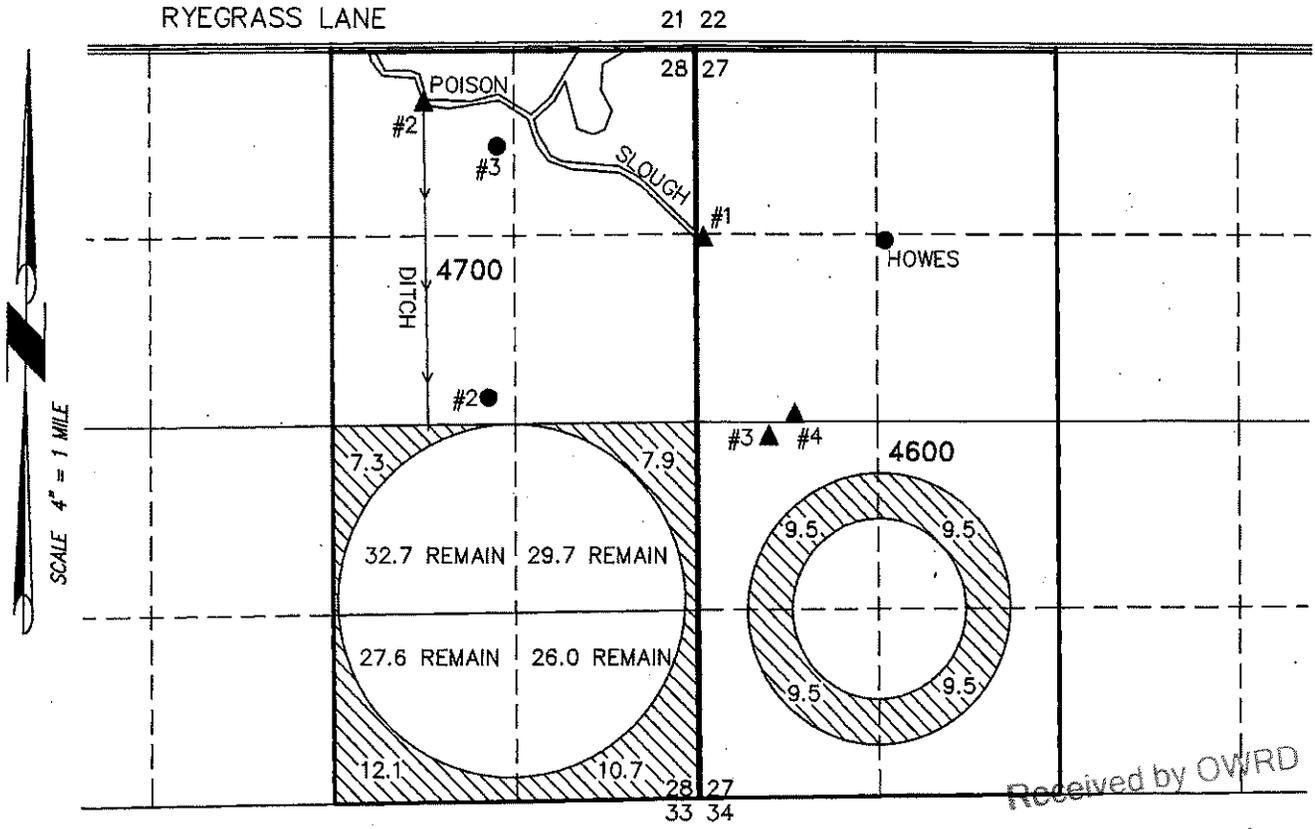

Received by OWRD

AUG 07 2021

Salem, OR

- WELL #2 (HARN 602) IN THE SW 1/4 OF THE NE 1/4 SECTION 28 & 2890' NORTH & 1520' WEST FROM THE SE CORNER SECTION 28.
- HOWES WELL (HARN 592) IN THE SE 1/4 OF THE NW 1/4 SECTION 27 & 20.5 CHAINS SOUTH & 21 CHAINS EAST FROM THE NW CORNER SECTION 27.
- WELL #3 (HARN 52832) IN THE NW 1/4 OF THE NE 1/4 SECTION 28 AT 43°33'14.87" N 118°53'16.62" W.

 38.0 ACRES 'IS' FROM WELL 2 CERTIFICATE 33151 (PERMIT G-1484) TRANSFERRED, AS SHOWN.



RENEWAL DATE: 12/31/2022


THIS MAP IS FOR THE PURPOSE OF LOCATING A WATER RIGHT ONLY AND HAS NO INTENT TO PROVIDE LEGAL DIMENSIONS OR THE LOCATION OF PROPERTY LINES.

PROJECT No. 18-003	ALL POINTS ENGINEERING & SURVEYING, INC.  P.O. BOX 767 TERREBONNE, OREGON 97760 (541) 548-5833 PH scott@apeands.com www.APEandS.com
PREPARED AT THE REQUEST OF: DUNBAR SILVIES RIVER RANCH 9622 VICTOR ROAD ANCHORAGE, AK 99515	

CLAIM OF BENEFICIAL USE MAP

TO CHANGE PLACE OF USE AND
ADD POINTS OF APPROPRIATION
FOR APPLICATION T-13395
DUNBAR'S SILVIES RIVER RANCH, LLC

TOWNSHIP 23 SOUTH, RANGE 32 EAST, SECTION 27, W.M.
TAX LOT: 4600 HARNEY COUNTY, OREGON

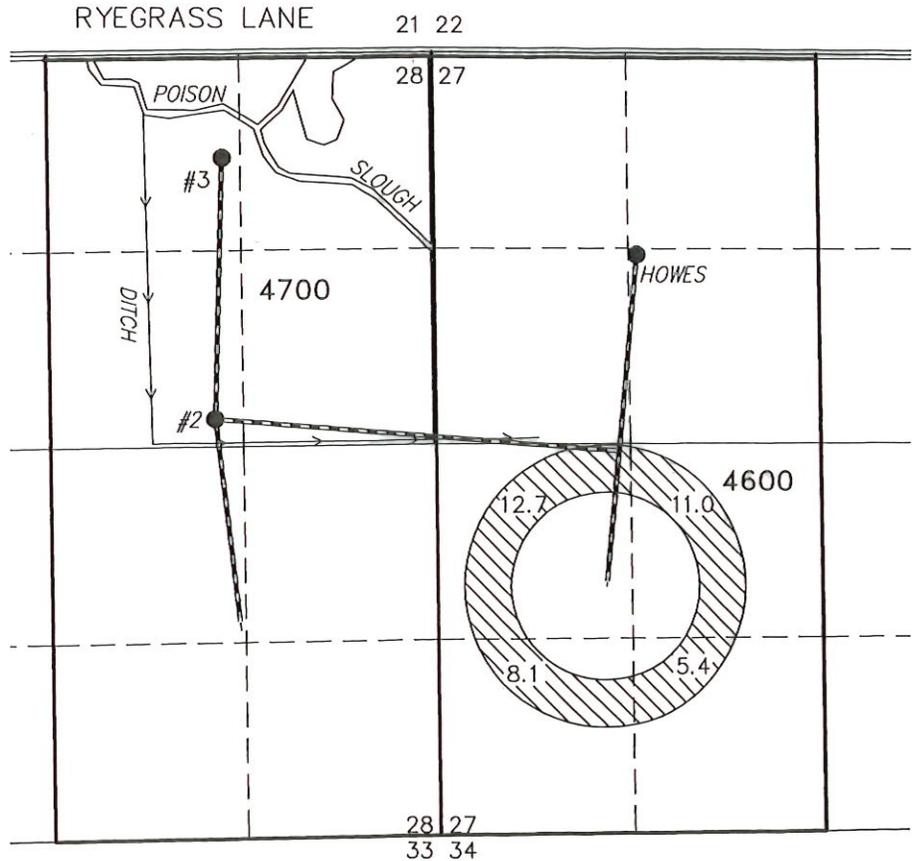

 38.0 ACRES 'IS' FROM WELLS
HOWE, #2, & #3 PER
T-13395 (PERMIT G-1484)



RENEWAL DATE: 12/31/2024

THIS MAP IS FOR THE PURPOSE OF LOCATING A WATER
RIGHT ONLY AND HAS NO INTENT TO PROVIDE LEGAL
DIMENSIONS OR THE LOCATION OF PROPERTY LINES

- WELL #2 (HARN 602) IN THE SW 1/4 OF THE NE 1/4 SECTION 28 & 2890' NORTH & 1520' WEST FROM THE SE CORNER SECTION 28.
FLOWMETER IS LOCATED 4.0' SE'LY FROM WELL.
- HOWES WELL (HARN 592) IN THE SE 1/4 OF THE NW 1/4 SECTION 27 & 20.5 CHAINS SOUTH & 21 CHAINS EAST FROM THE NW CORNER SECTION 27.
FLOWMETER IS LOCATED 6.0' S'LY FROM WELL.
- WELL #3 (HARN 52832) IN THE NW 1/4 OF THE NE 1/4 SECTION 28 & 700' SOUTH & 1450' WEST FROM THE NE CORNER OF SECTION 28.
FLOWMETER IS LOCATED 7.0' S'LY FROM WELL.

PREPARED FOR:

DUNBAR'S SILVIES RIVER RANCH, LLC
9622 VICTOR ROAD
ANCHORAGE, AK 99516

PREPARED BY:



ALL POINTS ENGINEERING AND SURVEYING, INC.
P.O. BOX 767 TERREBONNE, OR 97760
(541) 548-5833 www.APEandS.com

Received
DEC 10 2024

OWRD