


# CLAIM OF BENEFICIAL USE MAP

TO CHANGE PLACE OF USE AND  
POINT OF DIVERSION  
FOR APPLICATION T-13395  
DUNBAR'S SILVIES RIVER RANCH, LLC

TOWNSHIP 23 SOUTH, RANGE 32 EAST, SECTION 27, W.M.  
TAX LOT: 4600 HARNEY COUNTY, OREGON

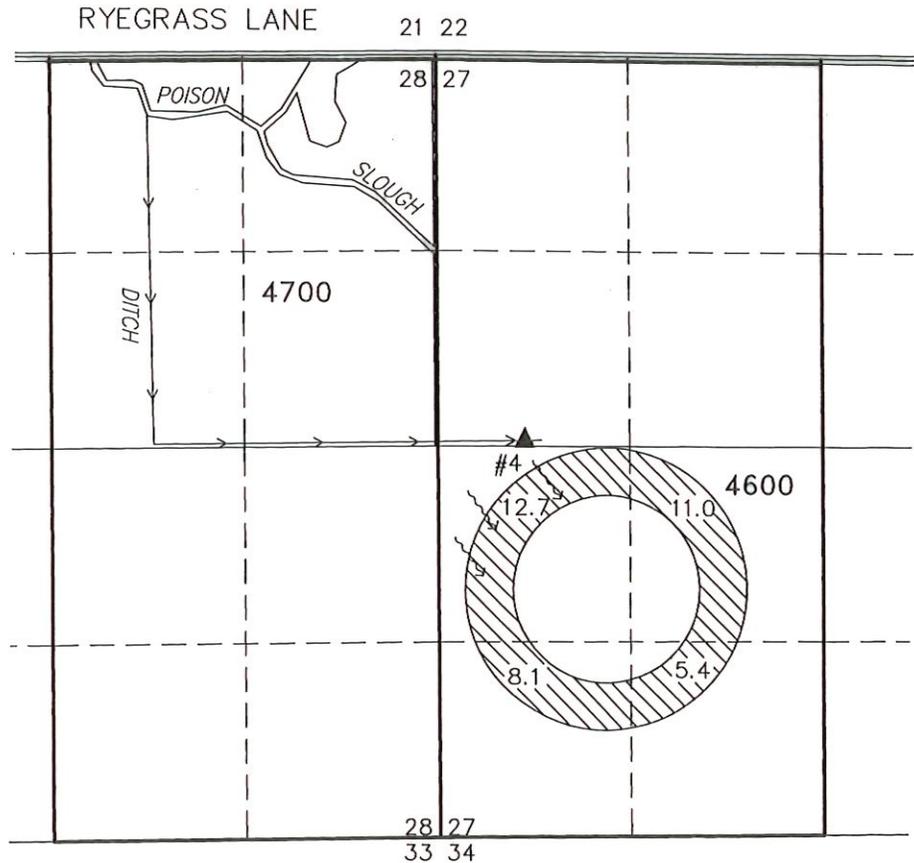

Received  
OCT 10 2024  
OWRD



RENEWAL DATE: 12/31/2024

THIS MAP IS FOR THE PURPOSE OF LOCATING A WATER  
RIGHT ONLY AND HAS NO INTENT TO PROVIDE LEGAL  
DIMENSIONS OR THE LOCATION OF PROPERTY LINES

▲ POD #4 IN THE SW 1/4 OF THE NW 1/4 SECTION 27  
LOCATED 2600' SOUTH & 590' EAST FROM THE NW  
CORNER OF SECTION 27.

MEASURING DEVICE LOCATED 30' NORTH FROM POD.

 38.0 ACRES 'IR' FROM POISON CREEK  
SLOUGH PER T-13395 (PERMIT 25838).

PREPARED FOR:

DUNBAR'S SILVIES RIVER RANCH, LLC  
9622 VICTOR ROAD  
ANCHORAGE, AK 99516


PREPARED BY:



ALL POINTS ENGINEERING AND SURVEYING, INC.  
P.O. BOX 767 TERREBONNE, OR 97760  
(541) 548-5833 www.APEandS.com

# MAP TO ACCOMPANY APPLICATION TO CHANGE PLACE OF USE & POINT OF DIVERSION FOR DUNBAR SILVIES RIVER RANCH, LLC


TAX LOTS 4600 & 4700  
 IN SECTIONS 27 & 28, TOWNSHIP 23 SOUTH, RANGE 32 EAST, W.M.  
 HARNEY COUNTY, OREGON

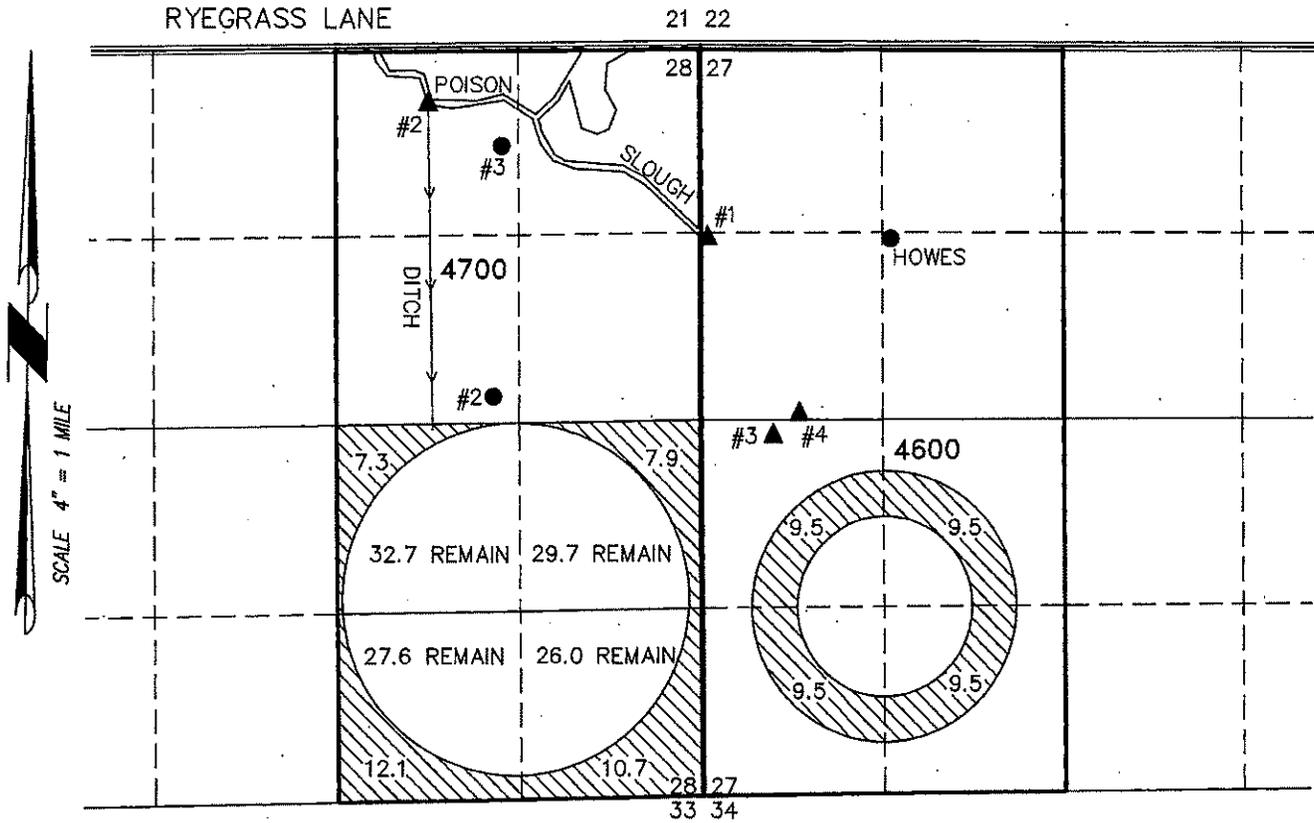

▲ AUTHORIZED POD #2 IN THE NW 1/4 OF THE NE 1/4 SECTION 28. 4880' N & 1940' W FROM THE SE CORNER SECTION 28.

▲ PROPOSED POD #4 IN THE SW 1/4 OF THE NW 1/4 SECTION 27. GEODETIC COORDINATES ARE 43°32'54.84" N & 118°52'46.84" W IN WGS84 PROJECTION.

 38.0 ACRES 'IR' FROM POISON CREEK SLOUGH CERTIFICATE 33152 TRANSFERRED.

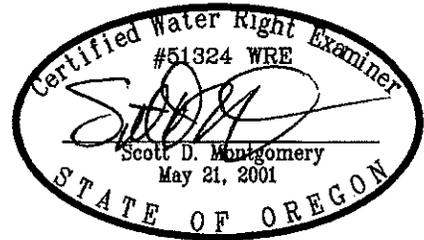

RENEWAL DATE: 12/31/2022

THIS MAP IS FOR THE PURPOSE OF LOCATING A WATER RIGHT ONLY AND HAS NO INTENT TO PROVIDE LEGAL DIMENSIONS OR THE LOCATION OF PROPERTY LINES.

PROJECT No. 18-003

PREPARED AT THE REQUEST OF:  
 DUNBAR SILVIES RIVER RANCH  
 9622 VICTOR ROAD  
 ANCHORAGE, AK 99515

**ALL POINTS ENGINEERING  
& SURVEYING, INC.**



P.O. BOX 767  
 TERREBONNE, OREGON 97760  
 (541) 548-5833 PH  
 scott@apeands.com  
 www.APEandS.com