

CLAIM OF BENEFICIAL USE MAP


TO CHANGE PLACE OF USE AND ADD A POINT OF APPROPRIATION
PER T-13925 FOR GOLDEN RULE FARMS, INC.

SECTION 1, TOWNSHIP 27 SOUTH, RANGE 31 EAST, W.M.

TAX LOTS: 200 & 300

SECTION 6, TOWNSHIP 27 SOUTH, RANGE 32 EAST, W.M.

TAX LOTS: 900 & 1000

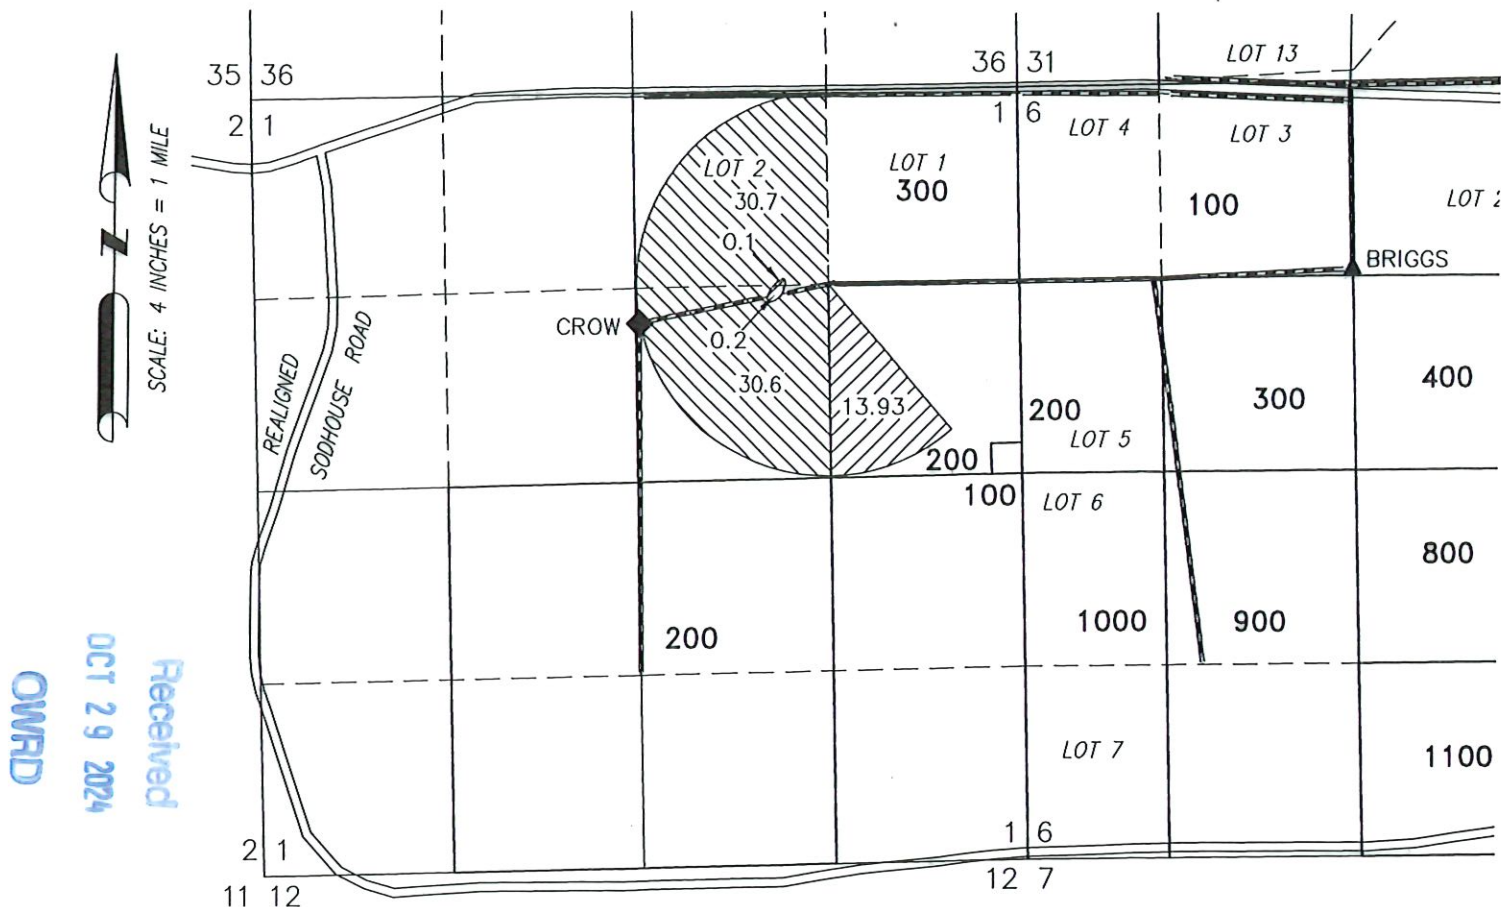

WELL 3 CROW (HARN 1461)

LOCATED IN THE SW 1/4 NE 1/4 SECTION 1, T27S R31E, W.M. AND 1542 FEET SOUTH AND 21 FEET EAST FROM THE N 1/4 CORNER OF SECTION 1.

FLOW METER IS LOCATED 4.0' SOUTH FROM WELL.

WELL 2 BRIGGS (HARN 1460)

LOCATED IN THE NE 1/4 NW 1/4 LOT 3) SECTION 6, T27S R32E, W.M. AND 1280 FEET SOUTH AND 1 FEET WEST FROM THE N 1/4 CORNER OF SECTION 6.

FLOW METER IS LOCATED 4.0' WEST FROM WELL.



14.23 ACRES IR FROM WELLS 2 & 3 (G-1463), AS SHOWN.



61.3 ACRES IR FROM WELLS 2 & 3 (G-13639), AS SHOWN.

THIS MAP IS FOR THE PURPOSE OF LOCATING A WATER RIGHT ONLY AND HAS NO INTENT TO PROVIDE LEGAL DIMENSIONS OR THE LOCATION OF PROPERTY LINES.

RENEWAL DATE: 12/31/2024

PREPARED FOR:

GOLDEN RULE FARMS, INC.
P.O. BOX 255
CHRISTMAS VALLEY, OR 97641

PREPARED BY:



ALL POINTS ENGINEERING AND SURVEYING, INC.
P.O. BOX 767
(541) 548-5833
TERREBONNE, OR 97760
www.APEandS.com