


CLAIM OF BENEFICIAL USE MAP

TO ADD A POINT OF APPROPRIATION AND CHANGE PLACE OF USE
FOR T-12583
JRS PROPERTIES III, LLLP


TOWNSHIP 27 SOUTH, RANGE 19 EAST, SECTIONS 20, 21, 28, & 29, W.M.
TAX LOTS: 2200 & 2800

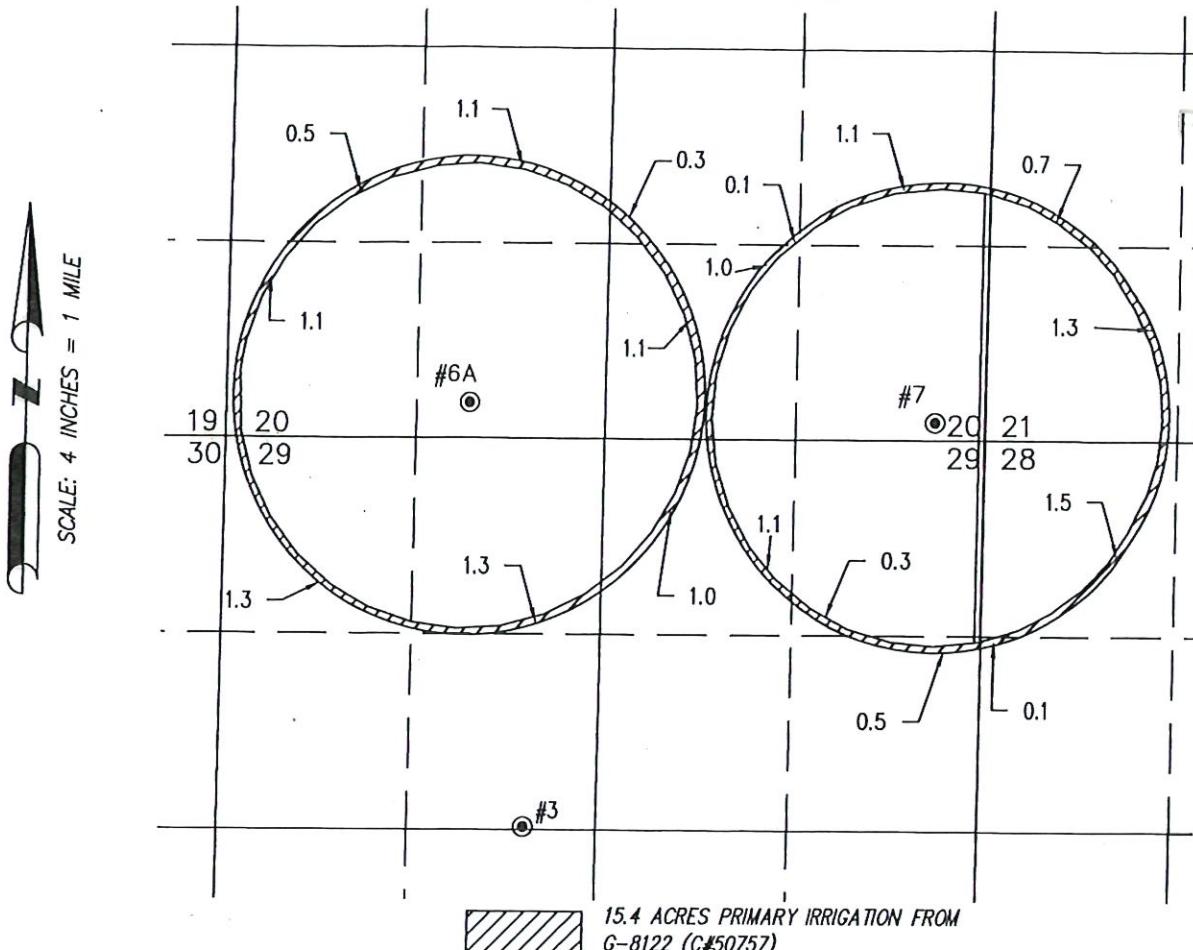

- WELL #6A (LAKE 1186)
SE 1/4 SW 1/4 SECTION 20, T27S
R19E, W.M.; 240 FEET NORTH AND
1670 FEET EAST FROM THE SW
CORNER OF SECTION 20.

- WELL #7 (LAKE 1179)
SE 1/4 SE 1/4 SECTION 20, T27S
R19E, W.M.; 120 FEET NORTH AND
350 FEET WEST FROM THE SE
CORNER OF SECTION 20.

THIS MAP IS FOR THE PURPOSE OF LOCATING
A WATER RIGHT ONLY AND HAS NO INTENT
TO PROVIDE LEGAL DIMENSIONS OR THE
LOCATION OF PROPERTY LINES

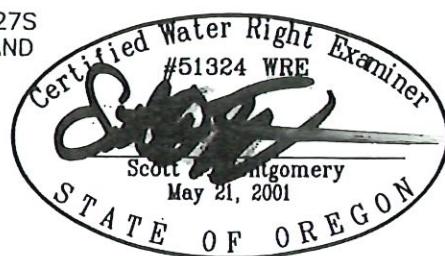

RENEWAL DATE: 12/31/2020

PREPARED FOR:

J.R.S. PROPERTIES III, LLLP
P.O. BOX 27
BOISE, ID 83707

PREPARED BY:



ALL POINTS ENGINEERING AND SURVEYING, INC.
P.O. BOX 767
(541) 548-5833


TERREBONNE, OR 97760

www.APEandS.com

CLAIM OF BENEFICIAL USE MAP

TO ADD A POINT OF APPROPRIATION AND CHANGE PLACE OF USE
FOR T-12583
JRS PROPERTIES III, LLLP

TOWNSHIP 27 SOUTH, RANGE 19 EAST, SECTIONS 19 & 20, W.M.
TAX LOTS: 2800 & 3200

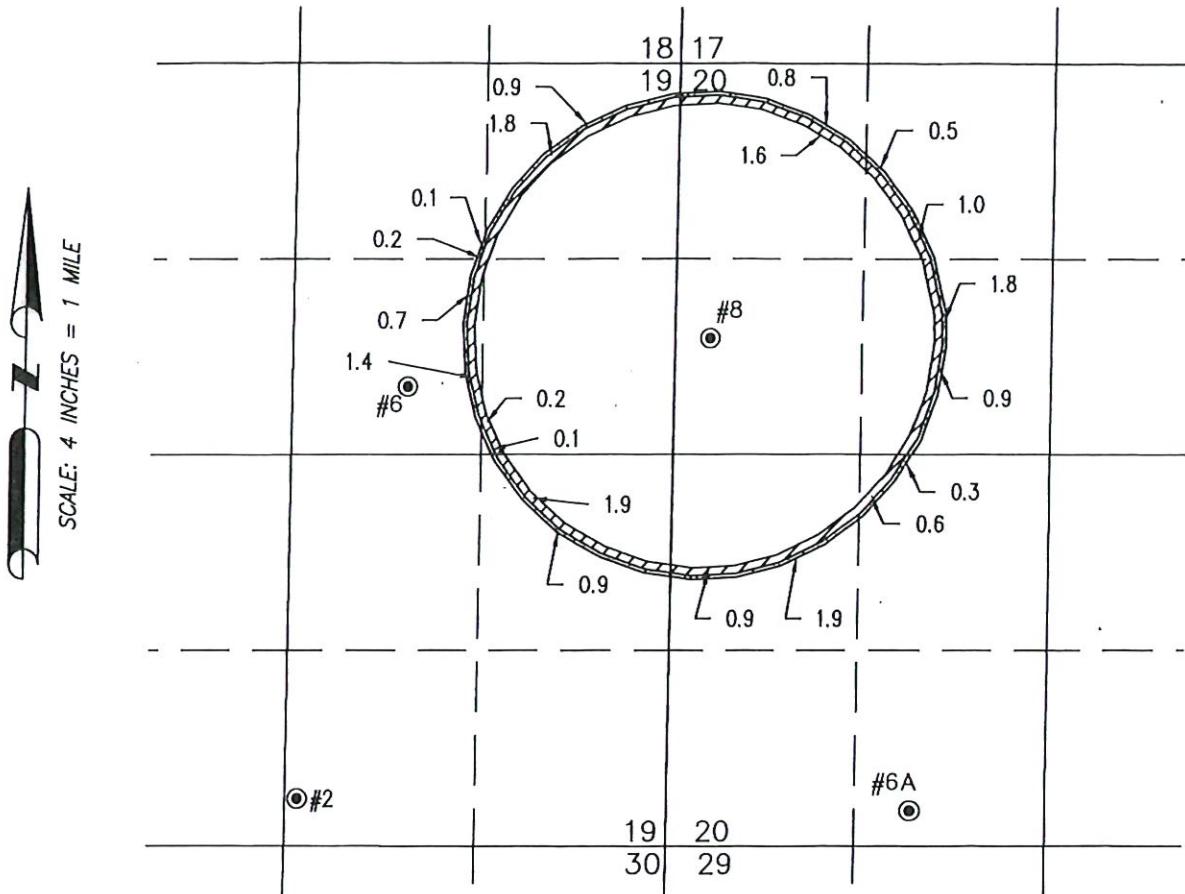


- **WELL #8**
SW 1/4 NW 1/4 SECTION 20, T27S
R19E, W.M.; 1860 FEET SOUTH AND
240 FEET EAST FROM THE NW
CORNER OF SECTION 20.



12.4 ACRES PRIMARY IRRIGATION
FROM G-8122 (C#50757)



6.1 ACRES PRIMARY IRRIGATION
FROM G-8988 (C#65758)

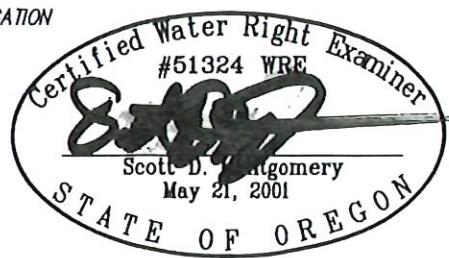

THIS MAP IS FOR THE PURPOSE OF LOCATING
A WATER RIGHT ONLY AND HAS NO INTENT
TO PROVIDE LEGAL DIMENSIONS OR THE
LOCATION OF PROPERTY LINES

RENEWAL DATE: 12/31/2020

PREPARED FOR:
J.R.S. PROPERTIES III, LLLP
P.O. BOX 27
BOISE, ID 83707

PREPARED BY:

ALL POINTS ENGINEERING AND SURVEYING, INC.
P.O. BOX 767
(541) 548-5833

TERREBONNE, OR 97760
www.APEandS.com