


CLAIM OF BENEFICIAL USE MAP

TO ADD A POINT OF APPROPRIATION AND CHANGE PLACE OF USE
FOR T-12583

JRS PROPERTIES III, LLLP


TOWNSHIP 27 SOUTH, RANGE 19 EAST, SECTION 28, W.M.

TAX LOTS: 2200 & 3501

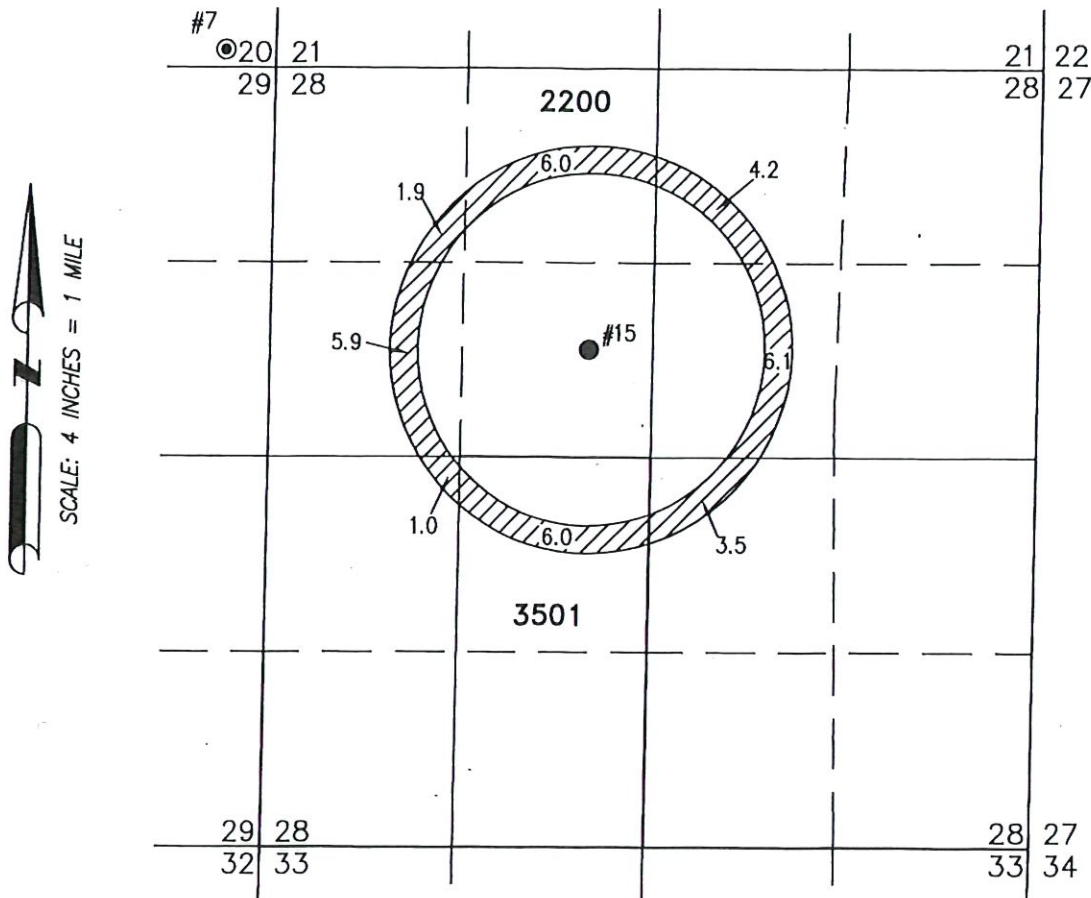

- WELL #15 (LAKE 1196)
SE 1/4 NW 1/4 SECTION 28, T27S
R19E, W.M.; 1910 FEET SOUTH AND
3110 FEET WEST FROM THE NE
CORNER OF SECTION 28.

34.6 ACRES PRIMARY IRRIGATION FROM
6-1915 (C#50760)

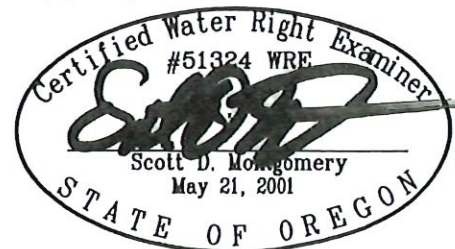

THIS MAP IS FOR THE PURPOSE OF LOCATING
A WATER RIGHT ONLY AND HAS NO INTENT
TO PROVIDE LEGAL DIMENSIONS OR THE
LOCATION OF PROPERTY LINES

RENEWAL DATE: 12/31/2020

PREPARED FOR:

J.R.S. PROPERTIES III, LLLP
P.O. BOX 27
BOISE, ID 83707

PREPARED BY:



ALL POINTS ENGINEERING AND SURVEYING, INC.
P.O. BOX 767
(541) 548-5833
TERREBONNE, OR 97760
www.APEandS.com