


# CLAIM OF BENEFICIAL USE MAP

TO ADD A POINT OF APPROPRIATION AND CHANGE PLACE OF USE  
FOR T-12583  
JRS PROPERTIES III, LLLP

TOWNSHIP 27 SOUTH, RANGE 19 EAST, SECTION 28, W.M.  
TAX LOTS: 2200 & 3501

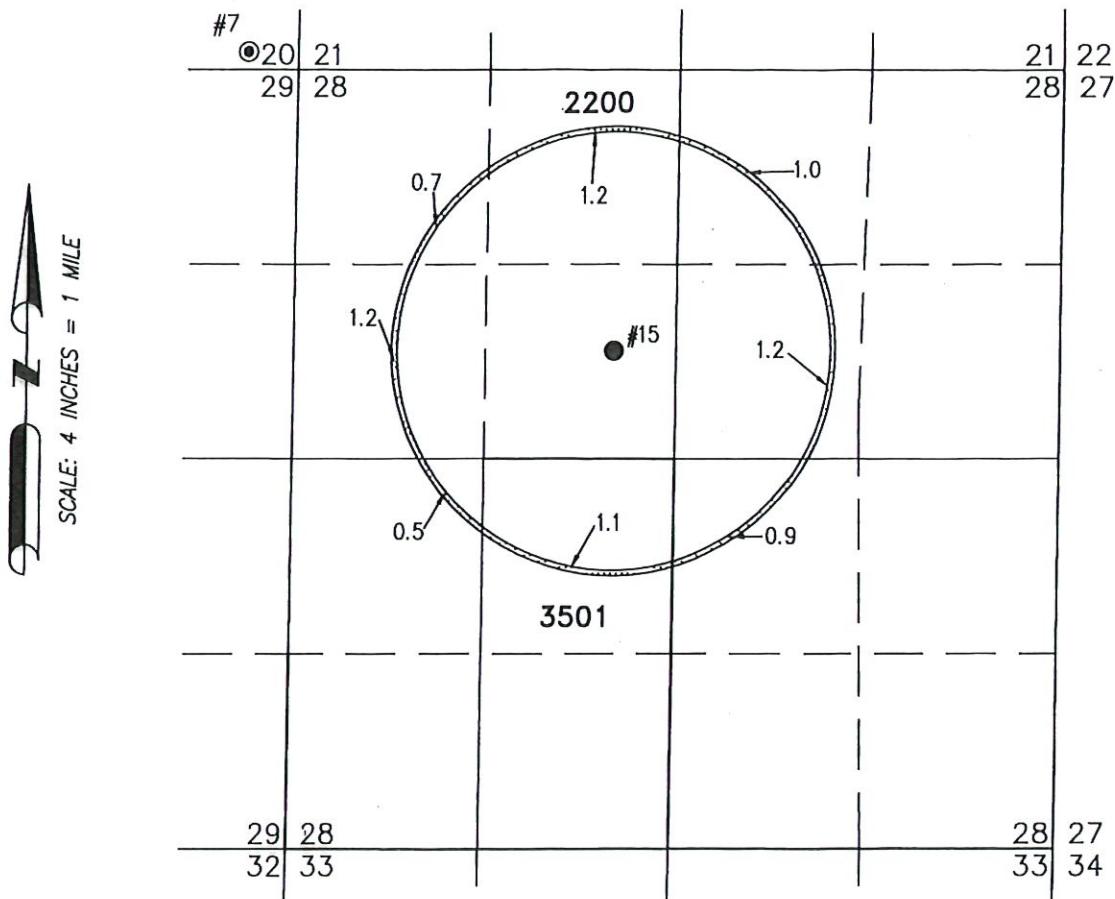

- **WELL #15 (LAKE 1196)**  
SE 1/4 NW 1/4 SECTION 28, T27S  
R19E, W.M.; 1910 FEET SOUTH AND  
3110 FEET WEST FROM THE NE  
CORNER OF SECTION 28.

7.8 ACRES PRIMARY IRRIGATION FROM  
G-6051 (C#65759)



THIS MAP IS FOR THE PURPOSE OF LOCATING  
A WATER RIGHT ONLY AND HAS NO INTENT  
TO PROVIDE LEGAL DIMENSIONS OR THE  
LOCATION OF PROPERTY LINES

RENEWAL DATE: 12/31/2020

PREPARED FOR:

J.R.S. PROPERTIES III, LLLP  
P.O. BOX 27  
BOISE, ID 83707

PREPARED BY:




ALL POINTS ENGINEERING AND SURVEYING, INC.  
P.O. BOX 767  
(541) 548-5833  
TERREBONNE, OR 97760  
www.APEandS.com

# CLAIM OF BENEFICIAL USE MAP

TO ADD A POINT OF APPROPRIATION  
FOR T-12583  
JRS PROPERTIES III, LLLP

TOWNSHIP 27 SOUTH, RANGE 19 EAST, SECTIONS 19 & 20, W.M.  
TAX LOTS: 2800 & 3200

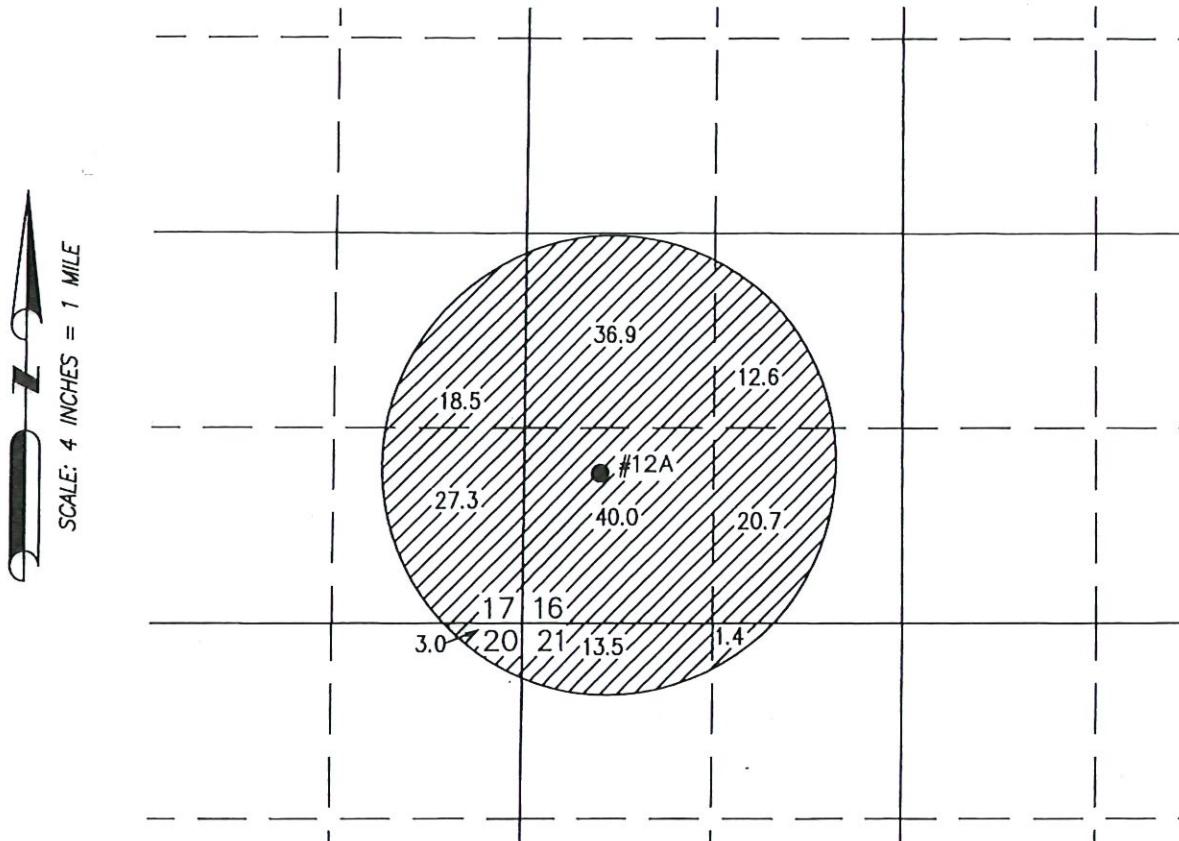

- WELL #12A (LAKE 52738/52768)  
SW 1/4 SW 1/4 SECTION 16, T27S  
R19E, W.M.; 1010 FEET NORTH AND  
535 FEET EAST FROM THE SW  
CORNER OF SECTION 16.



173.9 ACRES PRIMARY IRRIGATION  
FROM G-6051 (C#94917)



THIS MAP IS FOR THE PURPOSE OF LOCATING  
A WATER RIGHT ONLY AND HAS NO INTENT  
TO PROVIDE LEGAL DIMENSIONS OR THE  
LOCATION OF PROPERTY LINES

RENEWAL DATE: 12/31/2020

PREPARED FOR: J.R.S. PROPERTIES III, LLLP P.O. BOX 27 BOISE, ID 83707	PREPARED BY:  ALL POINTS ENGINEERING AND SURVEYING, INC. P.O. BOX 767 (541) 548-5833
--	---

TERREBONNE, OR 97760  
[www.APEandS.com](http://www.APEandS.com)