

Well Locations:

- #3 (HARN 51419): 2704' N, 1365' E of SW Cor Sec 1
 #4 (HARN 1213): 1217' N, 1370' E of SW Cor Sec 1
 #5 (HARN 51936/L-111160): 1400' N, 1520' W of SE Cor Sec 2


T25S R33E, WM
 HARNEY COUNTY, OR



0 1,320 Feet

1" = 1,320'

- Well
- Meter
- Pipeline
- POU IR 1/2/1991 Priority
- Township
- Section
- Quarter Quarter
- Tax Lot

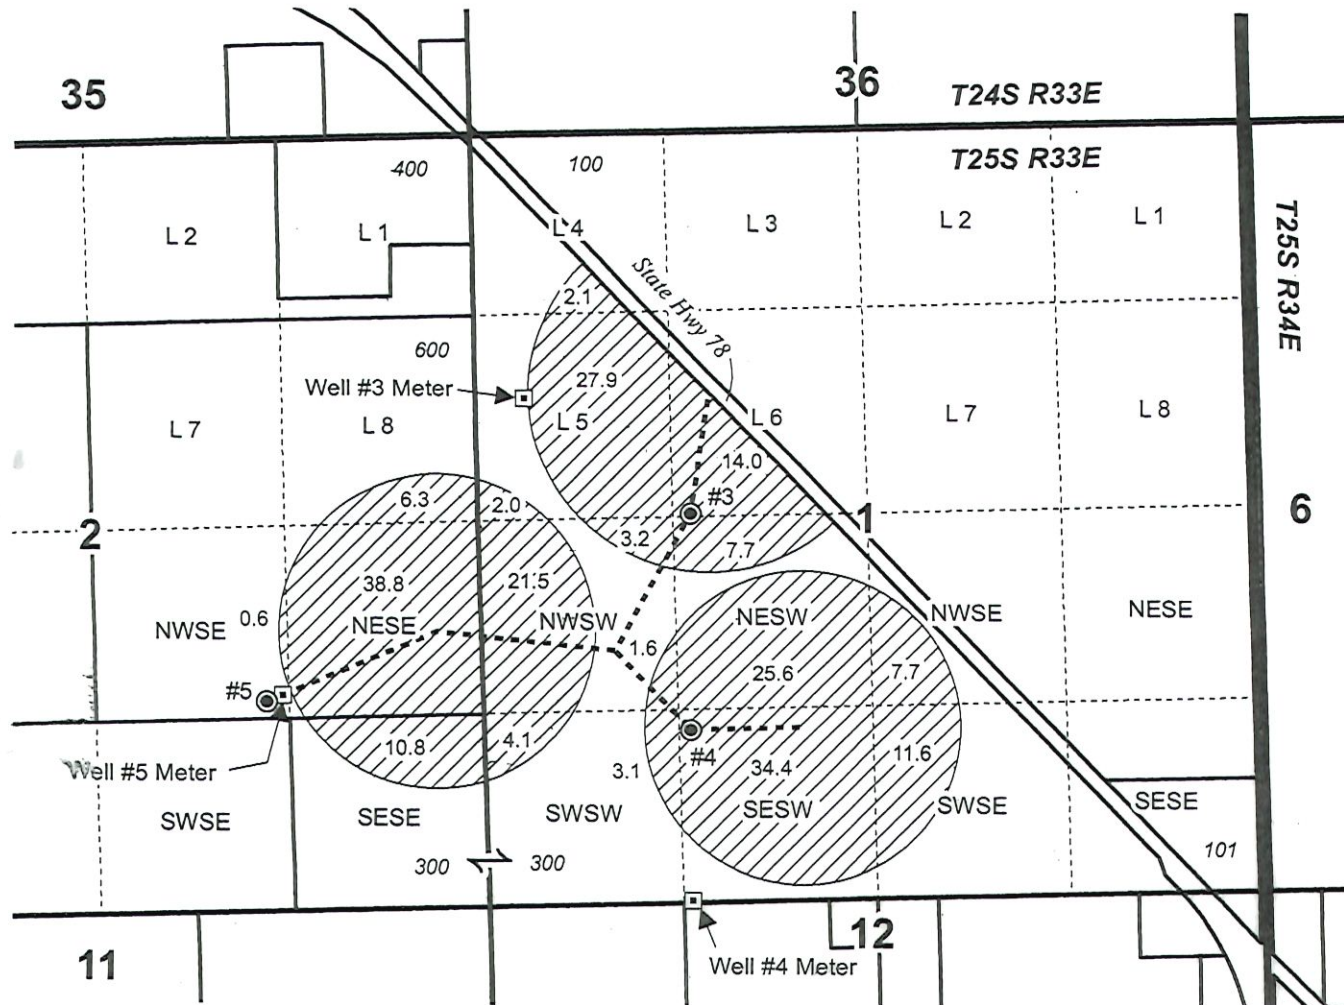

RENEWAL DATE 12/31/2025



CLAIM OF BENEFICIAL USE MAP
 Aldrich

Date: 3/14/2024

T-12362

Project #23075

Received

MAY 18 2024

OWRD

This map is not intended
 to provide legal dimensions
 or locations of property
 ownership lines.

WATER RIGHT SERVICES, LLC

PO BOX 1830, BEND, OR 97709

WWW.OREGONWATER.US CCB # 197121

johnshort@usa.com

541-389-2837