


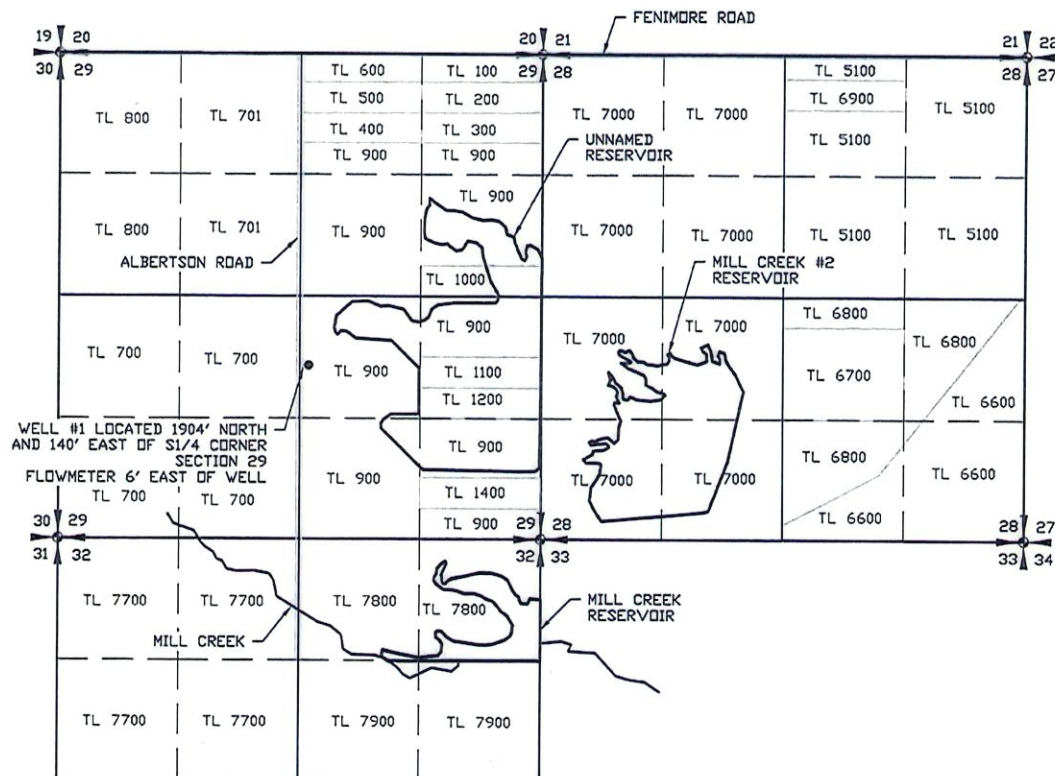

CLAIM OF BENEFICIAL USE MAP FOR JOHN ALBERTSON

SECTIONS 28, 29 & 32
T40S R19E W.M.
LAKE COUNTY, OREGON


LEGEND

- SECTION LINE
- 1/4 SECTION LINE
- 1/16 SECTION LINE
- RESERVIOR

TRANSFER NO. T-13851



SCALE: 1"=1320'

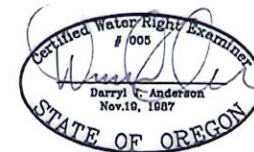

RENEWAL 12/31/25

NOTE:
PREPARATION OF THIS MAP IS FOR IDENTIFYING WATER RIGHTS ONLY. IT
HAS NO INTENT TO PROVIDE LOCATIONS OR DIMENSIONS OF PROPERTY
BOUNDARIES.

REVISION	BY

ANDERSON ENGINEERING
AND SURVEYING, INC.
P.O. BOX 28
LAKEVIEW, OREGON 97630
(541) 947-4407/FAX 947-2321
WWW.ANDERSONENGINEERING.COM

FOR: JOHN ALBERTSON
14377 ALBERTSON RD
LAKEVIEW, OR 97630
503-650-4799

CLAIM OF BENEFICIAL USE MAP
TRANSFER NO. T-13851
SEC. 28, 29, & 32, T40S, R19E W.M.

DATE: 7/10/2025
SCALE: 1" = 1320'
DWG. BY: R.C.
JOB: 225035
FILE: 225035
SHEET: 1 OF 1