



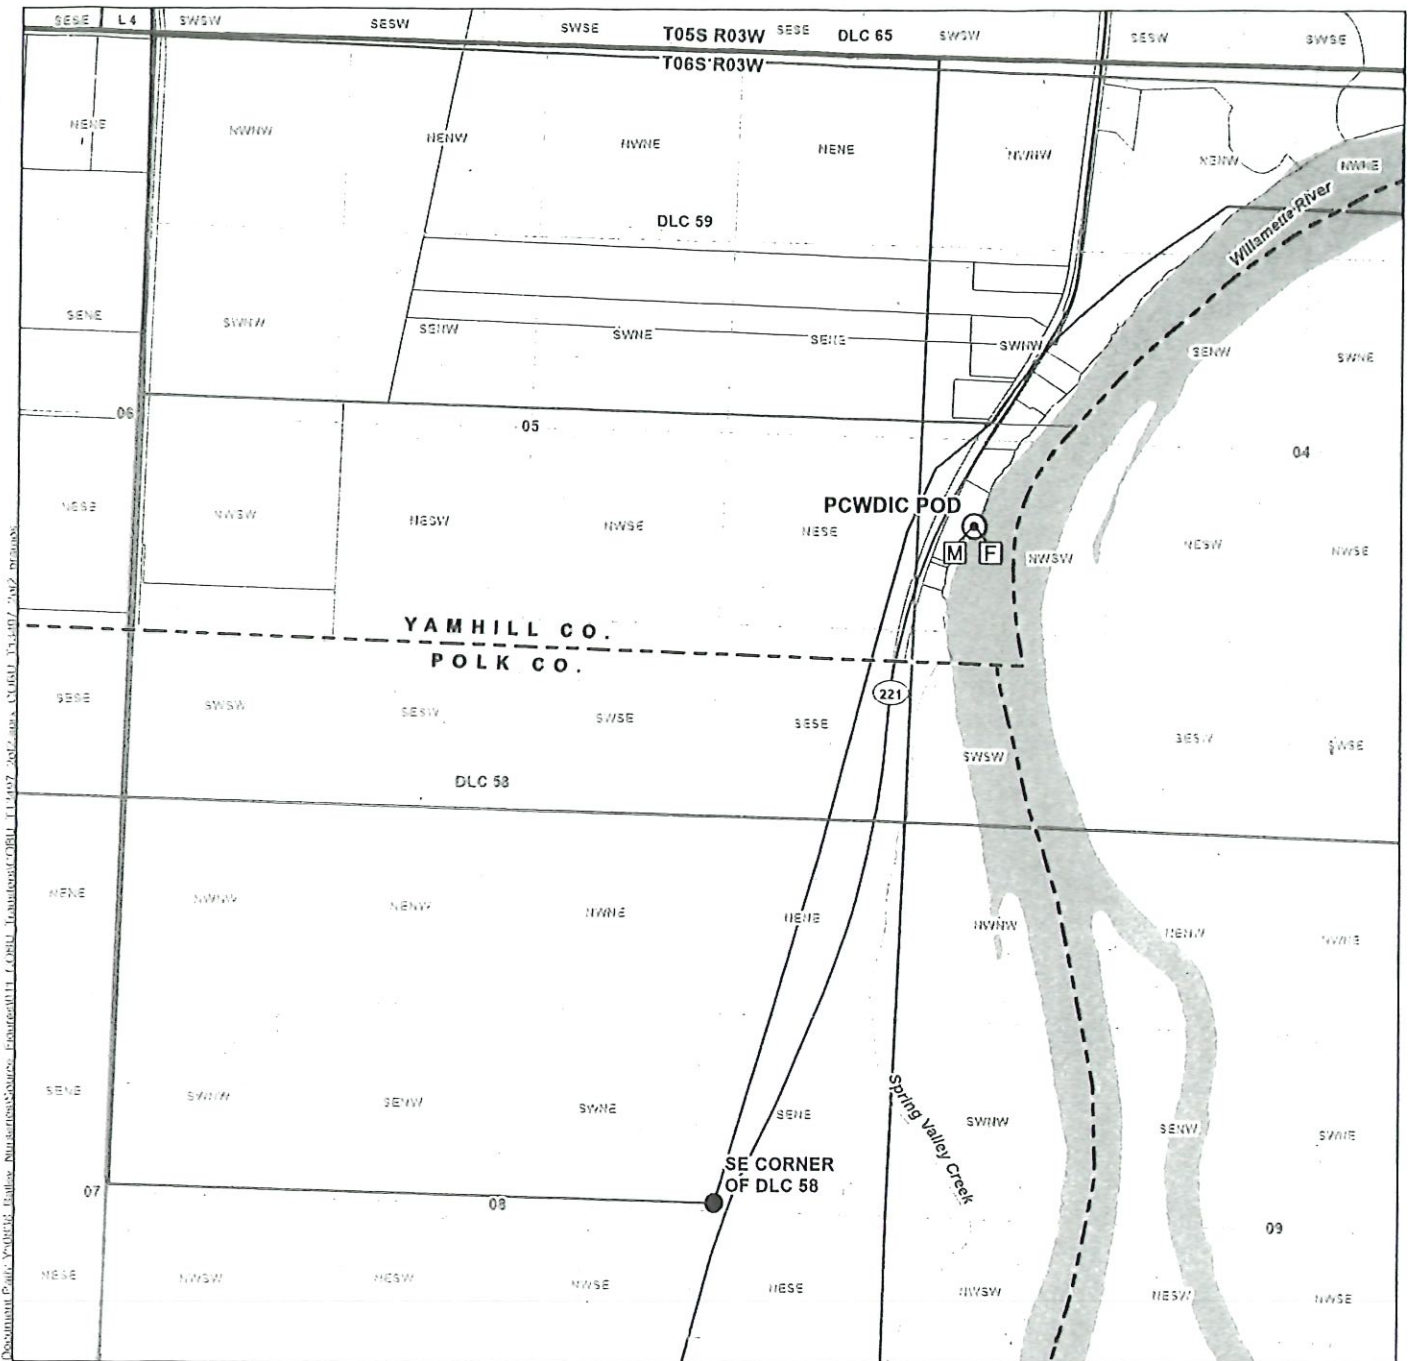

LEGEND

- ⊙ Point of Diversion (POD)
- [F] Fish Screen
- [M] Meter
- All Other Features
- County Boundary
- Tax Lot
- Donation Land Survey (DLC)
- Major Road
- Watercourse

CERTIFIED WATER RIGHTS EXAMINER STAMP

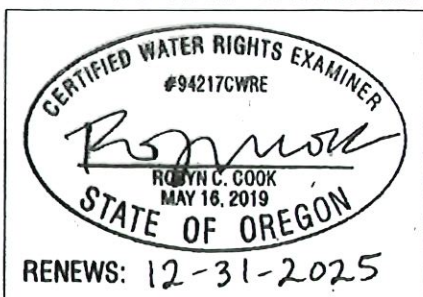

LOCATION DESCRIPTION

PCWDIC POD
Located 4,700 feet North and 1,290 feet East from the SE corner of DLC 58, Township 6 South, Range 3 West (W.M.)

Claim of Beneficial Use Map Application S-72555; Transfer T-13497

Map 2 of 2


Yamhill County


Township 6 South, Range 3 West (W.M.)

Received
JAN 24 2020
OWRI

DISCLAIMER
This map was prepared for the purpose of identifying the location of a water right only and it is not intended to provide legal dimensions or location of property ownership lines.

Date: September 24, 2024
Data Sources: BLM, ESRI, OWRI, USGS

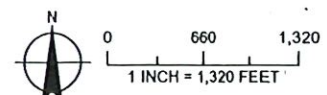

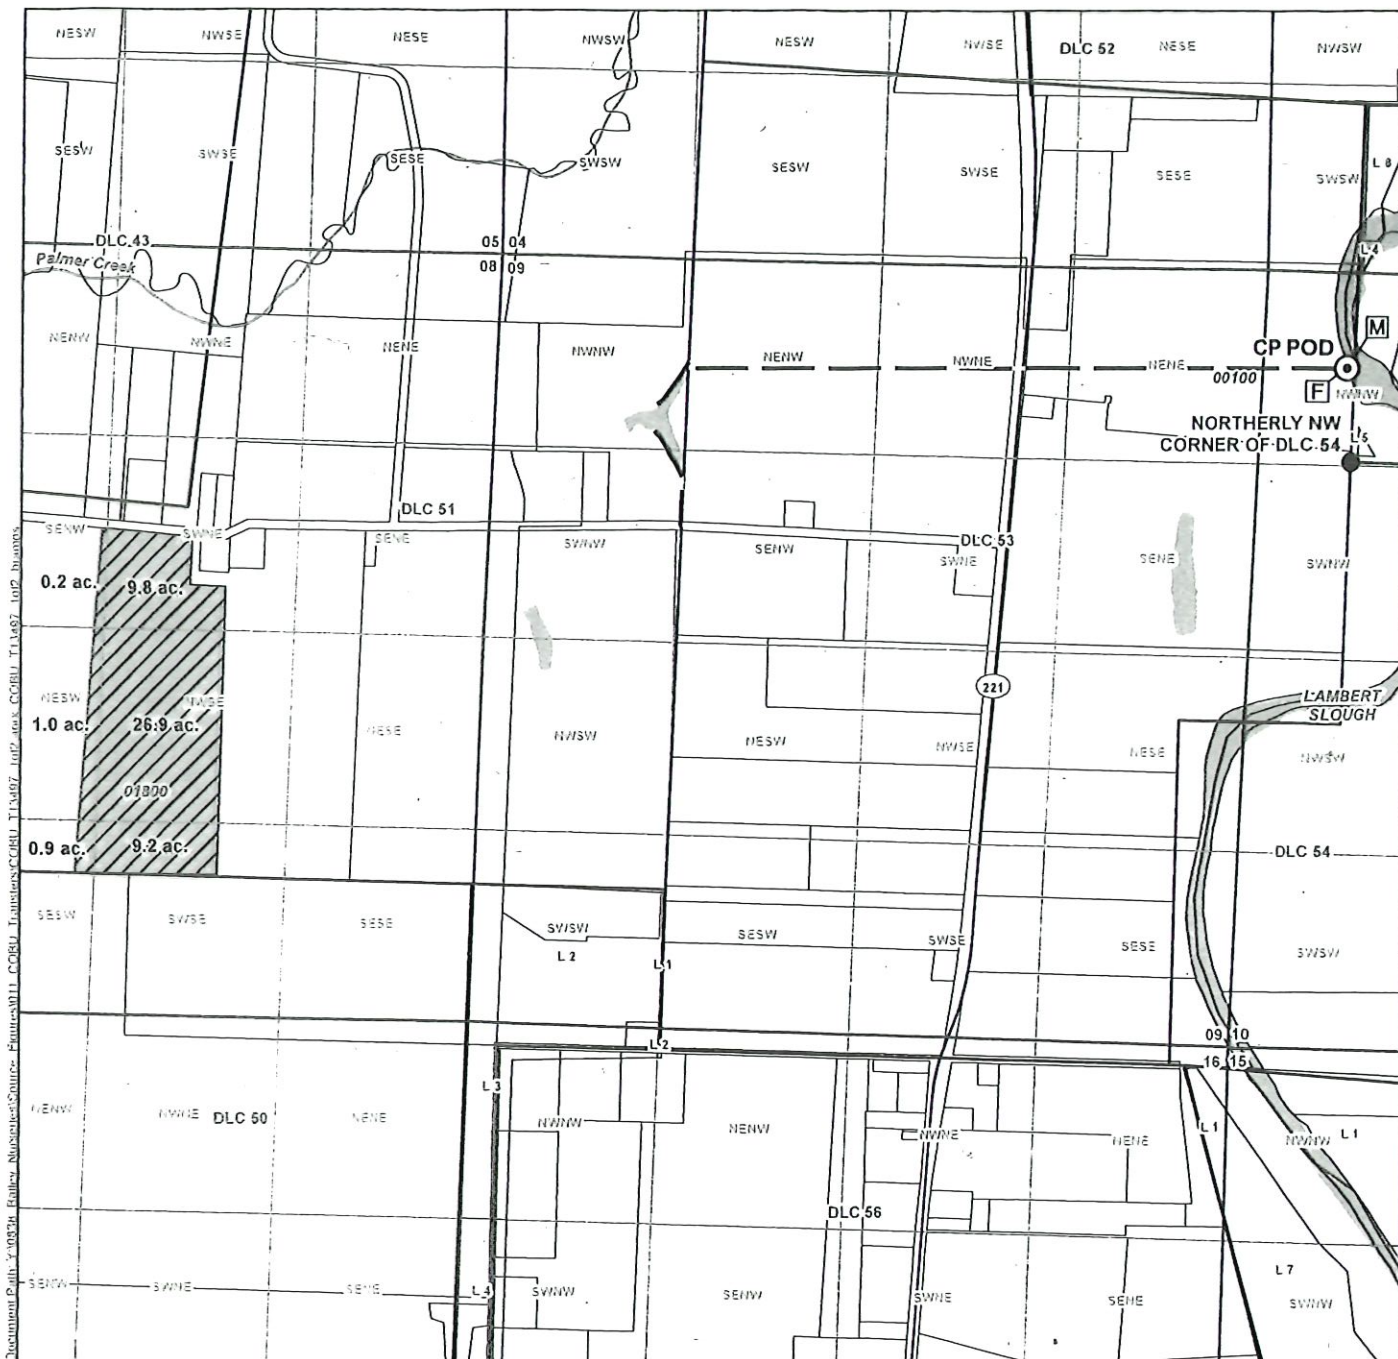


LEGEND

- ⊙ Point of Diversion (POD)
- F Fish Screen
- M Meter
- Conveyance Line
- ▨ Place of Use (POU)
- Tax Lot
- Donation Land Survey (DLC)
- Government Lot (GL)
- Major Road
- ~ Watercourse
- Waterbody

All Other Features

- Tax Lot

CERTIFIED WATER RIGHTS EXAMINER STAMP

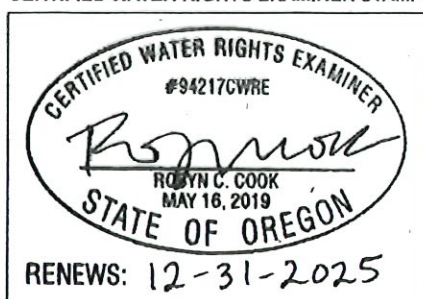

LOCATION DESCRIPTION

CP POD
Located 608 feet North and 40 feet West from the Northerly NW corner of DLC 54, Township 5 South, Range 3 West (W.M.)

Claim of Beneficial Use Map Application S-72555; Transfer T-13497

Map 1 of 2

Yamhill County

Township 5 South, Range 3 West (W.M.)

DISCLAIMER

This map was prepared for the purpose of identifying the location of a water right only and it is not intended to provide legal dimensions or location of property ownership lines.

Date: January 10, 2025
Data Sources: BLM, ESRI, OWRD, USGS

