



# CLAIM OF BENEFICIAL USE MAP

TO CHANGE PLACE OF USE  
PER T-14340 FOR GOLDEN RULE FARMS, INC.

SECTION 6, TOWNSHIP 27 SOUTH, RANGE 32 EAST, W.M.  
TAX LOTS: 100, 300, & 400

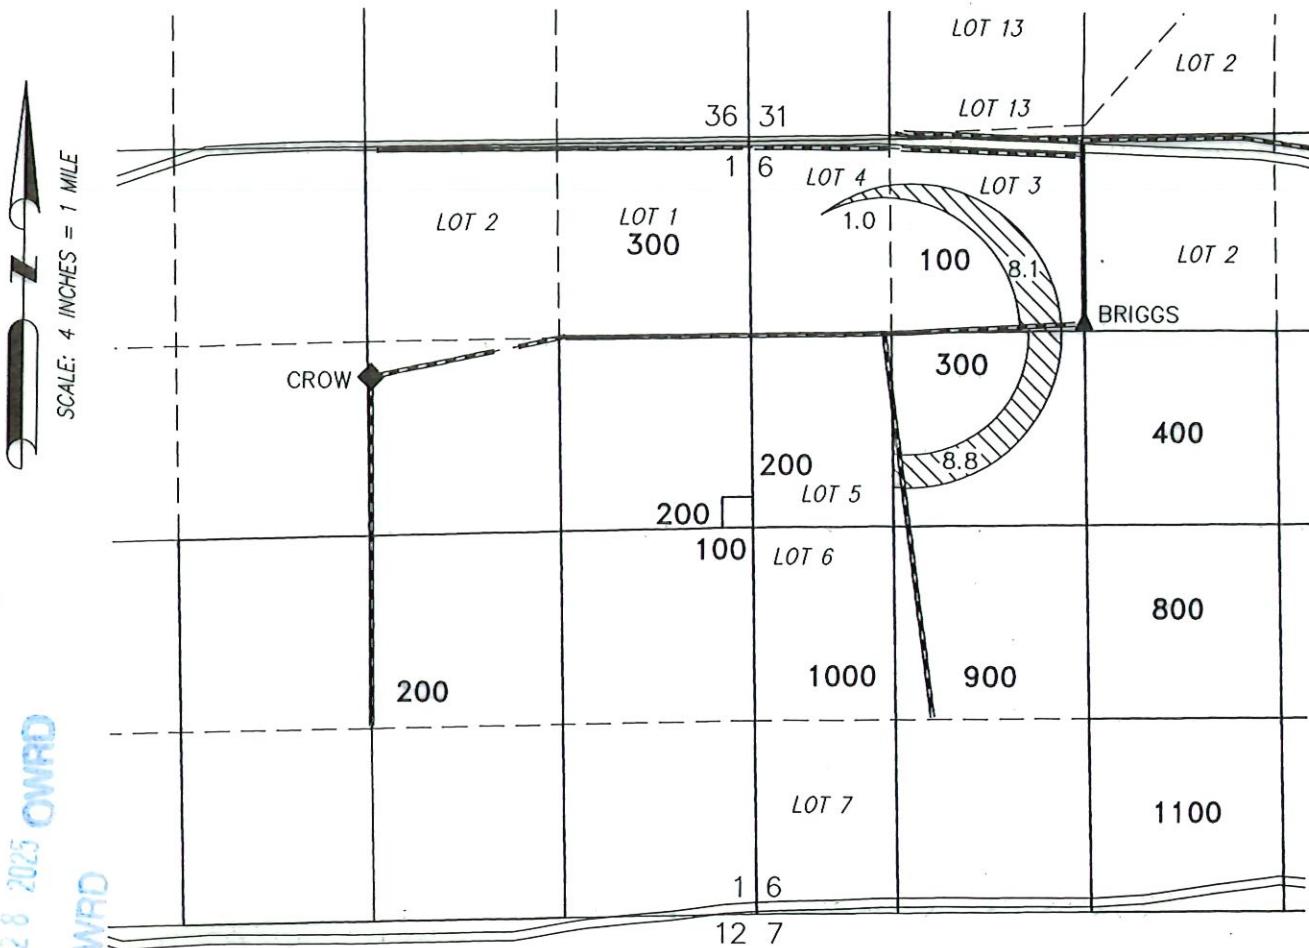

Received AUG 28 2025 OWRD  
OWRD

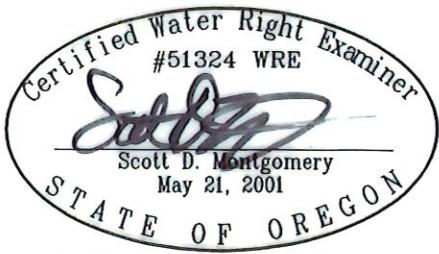

17.9 ACRES IR FROM BRIGGS 2 (G-4030), AS SHOWN.

THIS MAP IS FOR THE PURPOSE OF LOCATING A WATER RIGHT ONLY AND HAS NO  
INTENT TO PROVIDE LEGAL DIMENSIONS OR THE LOCATION OF PROPERTY LINES.

PREPARED FOR:

GOLDEN RULE FARMS, INC.  
P.O. BOX 255  
CHRISTMAS VALLEY, OR 97641

PREPARED BY:



ALL POINTS ENGINEERING AND SURVEYING, INC.  
P.O. BOX 767  
(541) 548-5833  
TERREBONNE, OR 97760  
www.APEandS.com