
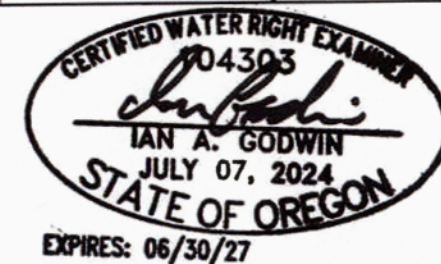


T2S, R33E, Sections 17-18
App. G-12832 / Permit G-12242

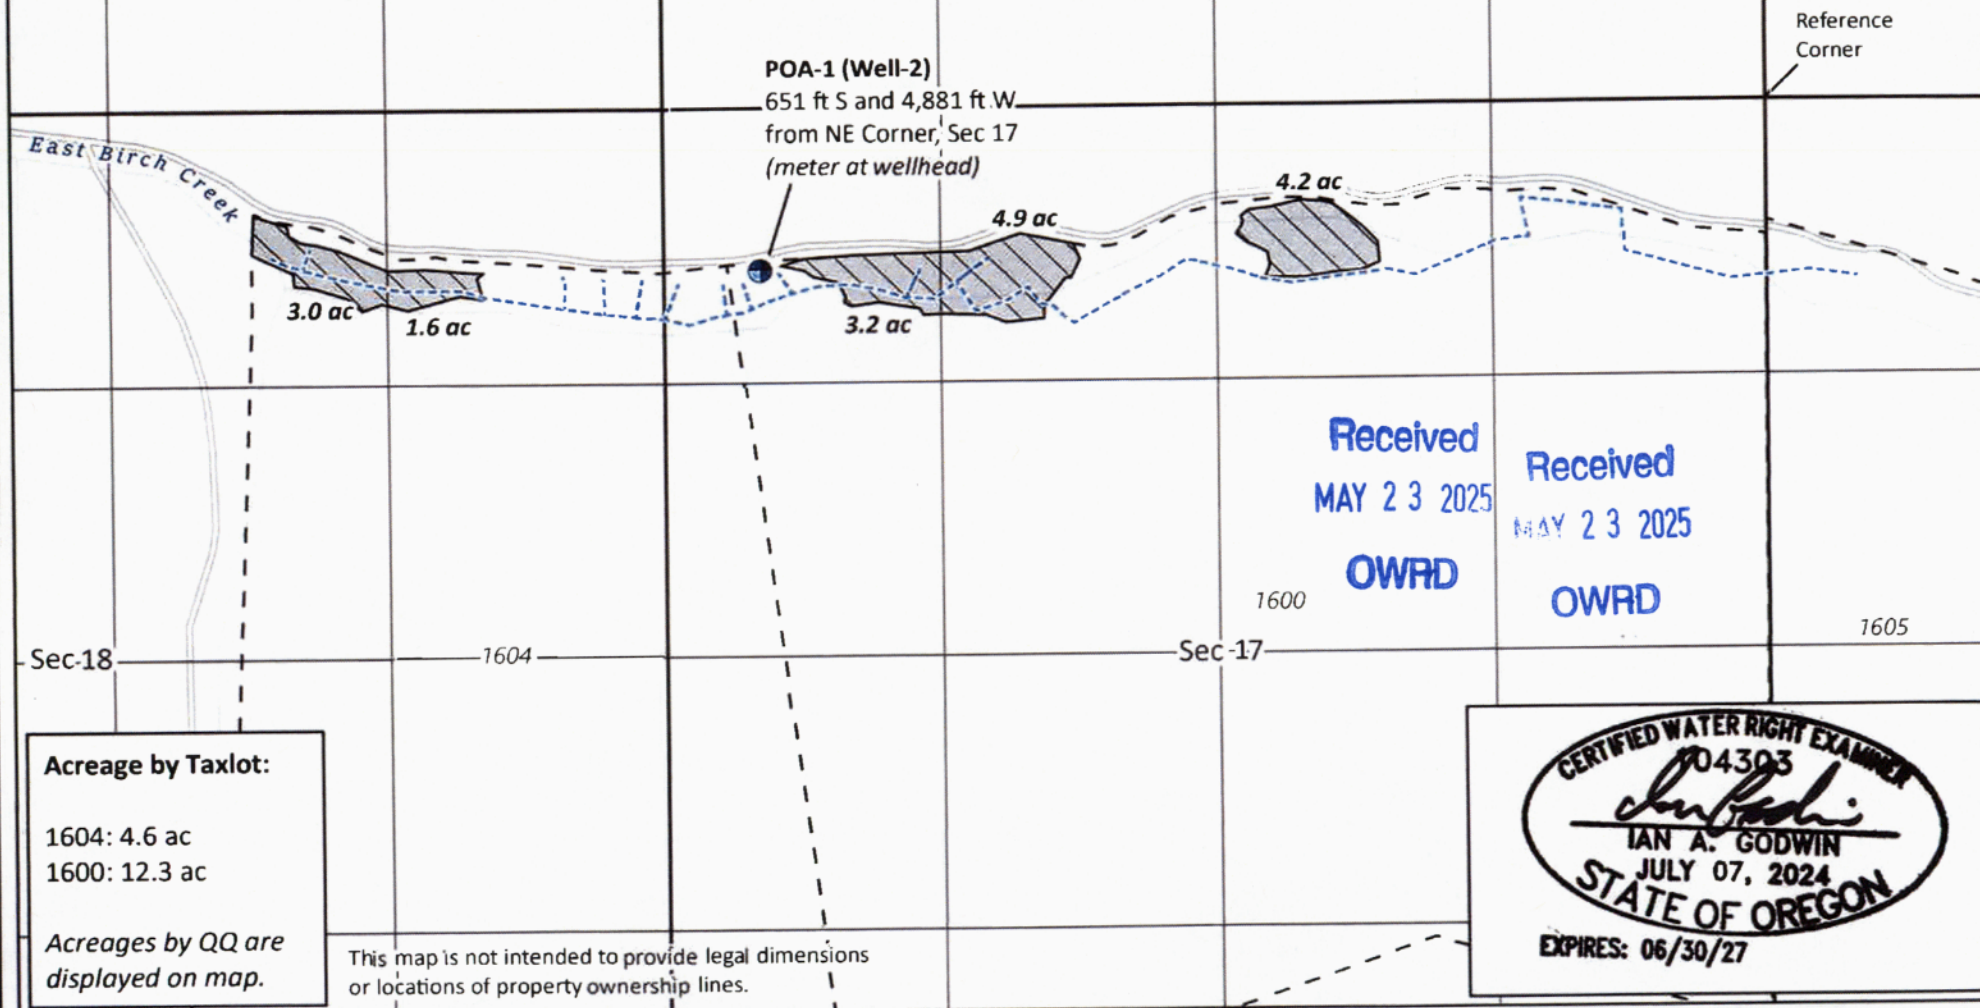


CWM-H2O 
Complete Water Management

311 B Avenue, Suite P
Lake Oswego, Oregon 97034
(503) 954-1326

Figure 1
Amended Claim of Beneficial Use Map
for Permit G-12242

1	DATE	AUTH	DRAFT
No.	Date	By	Revisions

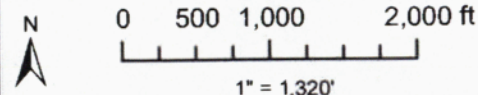

Proj#: 2413001
Miller Valley
Mike Miller
3330 Hayden Bridge Road
Springfield, OR 97477

-  G-12242 POA (Well-2)
-  Amended G-12242 POU
-  Taxlots
-  Approx Distribution Lines