


T.7S. R.1W. Sec. 6 & 7, W.M.

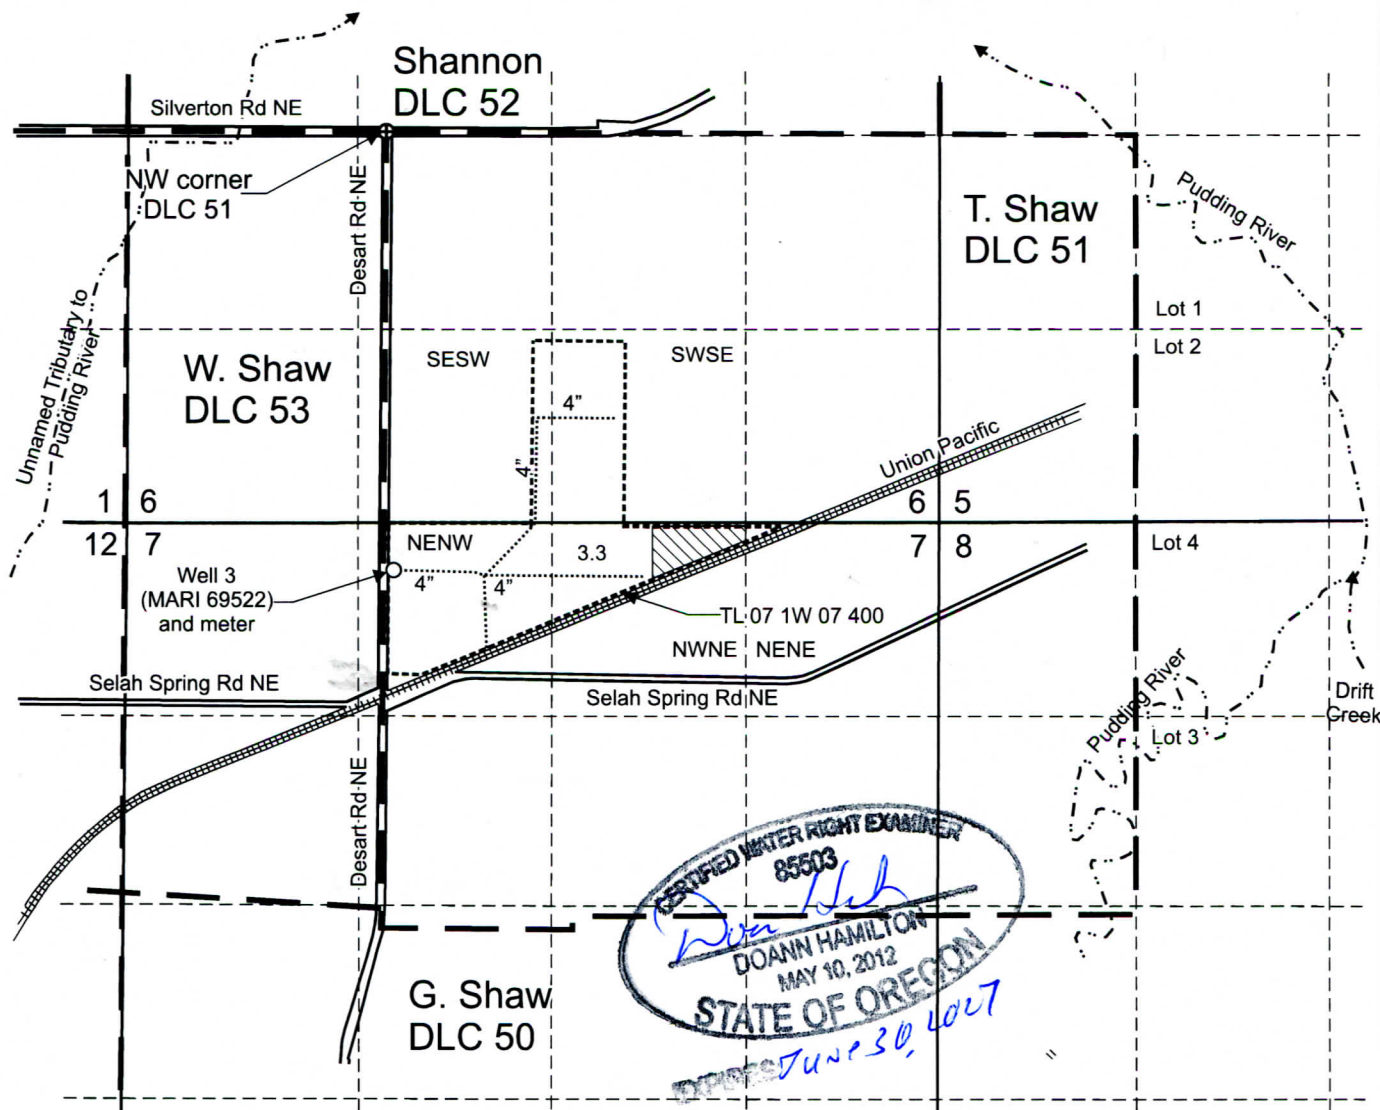

Well 3 (MARI 69522) is located 3,010 feet south and 45 feet east from the NW corner, DLC 51.

 Area (3.3 Acres) irrigated under Application G-18884, Permit G-18509.

----- Tax lot boundary

— . — Donation Land Claim boundary

..... Water main line

Scale: 1" = 1,320'



This map was prepared for the purpose of identifying the location of a water right only and is not intended to provide legal dimensions or location of property ownership lines.

Claim of Beneficial Use Map
Application G-18884, Permit G-18509

Myron and Diane Kuenzi Family Farm LLC
T.7S. R.1W. Sec. 6 & 7, W.M.

Pacific Hydro-Geology Inc.

12/2024
Rev. 11/2025