

T.2S. R.3E. Section 13, W.M.

11 12
14 13

SE:Rebman.Rd.



Margaret Reservoir

POD Meter

NENW

TL 2 3E 13 300

20.9

POD and meter

Townsend Reservoir

11.1

SE Amisgiger Rd

SE Pawprint Ln

Received by OWRD
JUN 02 2025
Salem, OR

SENW

Margaret POD is located 500 feet south and 1,545 feet east from the NW corner, Section 13.


Townsend POD is located 1,400 feet south and 1,540 feet east from the NW corner, Section 13.

Area (32.0 Acres) irrigated under Application S-88057, Permit S-54946.

----- Tax lot boundary

..... Water main line

Scale: 1" = 400'

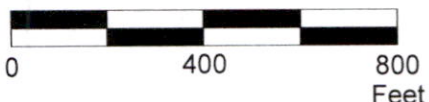

This map was prepared for the purpose of identifying the location of a water right only and is not intended to provide legal dimensions or location of property ownership lines.

Claim of Beneficial Use Map
Application S-88057, Permit S-54946

Michael Townsend
T.2S. R.3E. Section 13, W.M.

Pacific Hydro-Geology Inc.

05/2025

TownsendTowerS-88057COBUMap.cdr