


Claim of Beneficial Use

Permit G-17564, Application G-17995

A Water Right held by Stallion Land Company, LLC
Jackson County

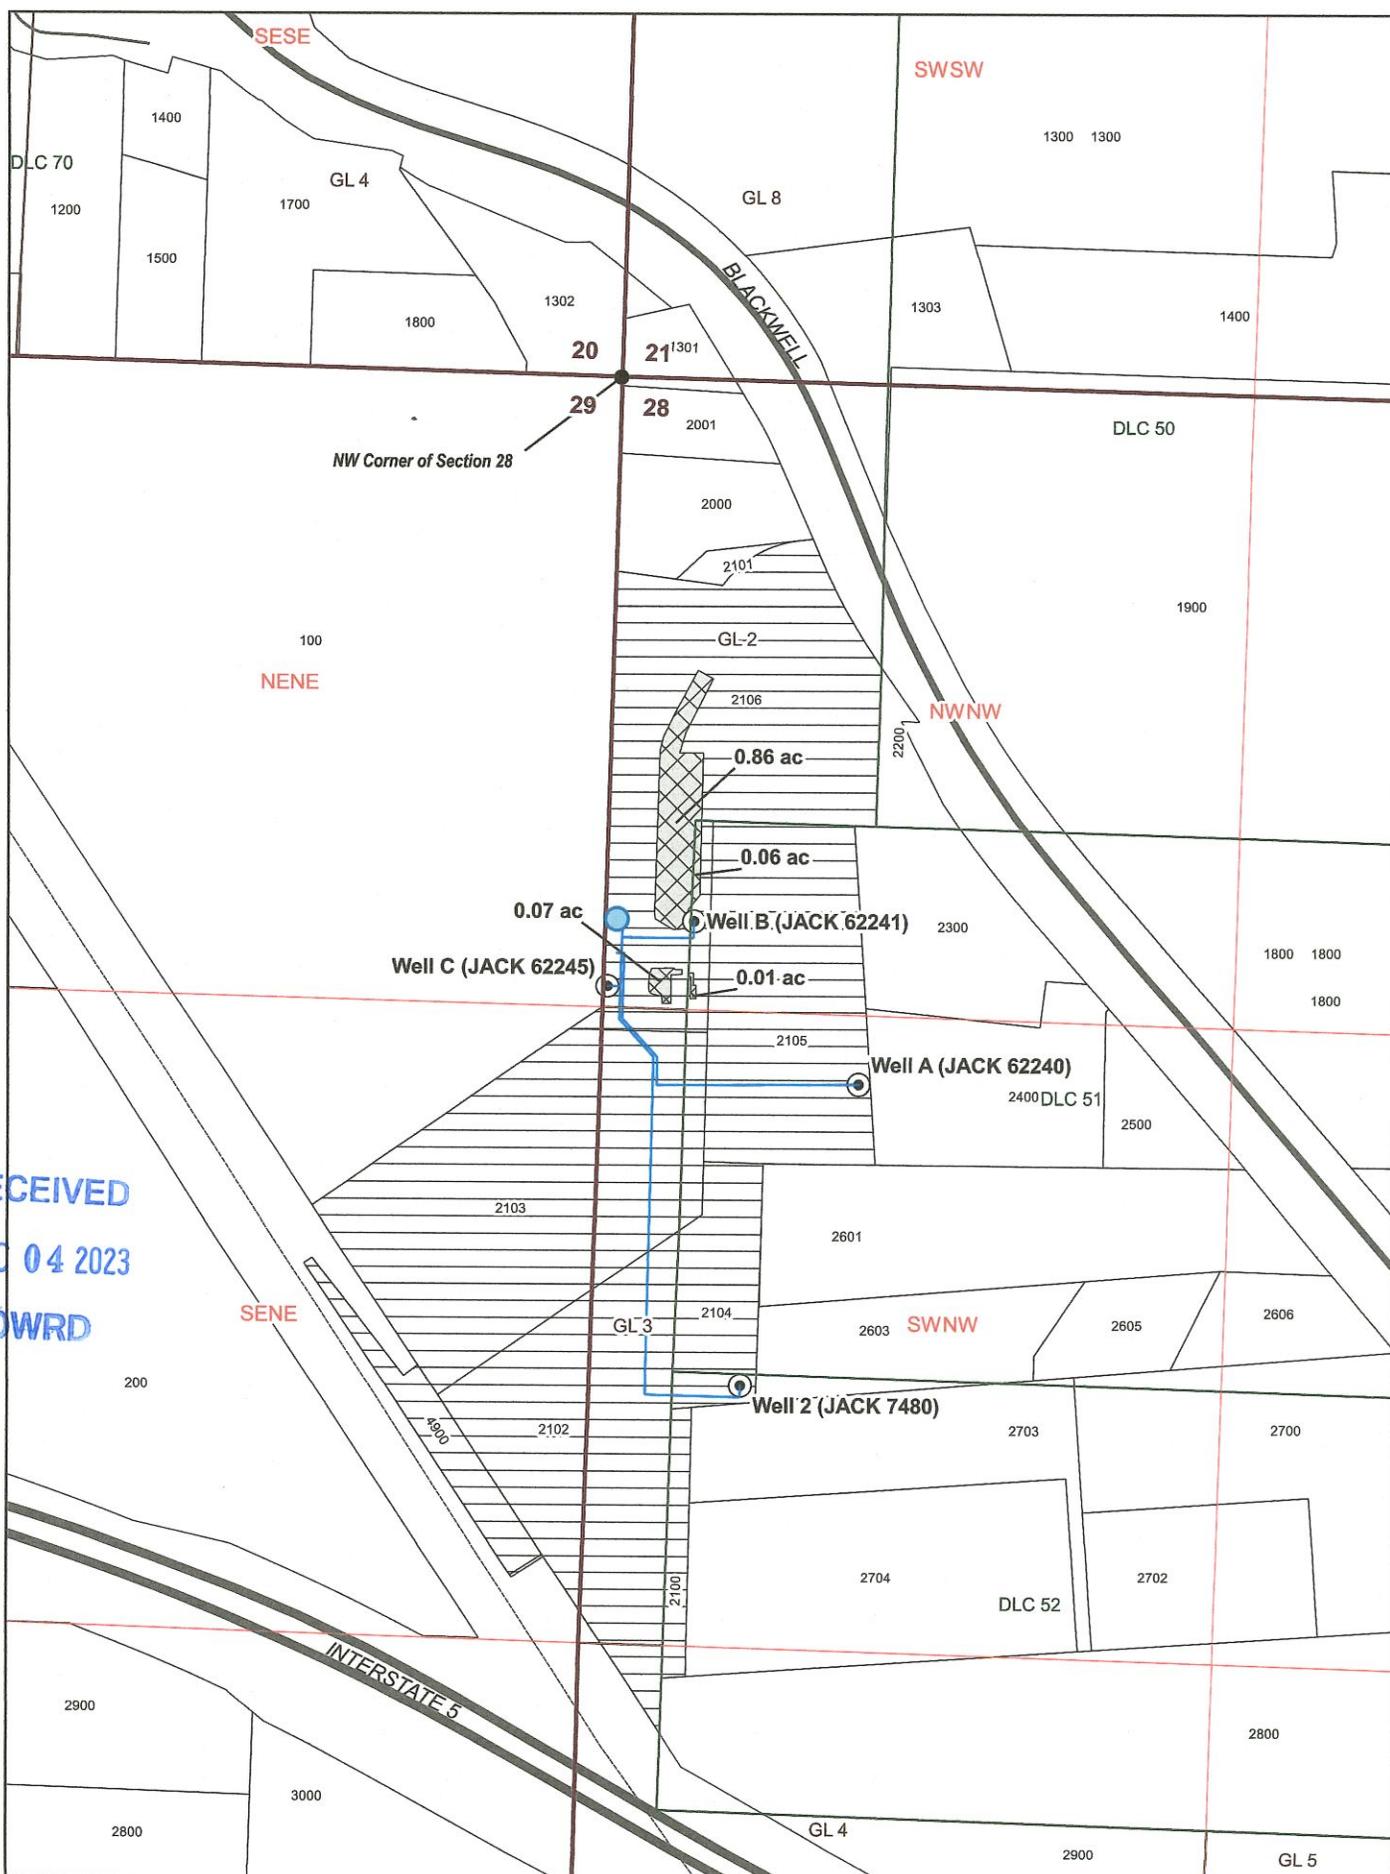

RECEIVED
DEC 04 2023
OWRD

LEGEND

- Point of Appropriation (POA)
- Place of Use (POU)
- Storage Tank
- Property Lines
- Streams
- Conveyance Mains
- Roadway
- Railroad


POA Location Description

Well A (JACK 62240)
Located 1,475 feet South and 550 feet East from NW corner of Section 28, Township 36 South, Range 2 West, W.M.


Well B (JACK 62241)
Located 1,150 feet South and 200 feet East from NW corner of Section 28, Township 36 South, Range 2 West, W.M.

Well C (JACK 62245)
Located 1,270 feet South and 10 feet East from NW corner of Section 28, Township 36 South, Range 2 West, W.M.

Well 2 (JACK 7480)
Located 2,110 feet South and 315 feet East from NW corner of Section 28, Township 36 South, Range 2 West, W.M.

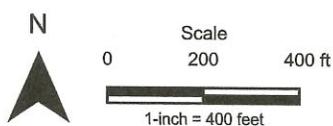

Date: 11/9/2023
Data Sources: BLM, OWRD, ODFW, USGS, Jackson County.
Disclaimer: This map is not intended to provide legal dimensions or property ownership lines.

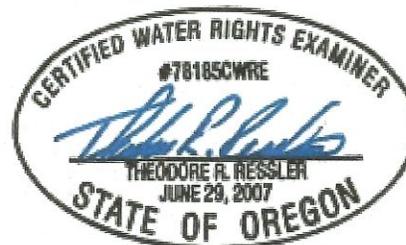

RENEWS: 12-31-2024

CWRE Seal and Signature

