

34/35


T38S R5W

# T39S R5W, WM, JOSEPHINE COUNTY, OR

3 2

TL 204

T39S R5W

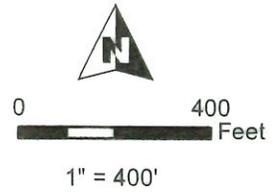

TL 301

NWNW

NENW

TL 300

Vencill Ln

● Well & Meter

▨ POU NU

TL 202

5.0 AC

TL 203

— Township

— Section

- - - Quarter Quarter

□ Tax Lot

Browns Rd

TL 401


TL 400

TL 400

Well (JOSE 59246/L-113752)  
 Location:  
 S 1,290', E 850'  
 of NW Cor Sec 2

SENW

SENW

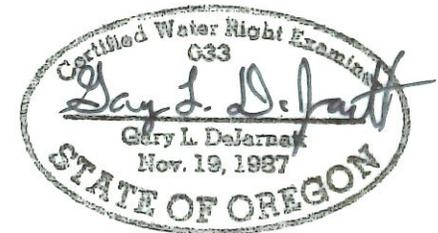

RENEWAL DATE 12/31/2023

RECEIVED  
 MAY 19 2023



## CLAIM OF BENEFICIAL USE MAP Yoram & Jai B Levy

This map is not intended  
 to provide legal dimensions  
 or locations of property  
 ownership lines.

**WATER RIGHT SERVICES, LLC**  
 PO BOX 1830, BEND, OR 97709  
 WWW.OREGONWATER.US CCB # 197121  
 johnshort@usa.com 541-389-2837

Date: 3/21/2023

Ap G-18774

Permit G-18558

Project #22052