


CLAIM OF BENEFICIAL USE MAP

TO CHANGE PLACE OF USE AND POINTS OF APPROPRIATION
FOR APPLICATION T-13122
CHURCH FAMILY FARMS, INC.

RECEIVED
SEP 18 2012
OKRO

TOWNSHIP 28 SOUTH, RANGE 16 EAST, SECTION 21, W.M.
TAX LOT 100

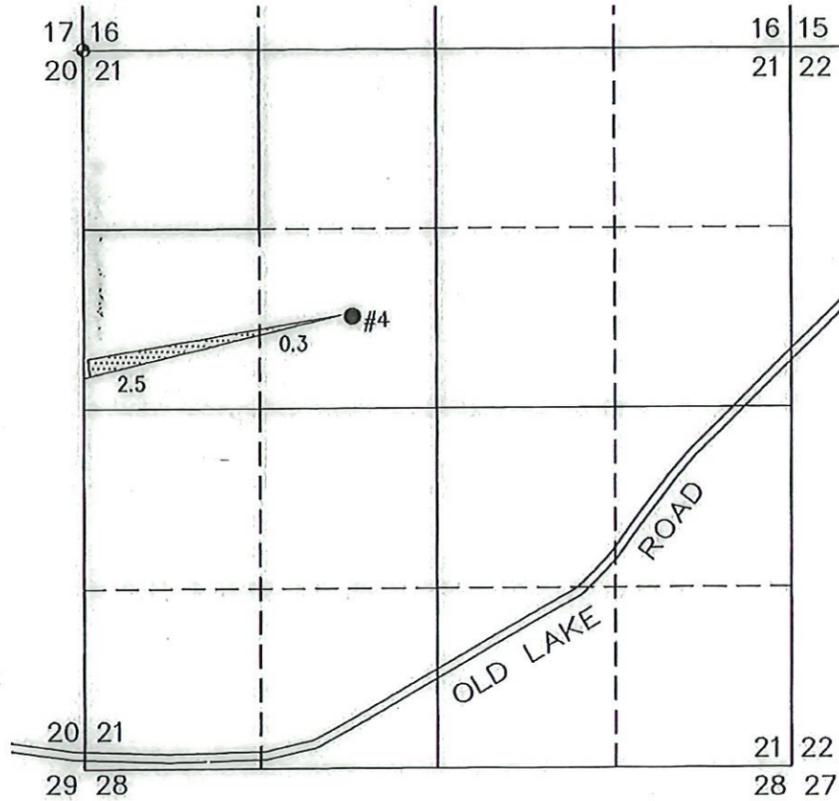


● #4 LAKE 1411
EXISTING WELL IN THE SE 1/4 NW 1/4 SECTION 21,
T28S R16E, W.M. LOCATED 1990 FEET SOUTH AND
3280 FEET WEST FROM THE NE CORNER OF SECTION
21.

NEWLY INSTALLED METER IS LOCATED ON CENTER
PIVOT SPRINKLER.

2.8 ACRES WATER RIGHTS
FROM CERTIFICATE #95680
(G-8199), AS SHOWN.



TOWNSHIP 27 SOUTH, RANGE 16 EAST, SECTION 25, W.M.
TAX LOTS 900, 1400, 2100, 2800, 3000, & 3100

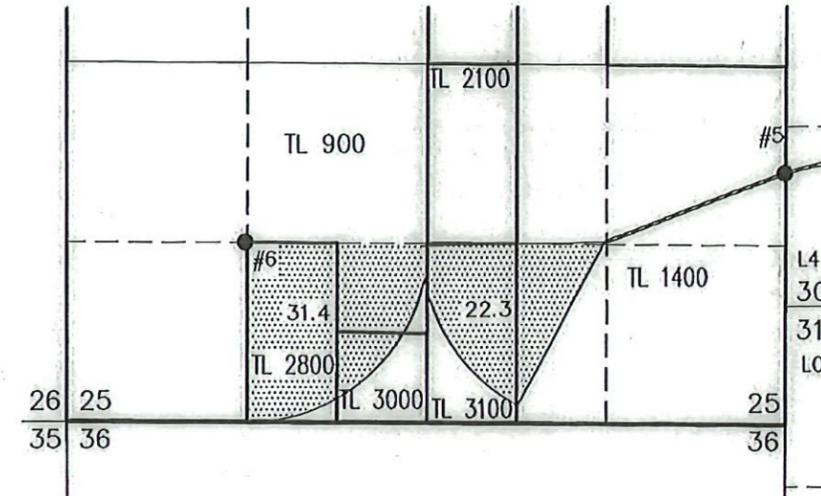

● #6 (LAKE 50469-G8100).
EXISTING WELL IN THE SW 1/4 SW 1/4 SECTION
25, T27S R16E, W.M. LOCATED 1315 FEET
NORTH AND 1315 FEET EAST FROM THE SW
CORNER OF SECTION 25.

NEWLY INSTALLED METER IS LOCATED ON CENTER
PIVOT SPRINKLER.

53.7 ACRES WATER RIGHTS FROM
CERTIFICATE #95680 (G-8199), AS SHOWN.



RENEWAL DATE: 12/31/2022

THIS MAP IS FOR THE PURPOSE OF LOCATING A
WATER RIGHT ONLY AND HAS NO INTENT TO
PROVIDE LEGAL DIMENSIONS OR THE LOCATION OF
PROPERTY LINES

<p>PREPARED FOR:</p> <p>CHURCH FAMILY FARMS, INC. P.O. BOX 751 CHRISTMAS VALLEY, OR 97641</p>	<p>PREPARED BY:</p> <p> ALL POINTS ENGINEERING AND SURVEYING, INC. P.O. BOX 767 TERREBONNE, OR 97760 (541) 548-5833 www.APEandS.com</p>
---	--