

CLAIM OF BENEFICIAL USE MAP

TO CHANGE PLACE OF USE AND
POINTS OF APPROPRIATION
FOR T-13122
CHURCH FAMILY FARMS, INC.

TOWNSHIP 26 SOUTH, RANGE 18 EAST, SECTION 31, W.M.
TAX LOT 200


RECEIVED


SEP 13 2022


RECEIVED

SEP 13 2022

OWRD

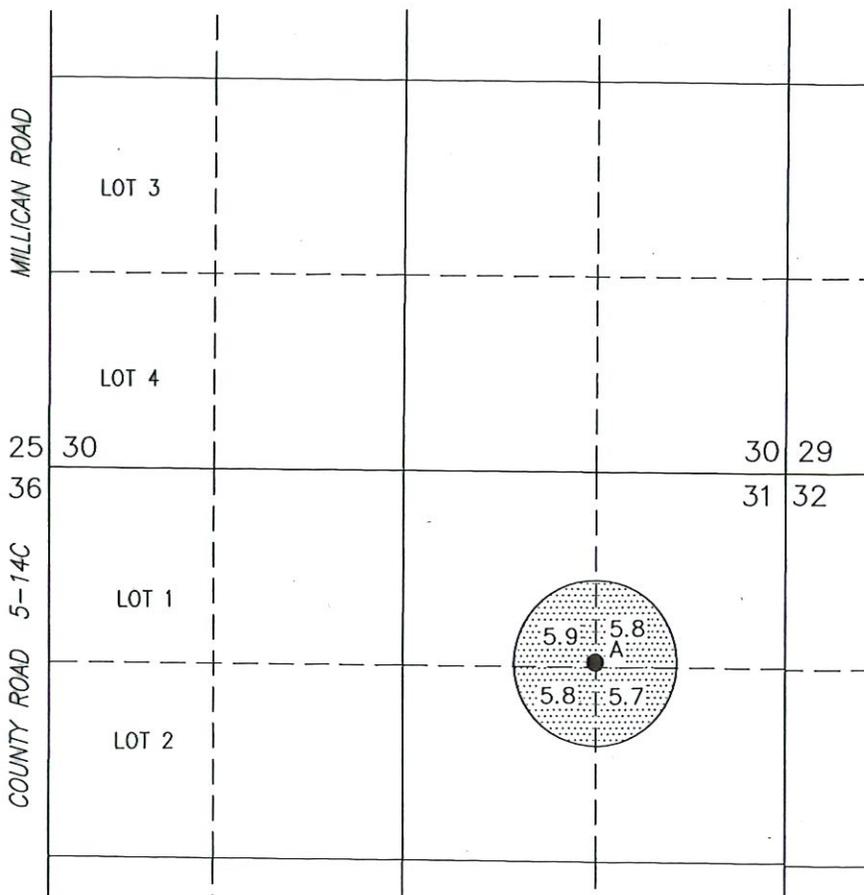

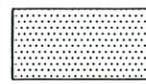 23.2 ACRES WATER RIGHTS FROM CERTIFICATE #67903 (G-8432), AS SHOWN.

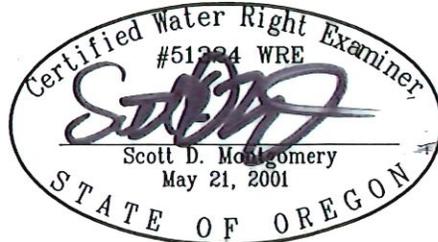

RENEWAL DATE: 12/31/2022

- A LAKE 687
EXISTING WELL IN THE NE 1/4 NE 1/4 SECTION 31, T26S R18E, W.M. LOCATED 1410 FEET NORTH AND 1320 FEET EAST FROM THE CENTER 1/4 CORNER OF SECTION 31.

NEWLY INSTALLED METER IS LOCATED ON CENTER PIVOT SPRINKLER.

THIS MAP IS FOR THE PURPOSE OF LOCATING A WATER RIGHT ONLY AND HAS NO INTENT TO PROVIDE LEGAL DIMENSIONS OR THE LOCATION OF PROPERTY LINES

<p>PREPARED FOR:</p> <p>CHURCH FAMILY FARMS, INC. P.O. BOX 751 CHRISTMAS VALLEY, OR 97641</p>	<p>PREPARED BY:</p>  <p>ALL POINTS ENGINEERING AND SURVEYING, INC. P.O. BOX 767 (541) 548-5833</p> <p>TERREBONNE, OR 97760 www.APEandS.com</p>
---	---