


CLAIM OF BENEFICIAL USE MAP


TO CHANGE PLACE OF USE AND
POINTS OF APPROPRIATION
FOR T-13122
CHURCH FAMILY FARMS, INC.

TOWNSHIP 26 SOUTH, RANGE 18 EAST, SECTION 31, W.M.
TAX LOT 200

RECEIVED
SEP 13 2022
OWRD

RECEIVED
SEP 13 2022
OWRD

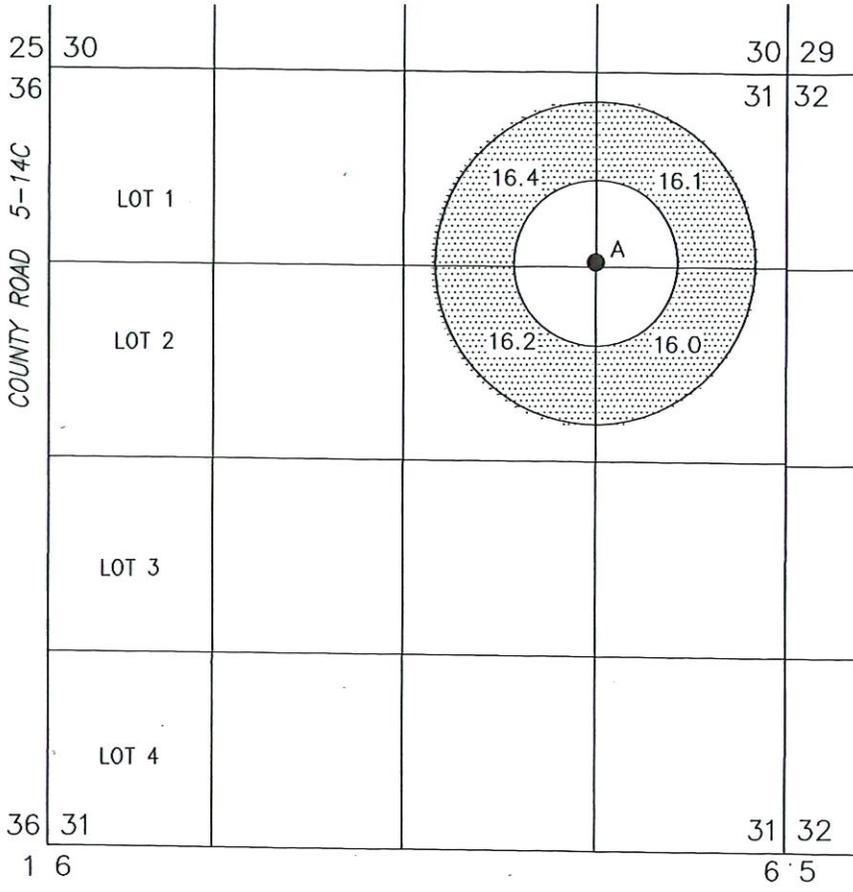

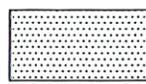 64.7 ACRES WATER RIGHTS
FROM CERTIFICATE #76942
(G-9018), AS SHOWN.



RENEWAL DATE: 12/31/2022

- A LAKE 687
EXISTING WELL IN THE NE 1/4 NE 1/4 SECTION 31,
T26S R18E, W.M. LOCATED 1410 FEET NORTH AND
1320 FEET EAST FROM THE CENTER 1/4 CORNER OF
SECTION 31.

NEWLY INSTALLED METER IS LOCATED ON CENTER
PIVOT SPRINKLER.

THIS MAP IS FOR THE PURPOSE OF LOCATING A
WATER RIGHT ONLY AND HAS NO INTENT TO
PROVIDE LEGAL DIMENSIONS OR THE LOCATION OF
PROPERTY LINES

<p>PREPARED FOR:</p> <p>CHURCH FAMILY FARMS, INC. P.O. BOX 751 CHRISTMAS VALLEY, OR 97641</p>	<p>PREPARED BY:</p>  <p>ALL POINTS ENGINEERING AND SURVEYING, INC. P.O. BOX 767 (541) 548-5833 www.APEandS.com</p> <p>TERREBONNE, OR 97760</p>
---	---