

CLAIM OF BENEFICIAL USE MAP


TO CHANGE PLACE OF USE AND POINTS OF APPROPRIATION
FOR APPLICATION T-13122
CHURCH FAMILY FARMS, INC.

RECEIVED

SEP 13 2022

CWRD

SECTION 31, TOWNSHIP 26 SOUTH, RANGE 18 EAST, W.M.
TAX LOT 200

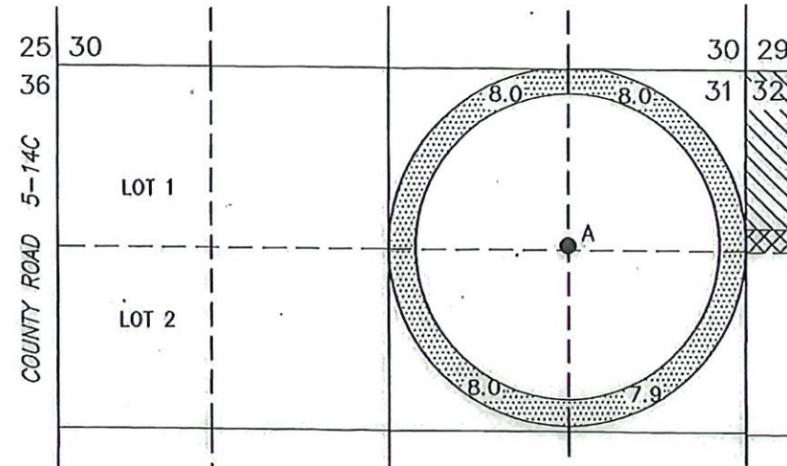


● **A (LAKE 687)**
EXISTING WELL IN THE NE 1/4 NE 1/4
SECTION 31, T26S R18E, W.M. LOCATED 1410
FEET NORTH AND 1320 FEET EAST FROM THE
C 1/4 CORNER OF SECTION 31.

NEWLY INSTALLED METER IS LOCATED ON CENTER
PIVOT SPRINKLER.

31.9 ACRES WATER RIGHTS FROM
CERTIFICATE #86164 (G-10718),
AS SHOWN.

TOWNSHIP 28 SOUTH, RANGE 16 EAST, SECTION 1, W.M.
TAX LOTS 100, 200, & 300

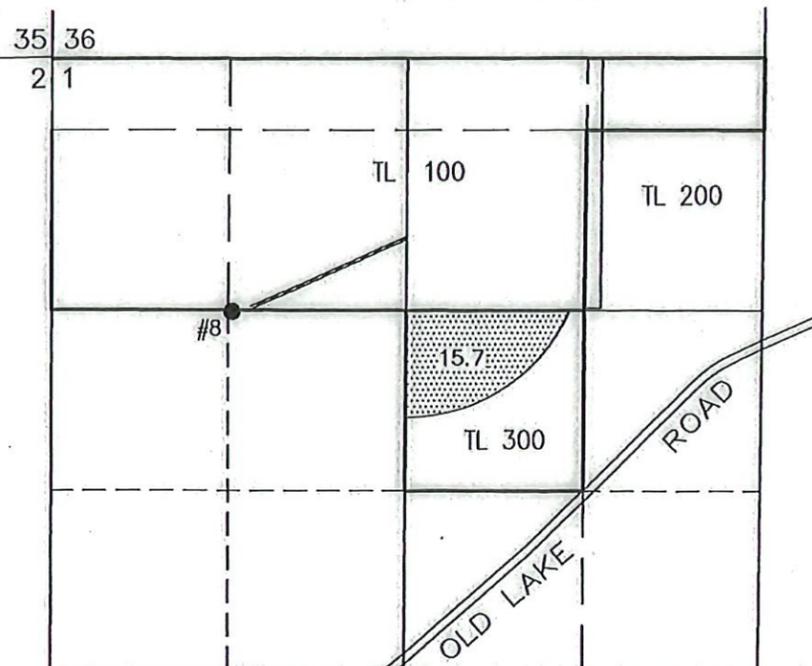


15.7 ACRES WATER RIGHTS FROM
CERTIFICATE #86164 (G-10718), AS SHOWN.

● **#8 (LAKE 1369-G10718)**
EXISTING WELL IN THE SE 1/4 NW 1/4 SECTION
1, T28S R16E, W.M. LOCATED 1850 FEET
SOUTH AND 1340 FEET EAST FROM THE NW
CORNER OF SECTION 1.

NEWLY INSTALLED METER IS APPROXIMATELY 2.0 FEET
NORTH ALONG DELIVERY PIPE FROM CENTER PIVOT.

SECTION 30, TOWNSHIP 27 SOUTH,
RANGE 17 EAST, W.M.
TAX LOT 1900

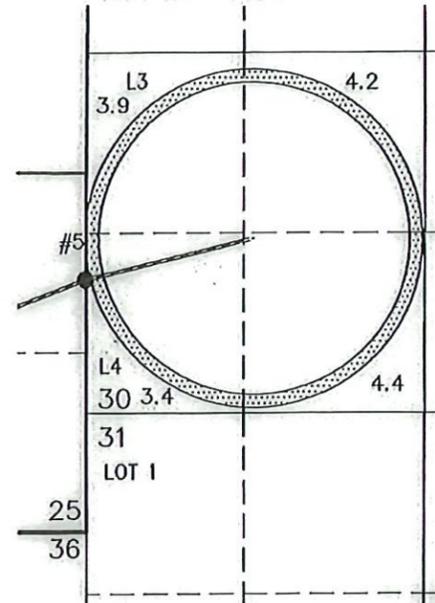

31.6 ACRES WATER RIGHTS FROM
CERTIFICATE #86164 (G-10718), AS SHOWN.

● **#5 (LAKE 51631-G8100)**
EXISTING WELL IN THE NE 1/4 SE 1/4 SECTION
25, T27S R16E, W.M. LOCATED 800 FEET
SOUTH AND 10 FEET WEST FROM THE E 1/4
CORNER OF SECTION 25.

NEWLY INSTALLED METER IS LOCATED ON CENTER
PIVOT SPRINKLER TO THE EAST.




RENEWAL DATE: 12/31/2022

THIS MAP IS FOR THE PURPOSE OF LOCATING A WATER
RIGHT ONLY AND HAS NO INTENT TO PROVIDE LEGAL
DIMENSIONS OR THE LOCATION OF PROPERTY LINES.



SECTION 21, TOWNSHIP 28 SOUTH, RANGE 16 EAST, W.M.
TAX LOT 100

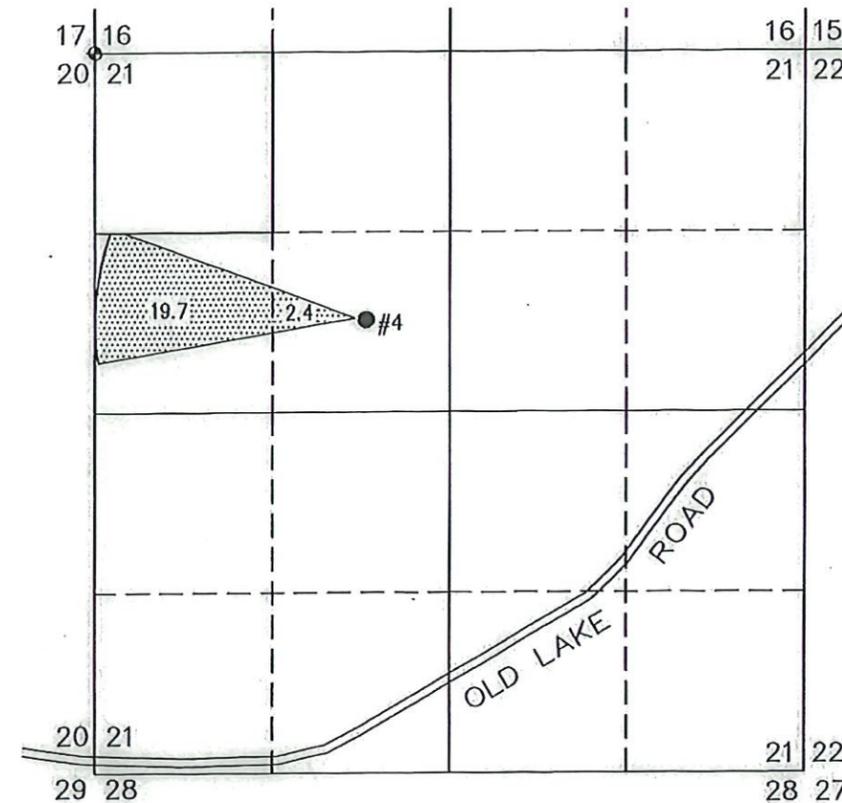

● **#4 (LAKE 1411-G8199)**
EXISTING WELL IN THE SE 1/4 NW 1/4 SECTION
21, T28S R16E, W.M. LOCATED 1990 FEET
SOUTH AND 3280 FEET WEST FROM THE NE
CORNER OF SECTION 21.

22.1 ACRES WATER RIGHTS FROM
CERTIFICATE #86164 (G-10718), AS SHOWN.

NEWLY INSTALLED METER IS LOCATED ON CENTER
PIVOT SPRINKLER.

PREPARED FOR:

CHURCH FAMILY FARMS, INC.
P.O. BOX 751
CHRISTMAS VALLEY, OR 97641

PREPARED BY:



ALL POINTS ENGINEERING AND SURVEYING, INC.
P.O. BOX 767 TERREBONNE, OR 97760
(541) 548-5833 www.APEandS.com