

# CLAIM OF BENEFICIAL USE MAP



TO CHANGE PLACE OF USE AND  
POINTS OF APPROPRIATION  
FOR T-13122  
CHURCH FAMILY FARMS, INC.

TOWNSHIP 26 SOUTH, RANGE 18 EAST, SECTION 31, W.M.  
TAX LOT 200

RECEIVED

SEP 18 2021

OWRO

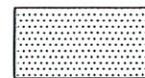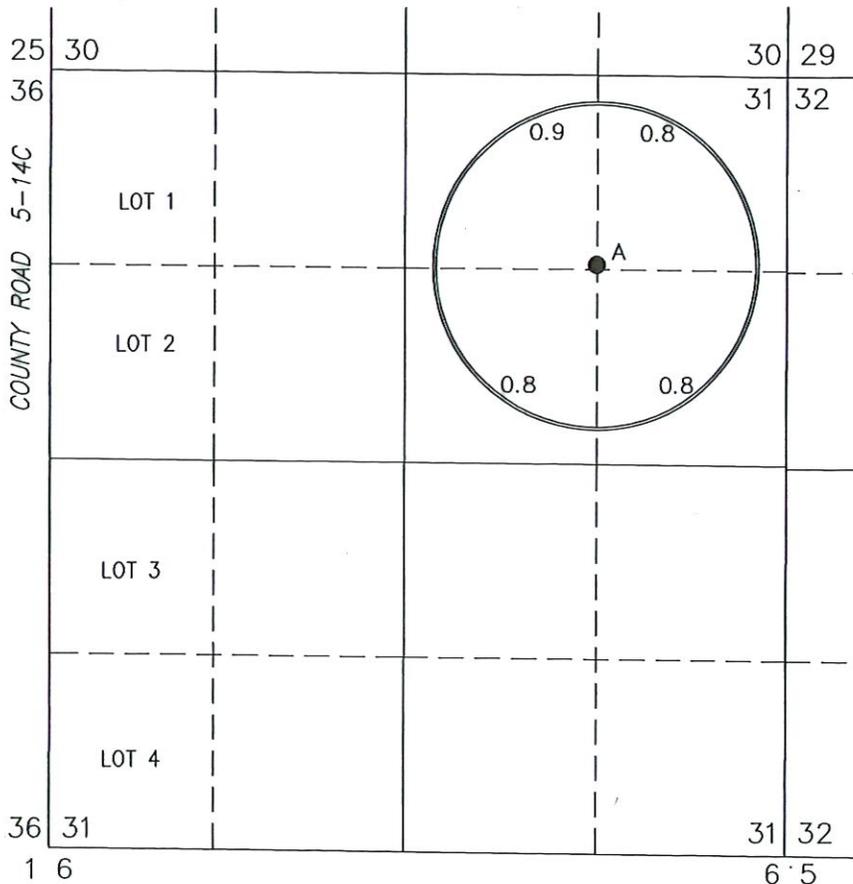

3.3 ACRES WATER RIGHTS  
FROM CERTIFICATE #88719  
(G-10043), AS SHOWN.



RENEWAL DATE: 12/31/2022

● A LAKE 687

EXISTING WELL IN THE NE 1/4 NE 1/4 SECTION 31,  
T26S R18E, W.M. LOCATED 1410 FEET NORTH AND  
1320 FEET EAST FROM THE CENTER 1/4 CORNER OF  
SECTION 31.

NEWLY INSTALLED METER IS LOCATED ON CENTER  
PIVOT SPRINKLER.

THIS MAP IS FOR THE PURPOSE OF LOCATING A  
WATER RIGHT ONLY AND HAS NO INTENT TO  
PROVIDE LEGAL DIMENSIONS OR THE LOCATION OF  
PROPERTY LINES

PREPARED FOR:

CHURCH FAMILY FARMS, INC.  
P.O. BOX 751  
CHRISTMAS VALLEY, OR 97641

PREPARED BY:



ALL POINTS ENGINEERING AND SURVEYING, INC.  
P.O. BOX 767  
(541) 548-5833  
TERREBONNE, OR 97760  
www.APEandS.com