

EXHIBIT

A

RECEIVED

MAP TO ACCOMPANY APPLICATION FOR
HYDROELECTRIC LICENSE

JUN 8 1981
WATER RESOURCES DEPT
SALEM, OREGON

DWANE WIGGINS

JUNE 1981


SECTION 28

TOWNSHIP 3 SOUTH

RANGE 45 EWM

1" = 1000'

N

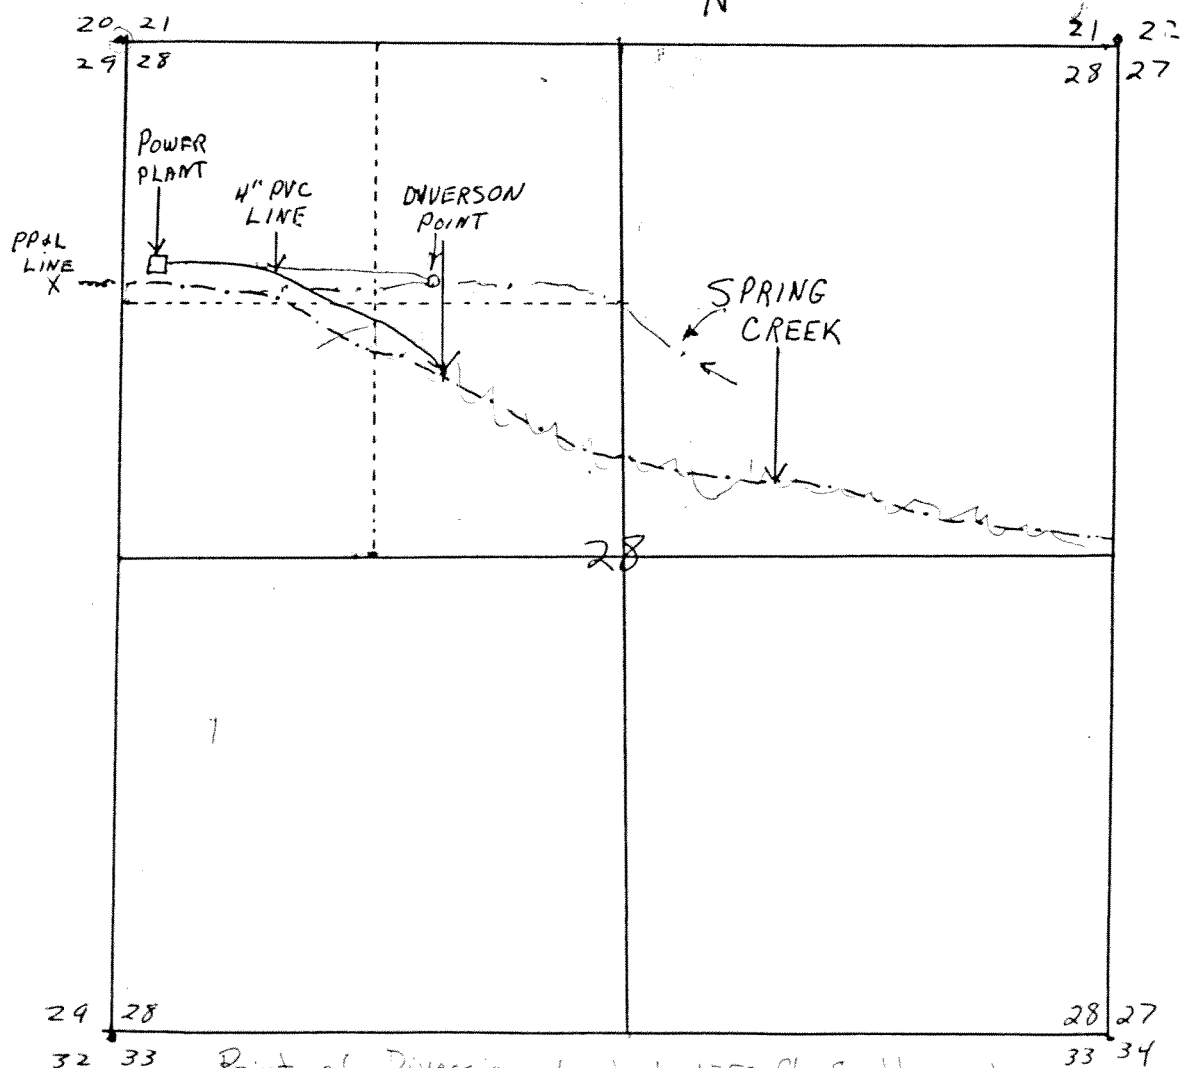

Point of Diversion located 1250 ft South and
1620 ft east of the NW corner of Section 28