
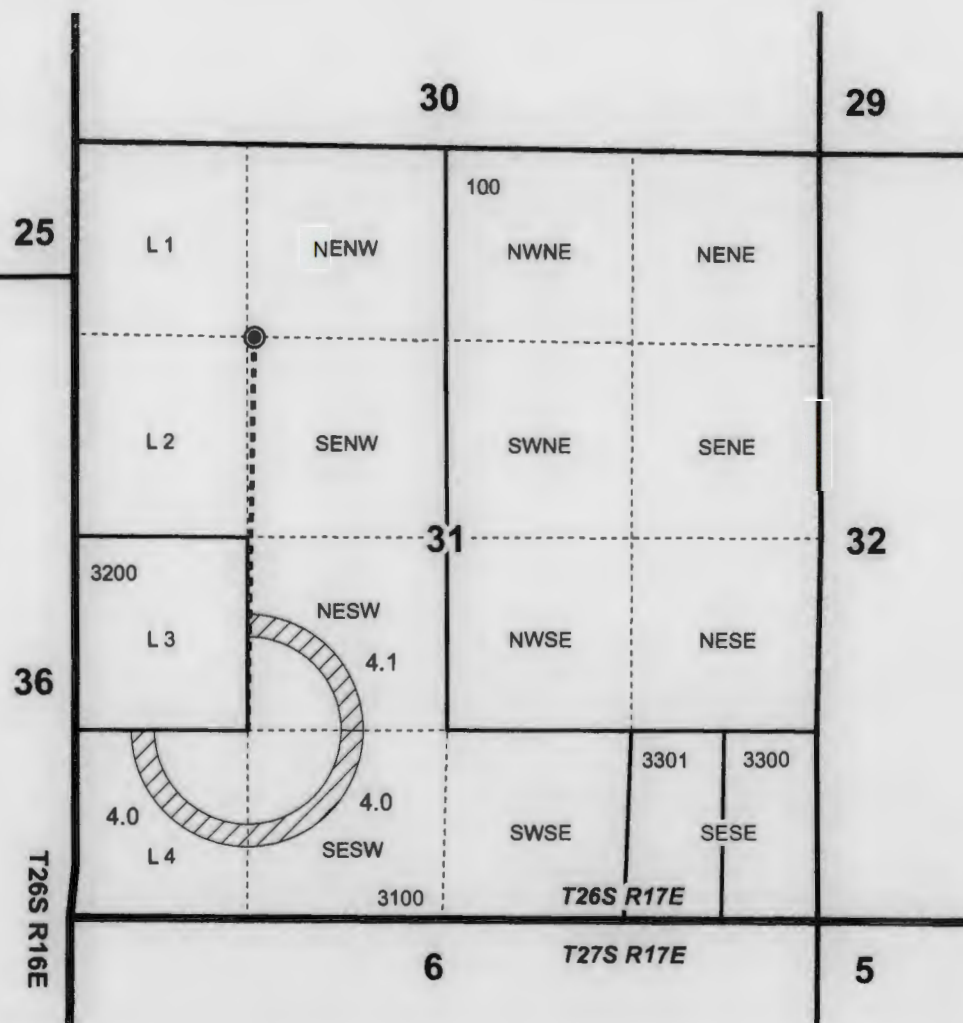



T26S R17E, WM, LAKE COUNTY, OR

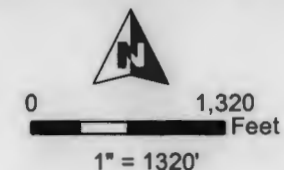

- Well & Meter
- Pipeline
- POU IR 12/22/1980 Priority
- Township
- Section
- Quarter Quarter
- Tax Lot

Well (LAKE 53393 / L-153423) Location:
1323' S, 1234' E
of the NW Cor of Sec 31

RECEIVED
JAN 08 2024
OWRD

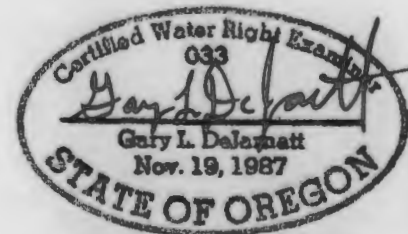

RENEWAL DATE 12/31/2023

CLAIM OF BENEFICIAL USE MAP McCord

Date: 11/20/2023

T-8883

Project #22010

This map is not intended
to provide legal dimensions
or locations of property
ownership lines.

WATER RIGHT SERVICES, LLC
PO BOX 1830, BEND, OR 97709
WWW.OREGONWATER.US 541-389-2837
johnshort@usa.com CCB # 197121