
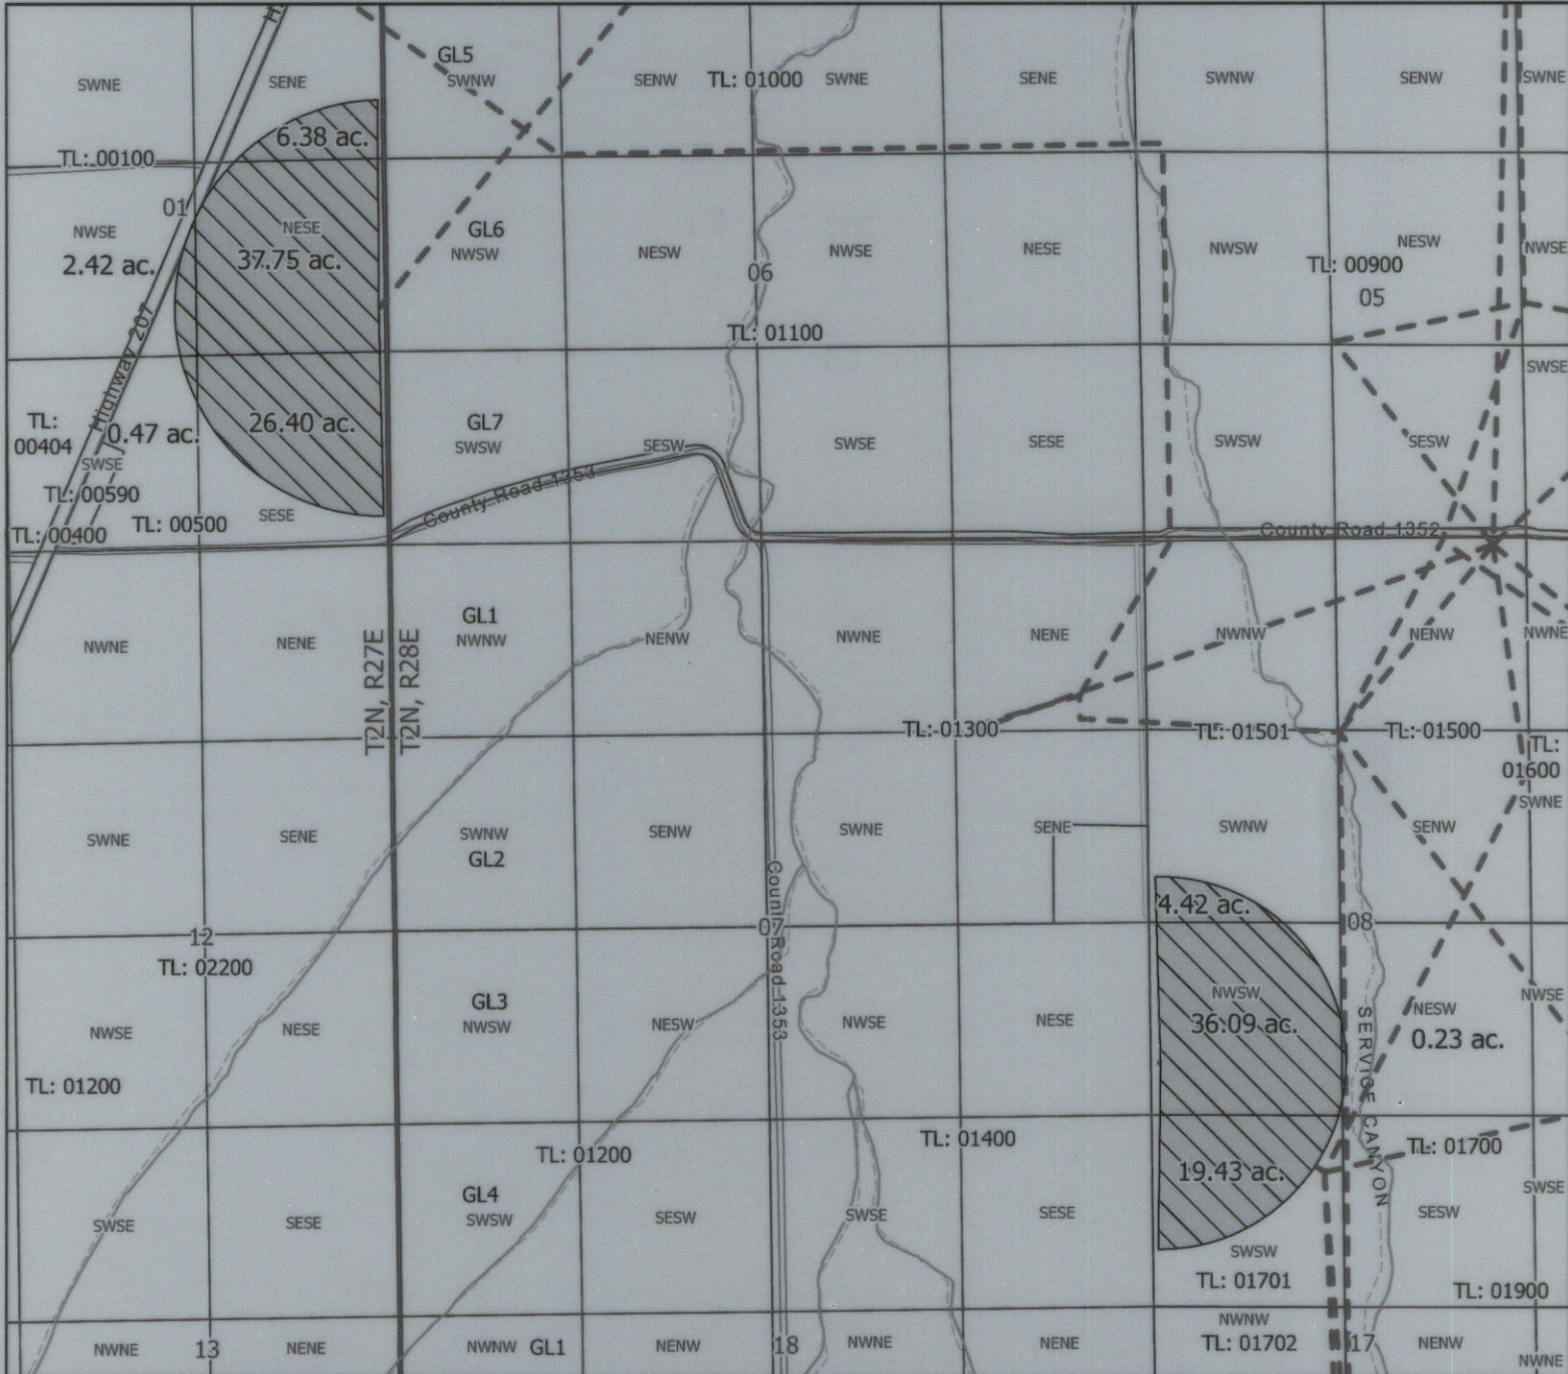



Claim of Beneficial Use - Place of Use Map Transfer T-13525 (former Certificate 92990)

A Water Right in the Name of Farmland Reserve, Inc.
Umatilla County
Township 2 North, Range 27 & 28 East (W.M.)

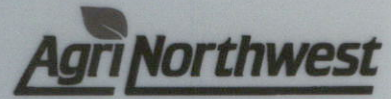

Legend

- Place of Use (133.59 acres)
- Pipeline
- Watercourse
- Tax Lot
- Government Lot (GL)

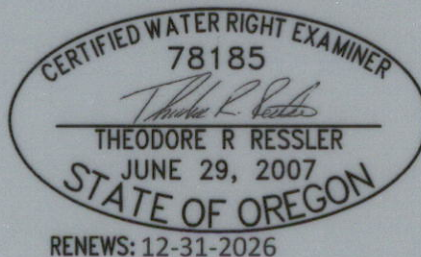

DISCLAIMER

This map was prepared for the purpose of identifying the location of a water right only and it is not intended to provide legal dimensions or location of property ownership lines.

MAP NOTES

Data Sources: BLM, ODFW, OGIC, ESRI, USGS, Umatilla Co.
Current as of: 11/7/2024

Received
APR 04 2025
OWRD





0 670 1,340 Feet
1" = 1,320 feet

Claim of Beneficial Use - Point of Diversion Map 1

Transfer T-13525 (former Cert.'s 92990, 92992, 92993, 92994, and 95622)

Water Rights in the Name of Farmland Reserve, Inc.
Morrow County
Township 4 North, Range 25 East (W.M.)

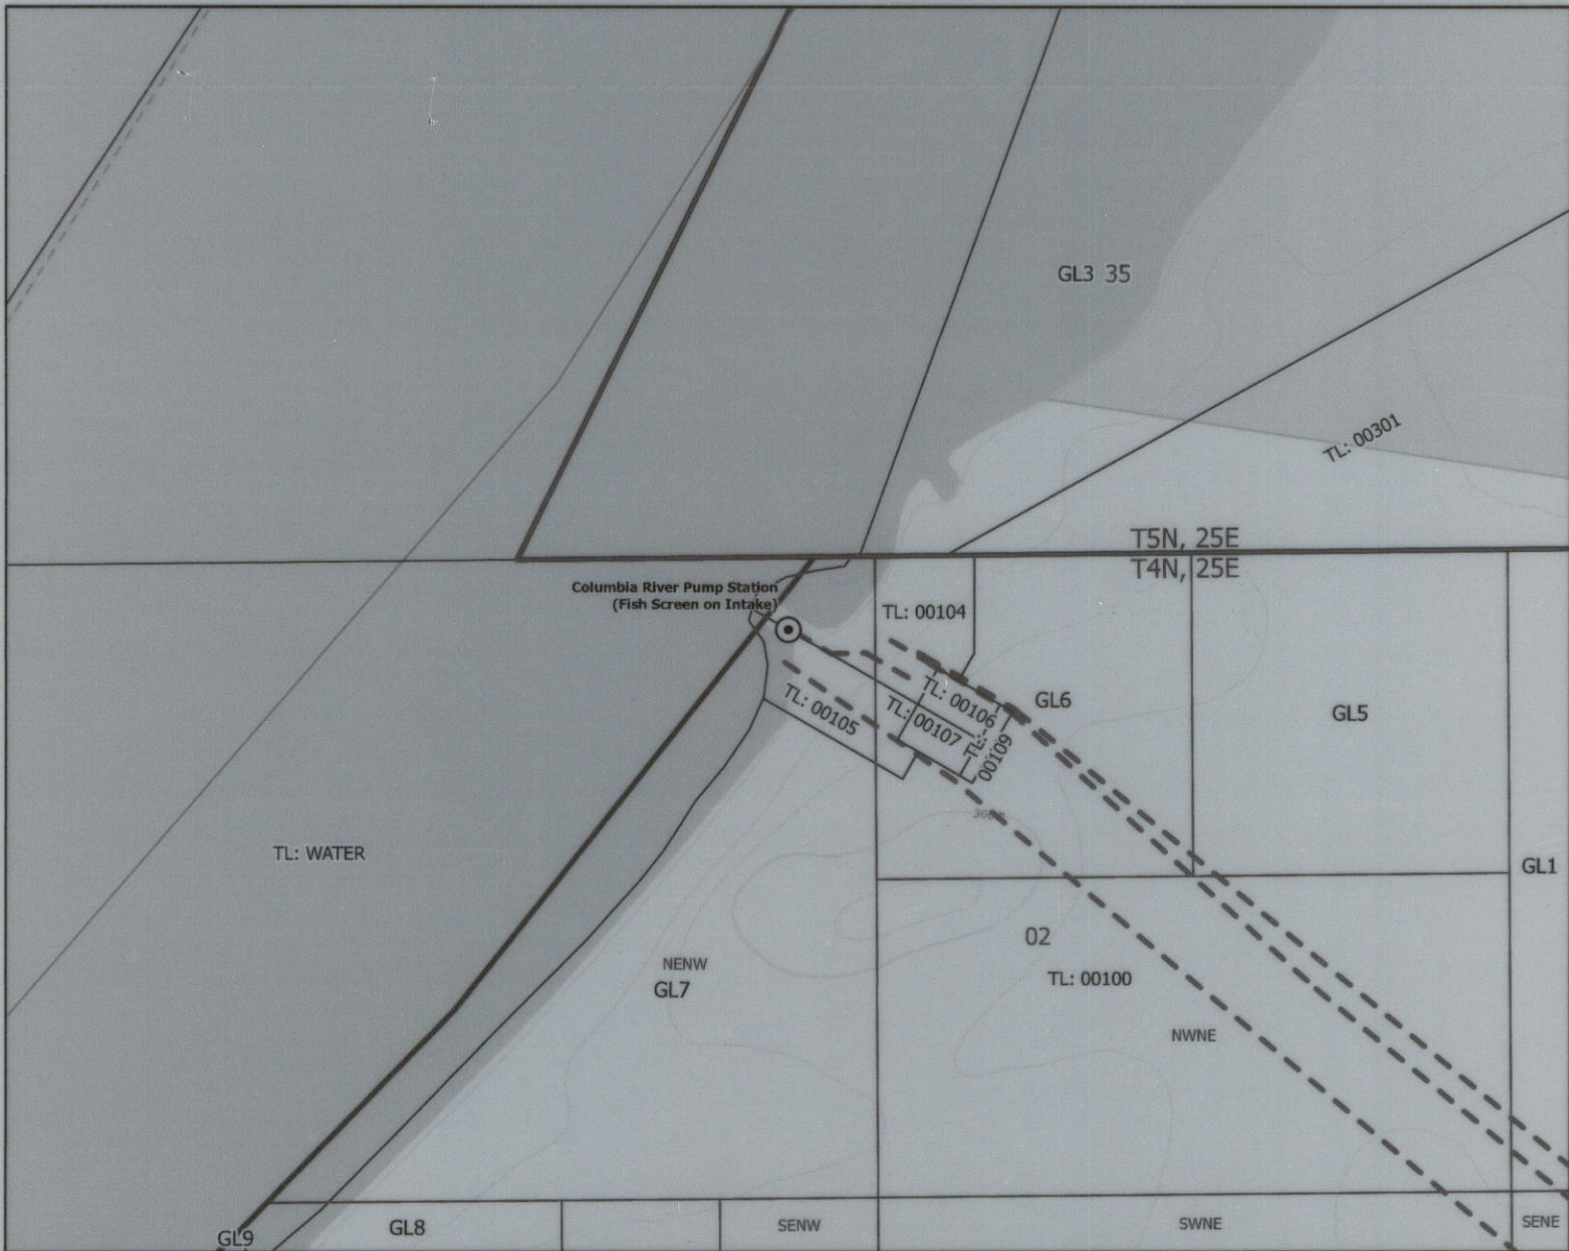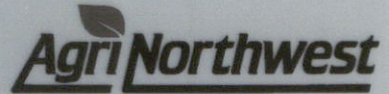

Legend

- Point of Diversion (POD)
- Government Lot (GL)
- - Pipeline
- ~ Watercourse
- Tax Lot

POD Location Description

Columbia River Pump Station
Located South 86 degrees 22 minutes 46 seconds West,
2,829 feet from the NE corner of Section 2, Township 4 North,
Range 25 East (W.M.)


DISCLAIMER

This map was prepared for the purpose of identifying the location of a water right only and it is not intended to provide legal dimensions or location of property ownership lines.

MAP NOTES

Data Sources: BLM, ODFW, OGIC, ESRI, USGS, Morrow and Umatilla Co.'s

Current as of: 11/27/2024

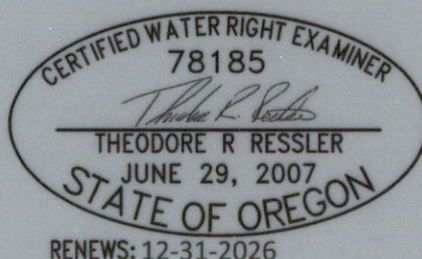

Received
APR 04 2025
OWRD

