



Claim of Beneficial Use - Place of use Map
Transfer T-13525 (former Certificate 92992)

A Water Right in the Name of Farmland Reserve, Inc.
Umatilla County
Township 2 and 3 North, Range 28 East (W.M.)

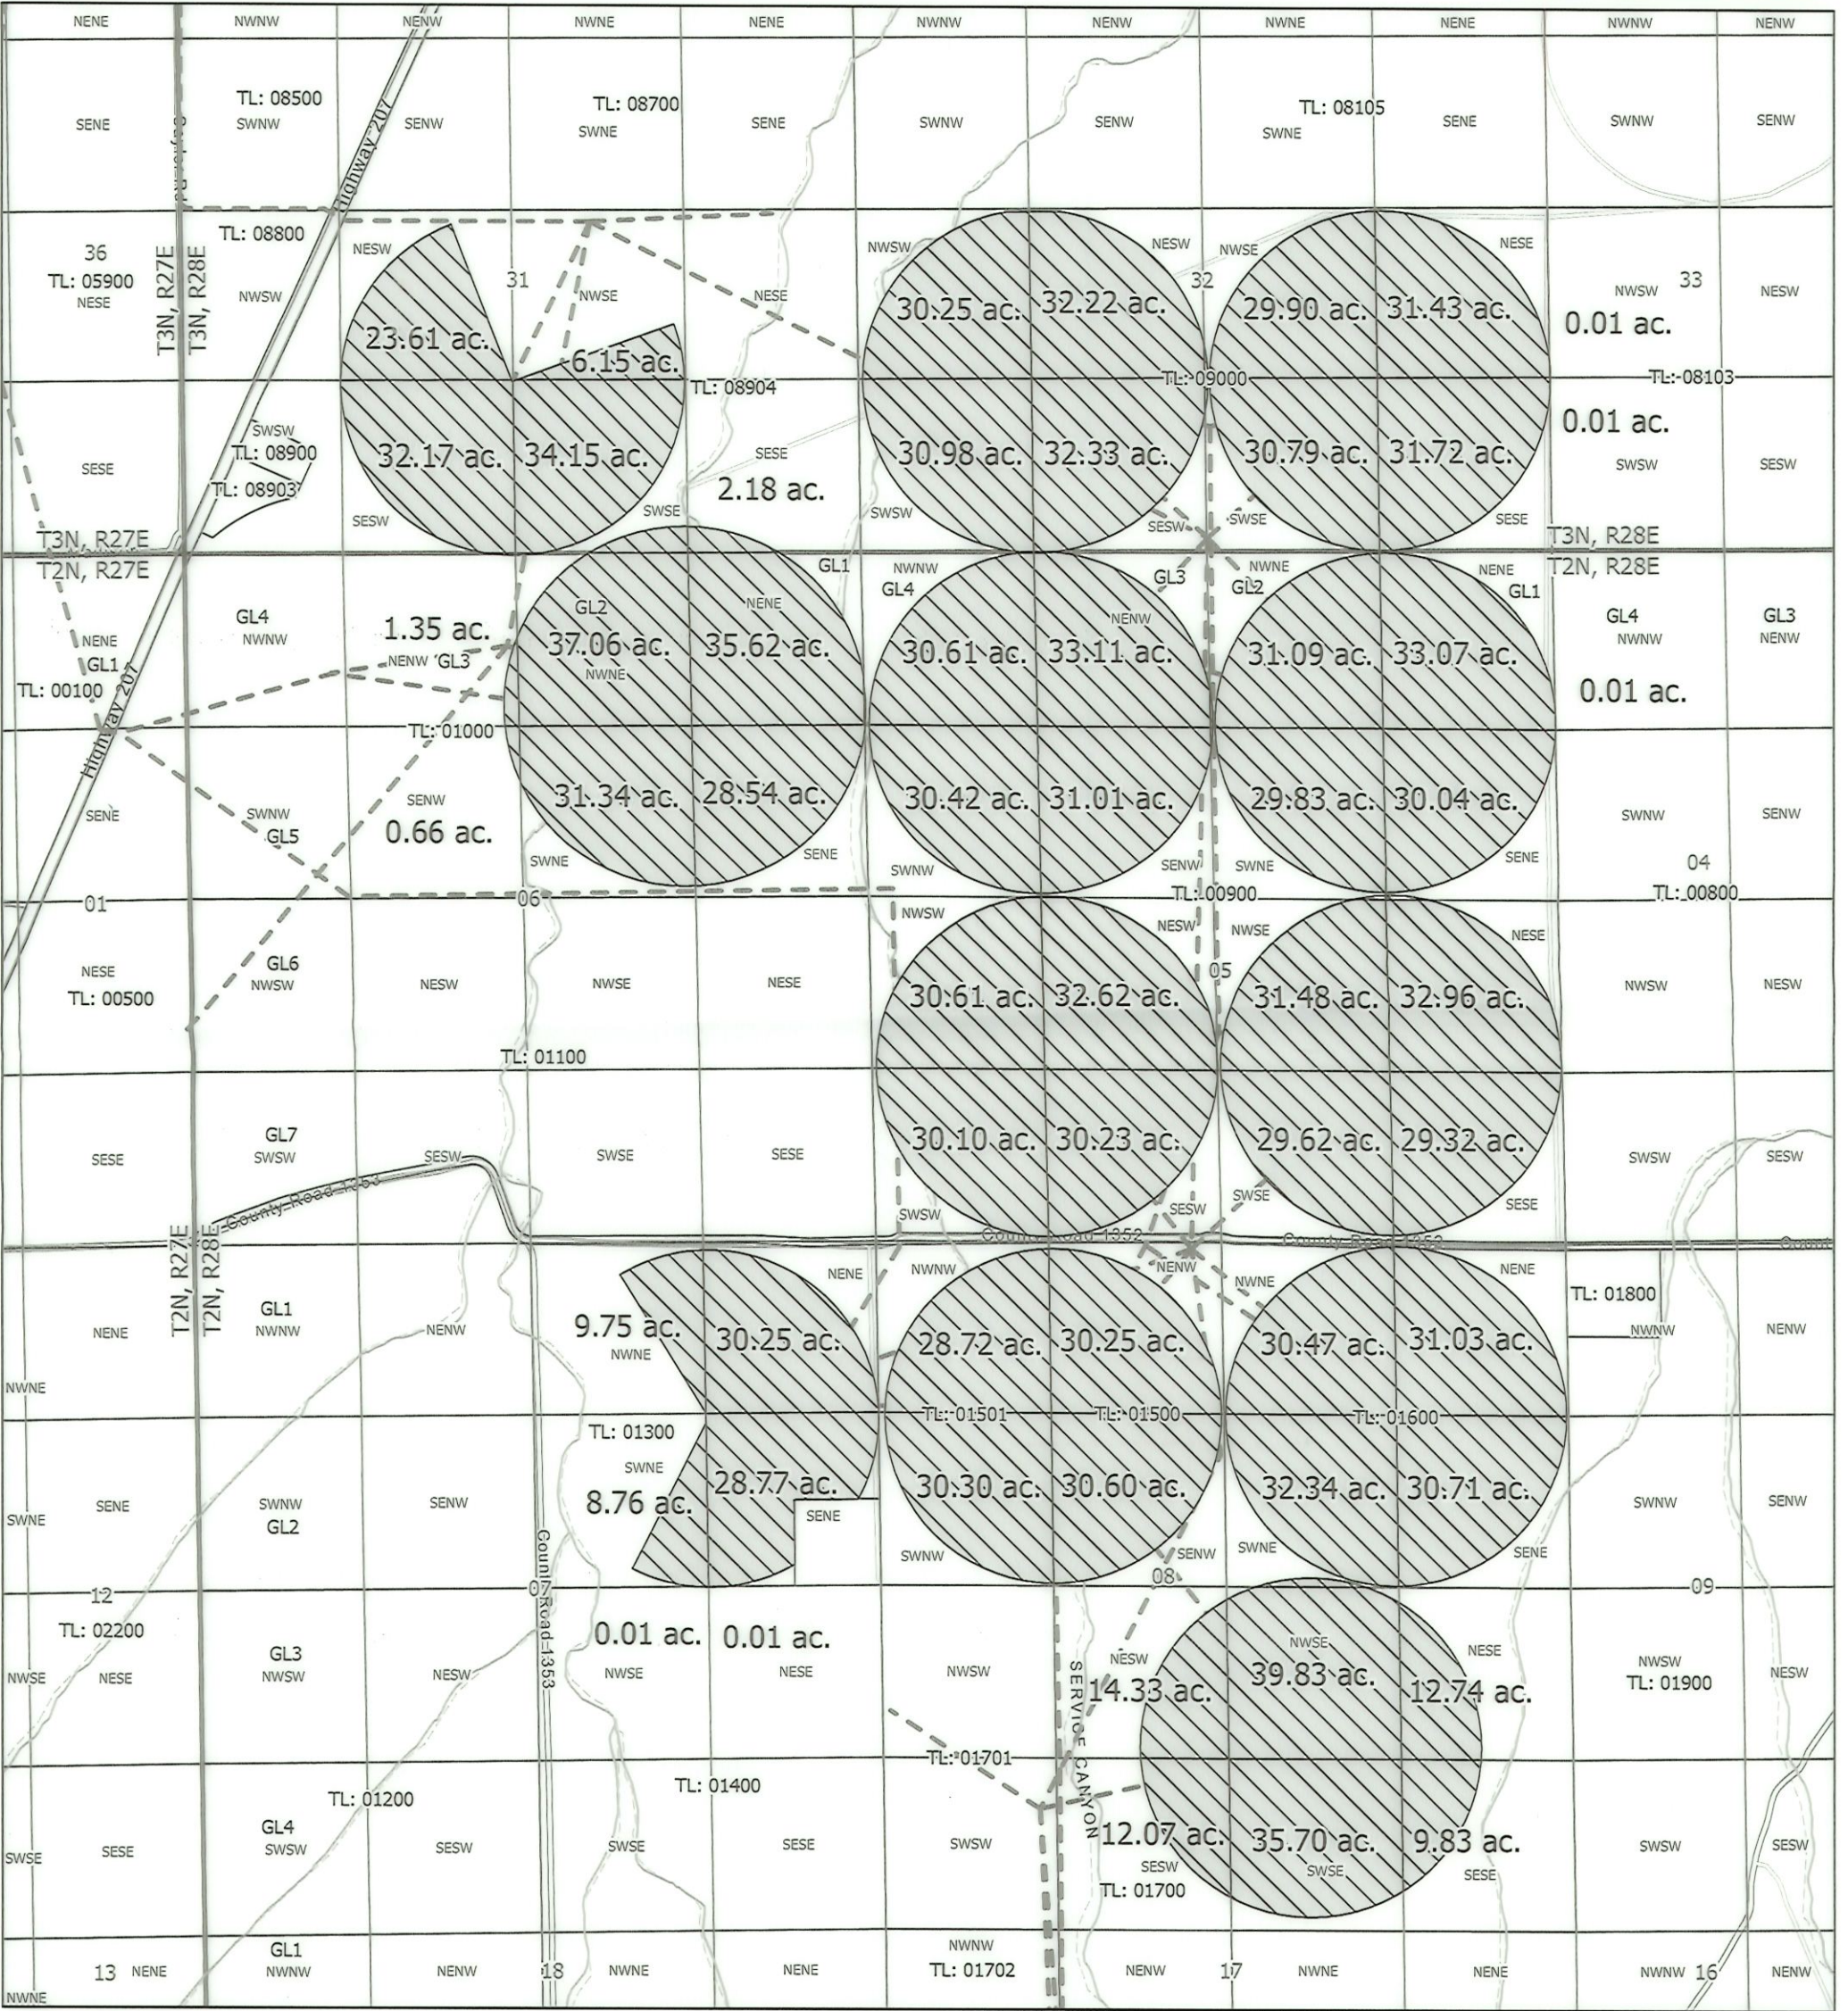

Legend

- Place of Use (1,425.07 acres)
- Pipeline
- Watercourse
- Tax Lot
- Government Lot (GL)

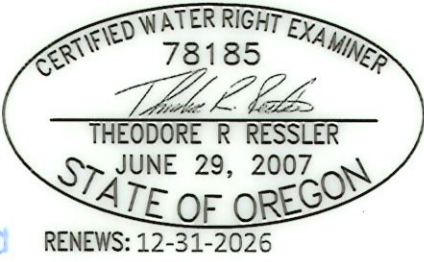

DISCLAIMER

This map was prepared for the purpose of identifying the location of a water right only and it is not intended to provide legal dimensions or location of property ownership lines.

MAP NOTES

Data Sources: BLM, ODFW, OGIC, ESRI, USGS, Umatilla Co.
Current as of: 11/7/2024



0 690 1,380 Feet

1" = 1,320 feet