


A Water Right in the Name of Farmland Reserve, Inc.

N

Scale

0 660 1,320 ft

1-inch = 1,320 feet

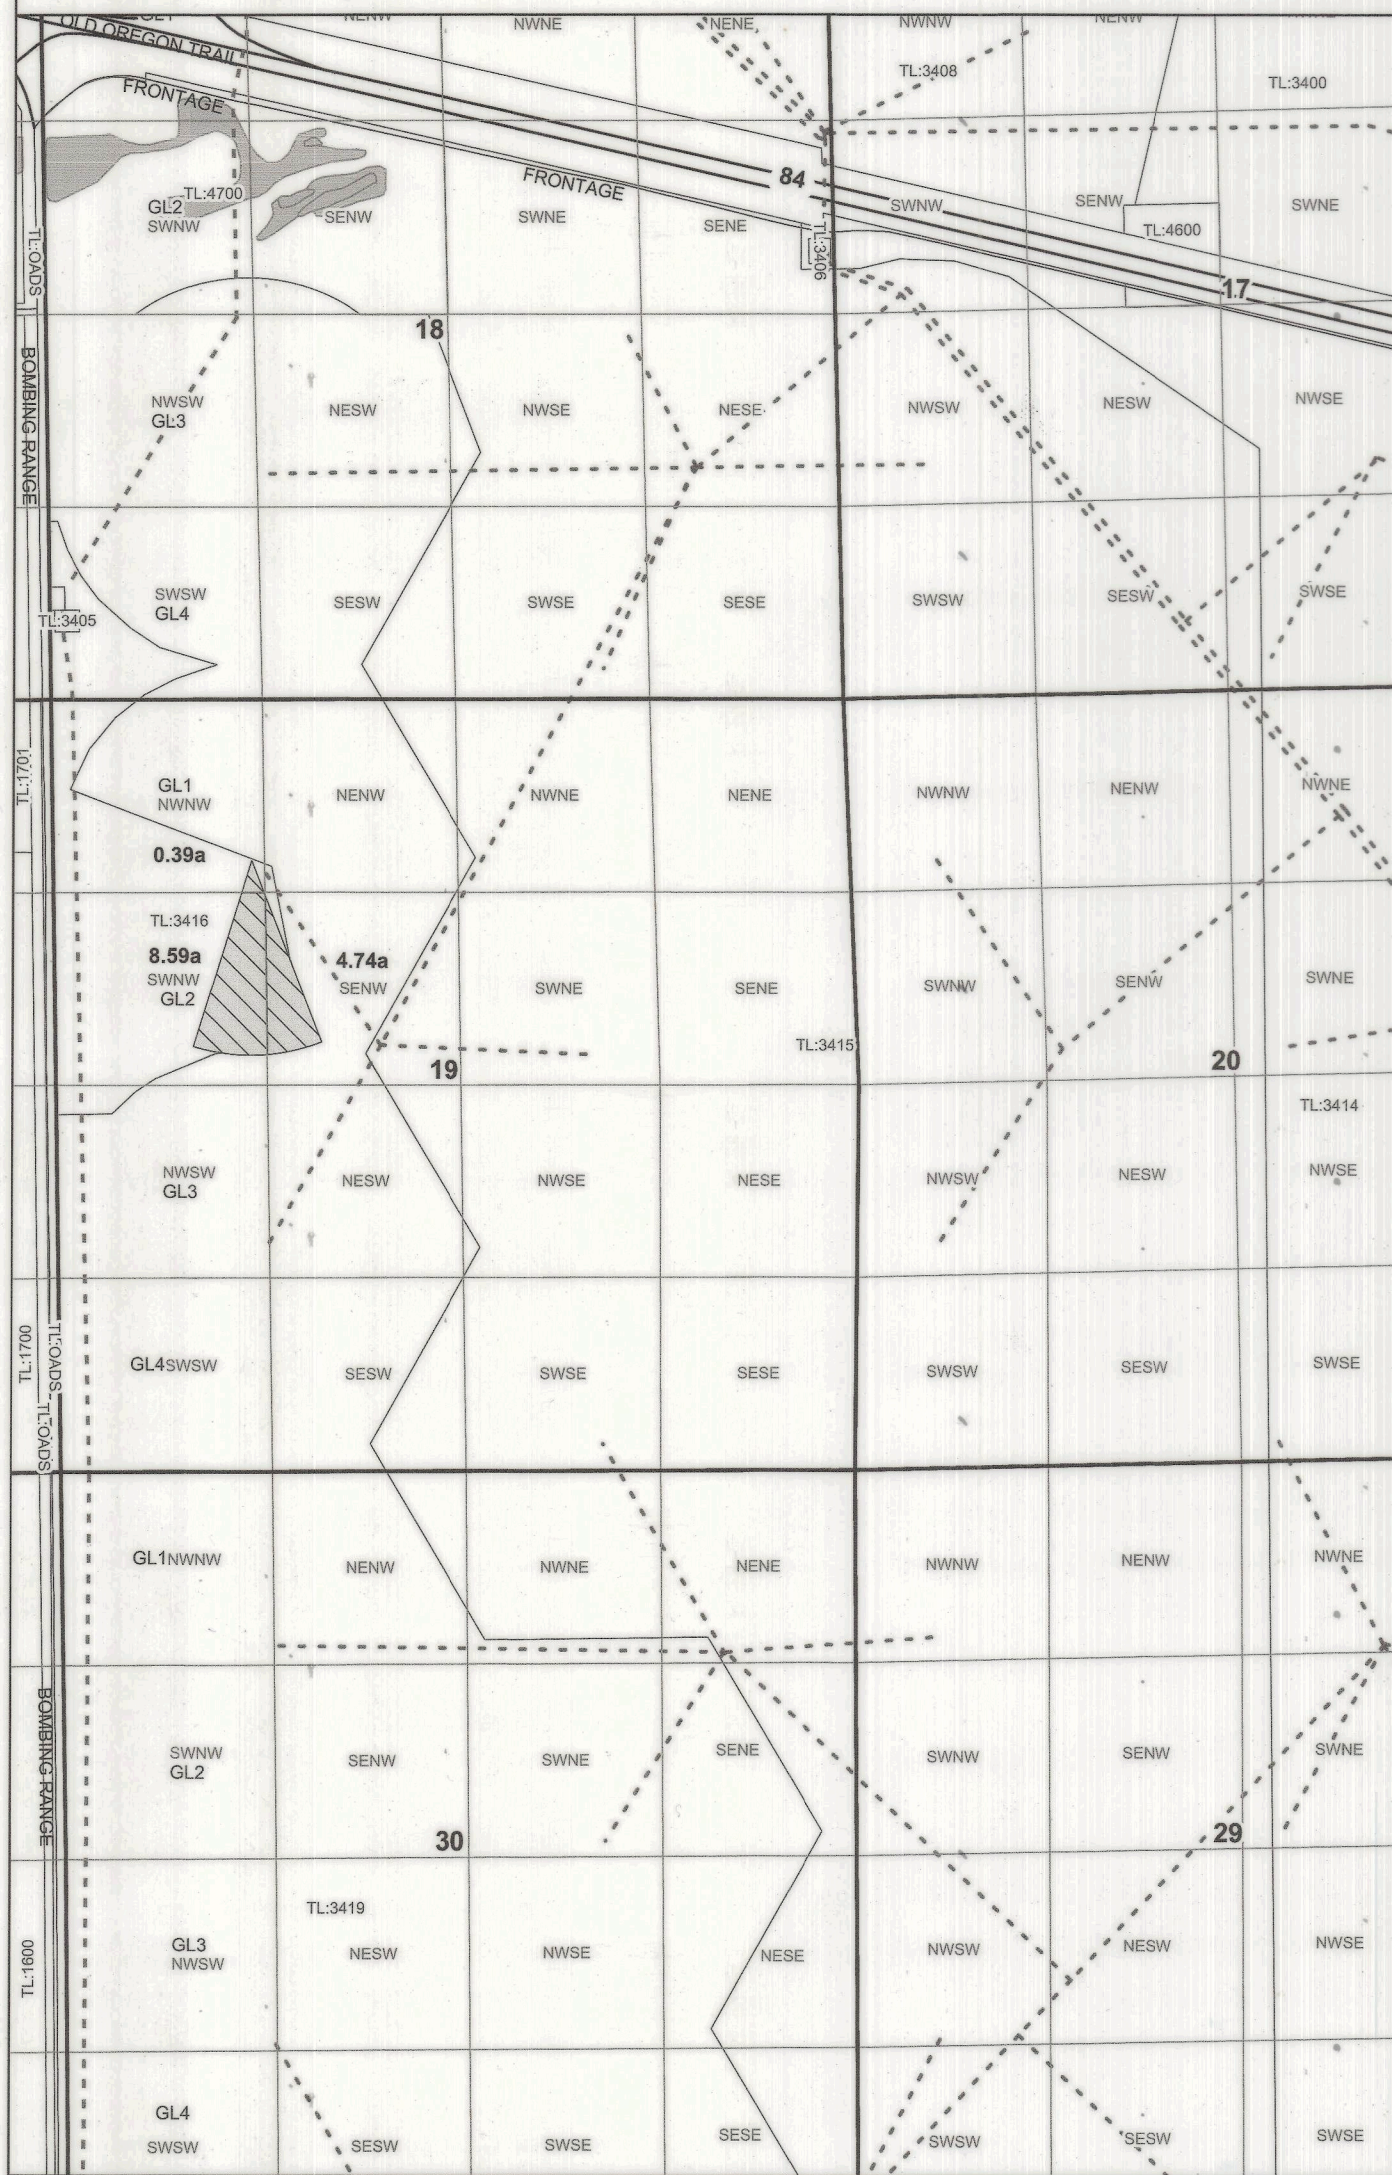


N

Scale

0 660 1,320 ft

1-inch = 1,320 feet

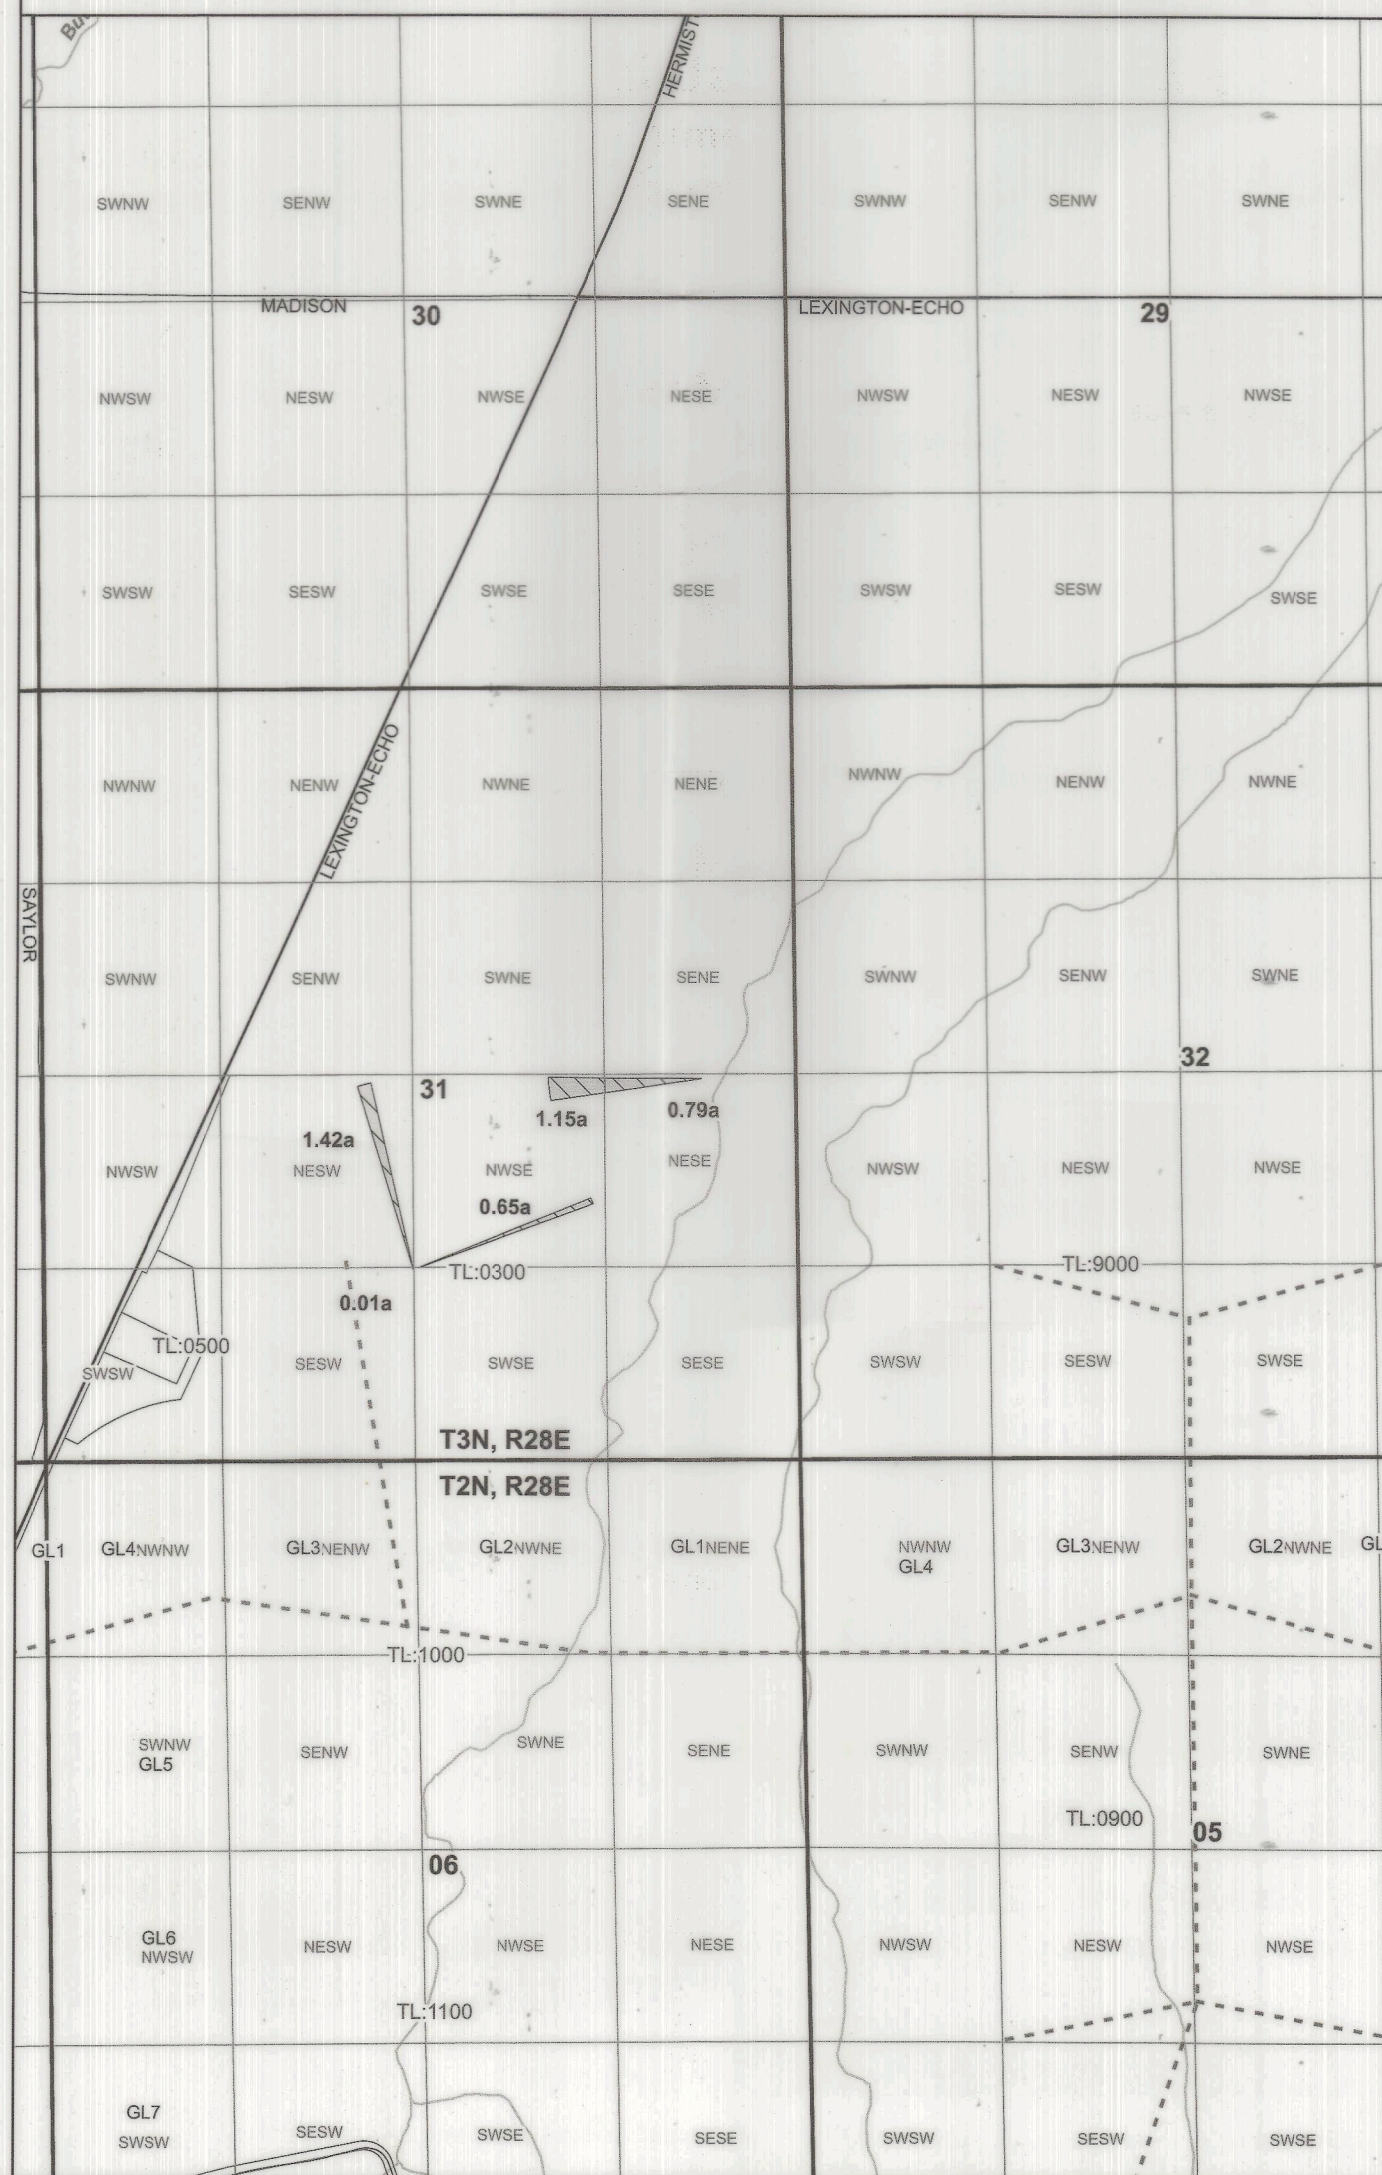


N

Scale

0 660 1,320 ft

1-inch = 1,320 feet

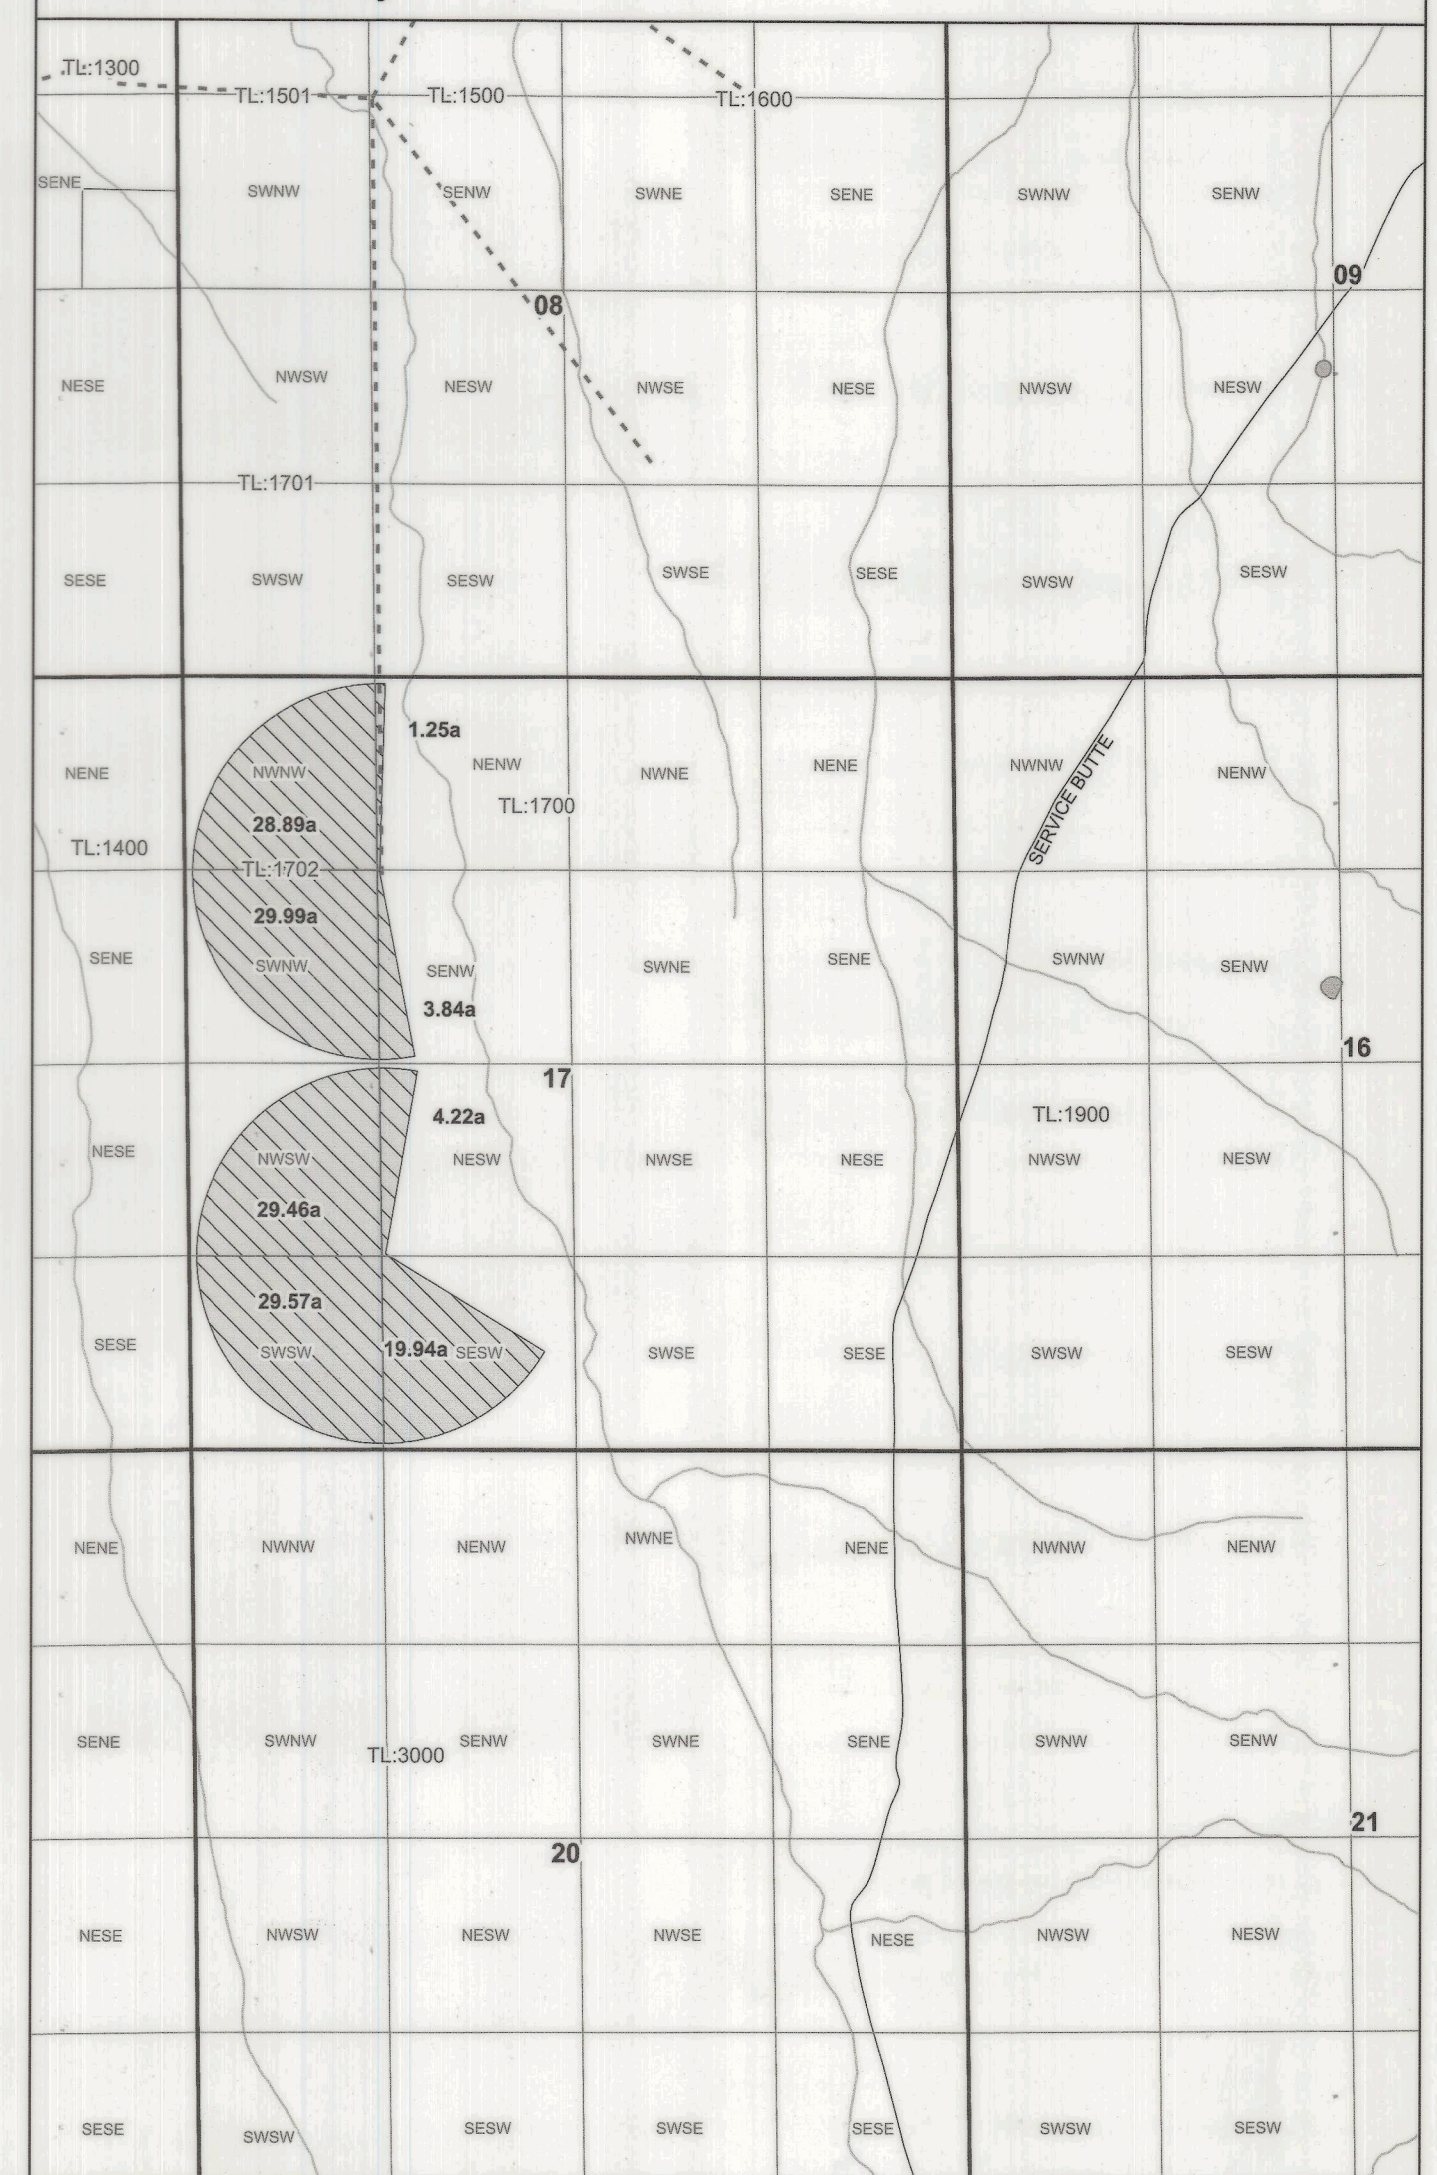

 Tax Lots
 Roads
 Railroads
 Watercourses
 Pipelines

Disclaimer: This map was prepared for the purpose of identifying the location of a water right only and is not intended to provide legal dimensions or property ownership lines.

CERTIFIED WATER RIGHT EXAMINER
78185
Theodore R. Ressler
THEODORE R. RESSLER
JUNE 29, 2007
STATE OF OREGON
RENEWALS: 12-31-2026

