


Claim of Beneficial Use - Place of Use Map

Transfer T-13525 (former Certificate 93872)

A Water Right in the Name of Farmland Reserve, Inc.


Map 1:
Township 2 & 3 N, Range 27 & 28 E (W.M.)
Umatilla County

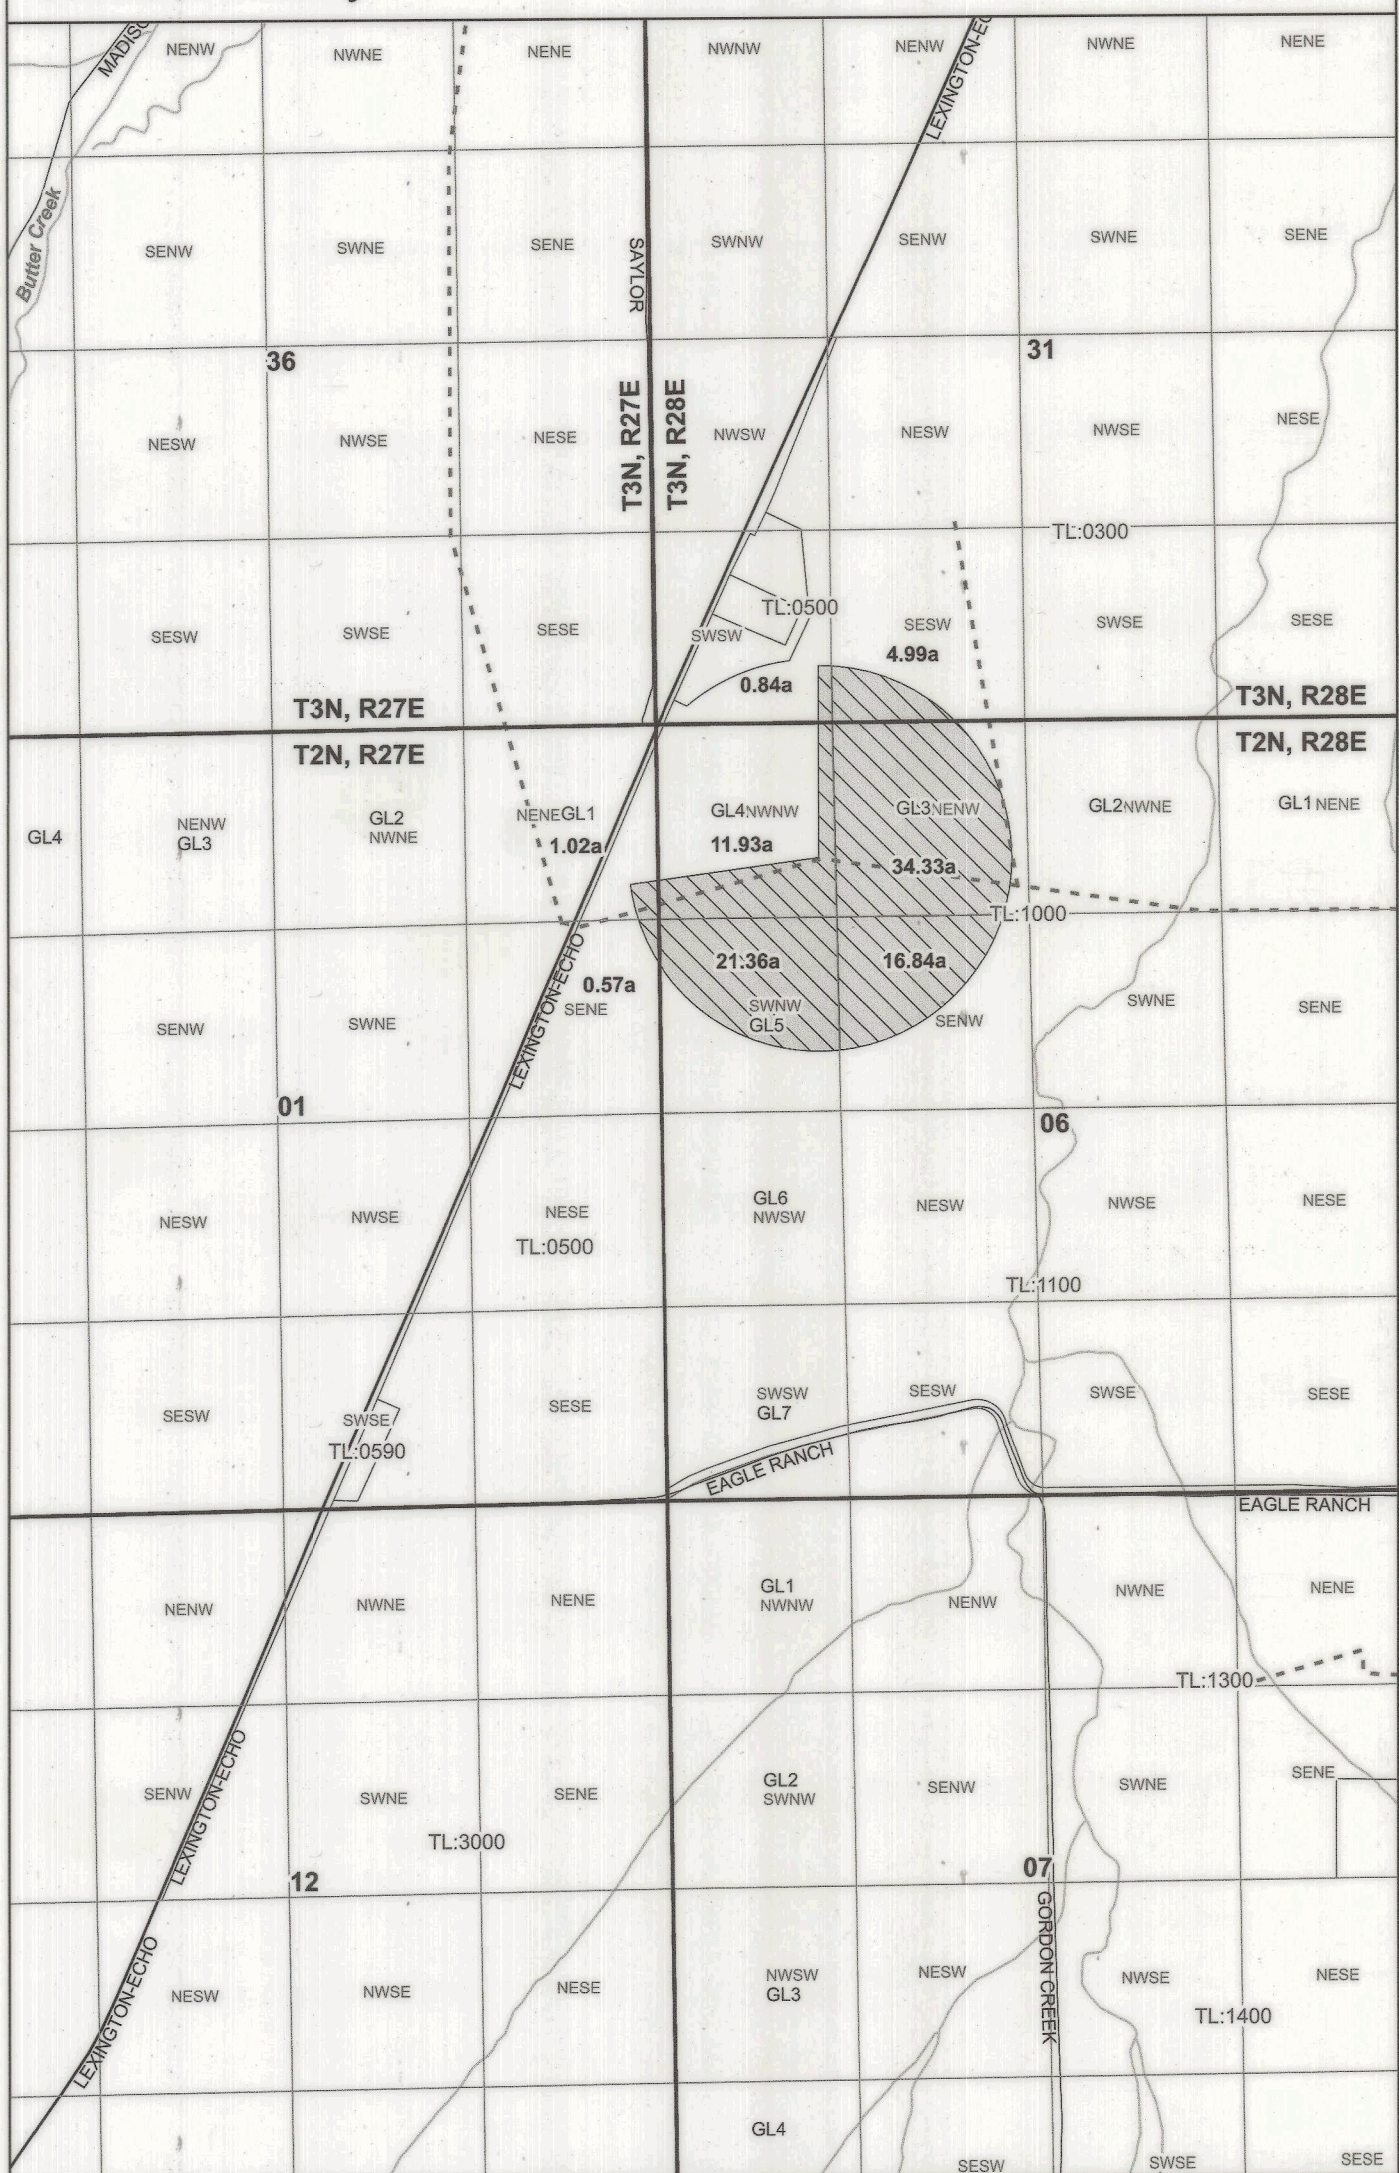


Map 2:
Township 3 N, Range 29 E (W.M.)
Umatilla County



Map 3:
Township 3 N, Range 29 E (W.M.)
Umatilla County

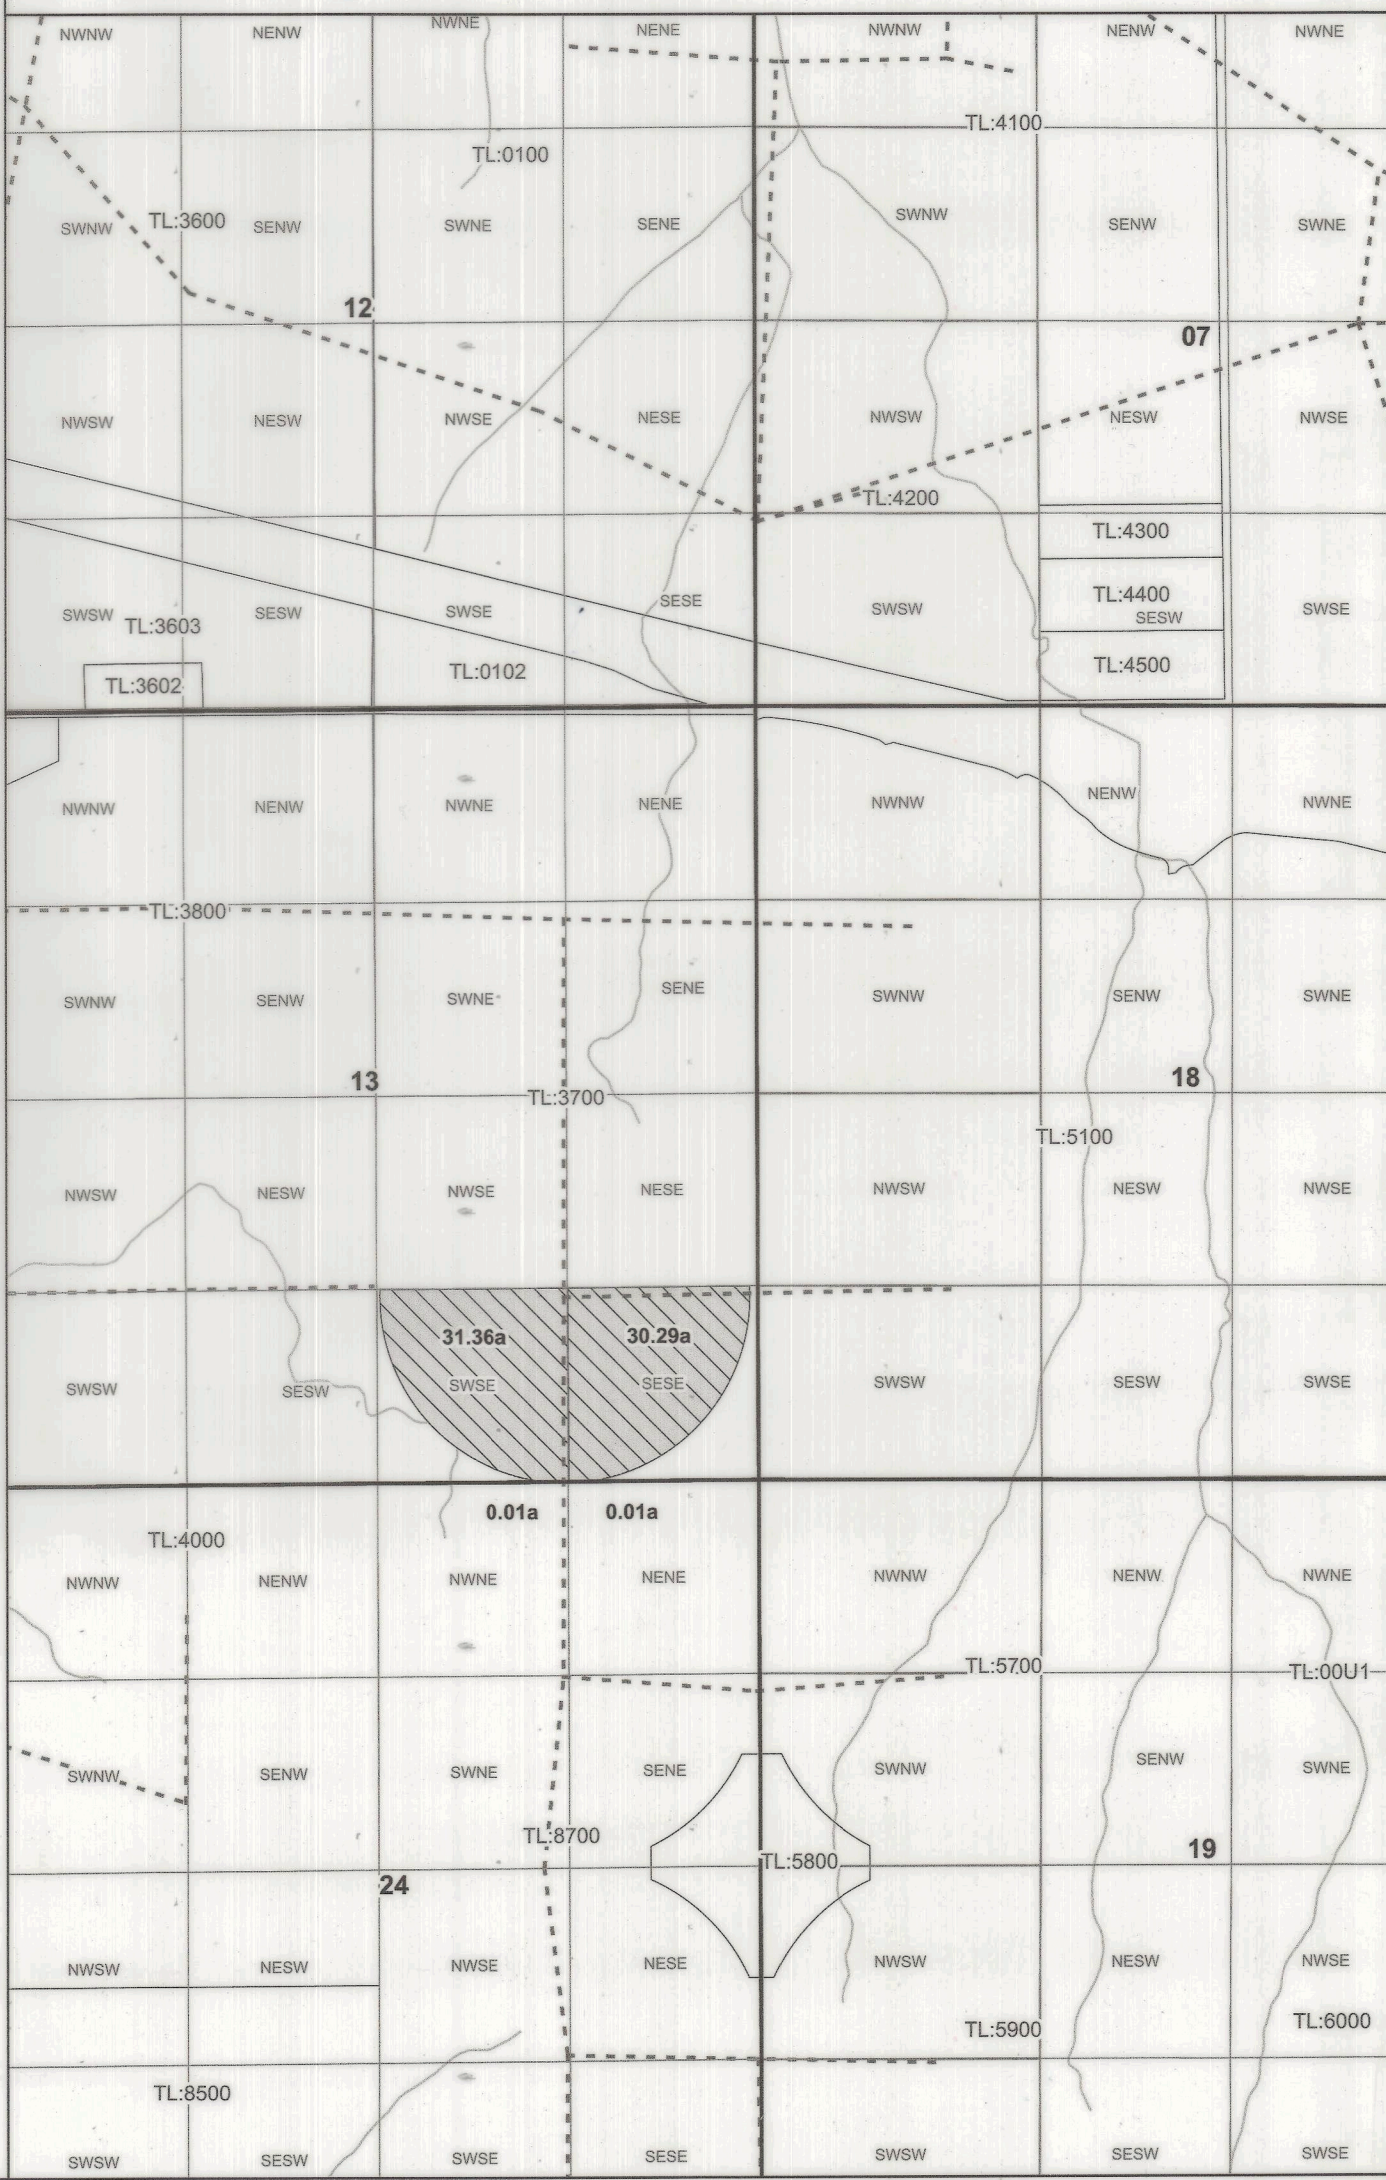


Map 4:
Township 3 N, Range 30 E (W.M.)
Umatilla County

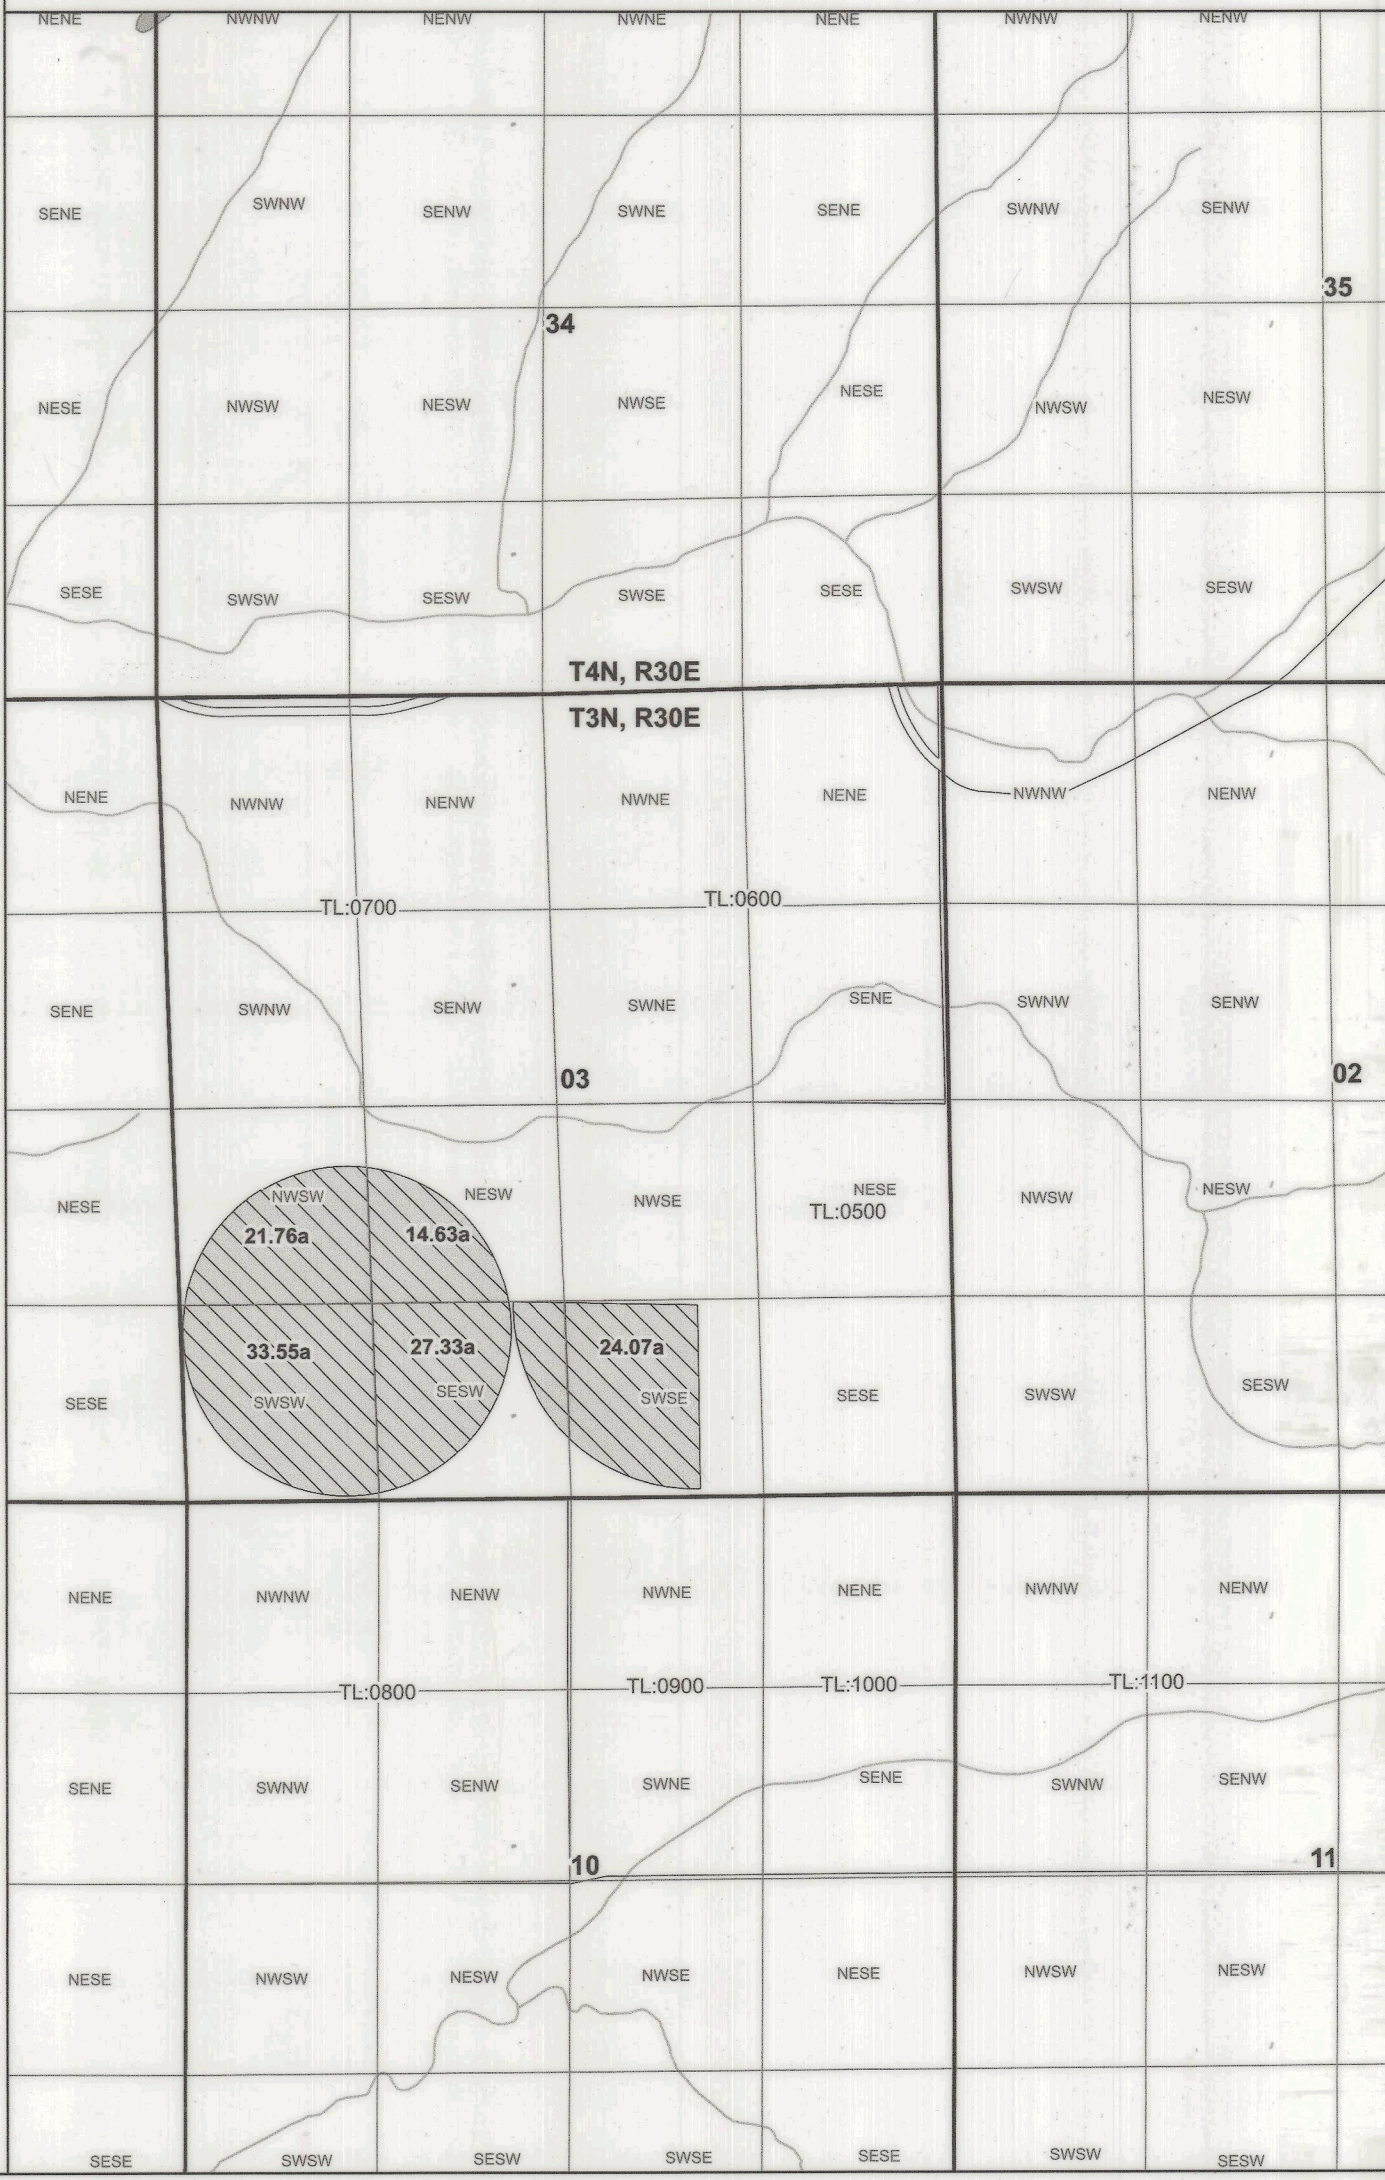

- LEGEND**
- Place of Use (368.93 + 497.83 = 866.76 acres)
 - Pipelines
 - Tax Lots
 - Railroads
 - Roads
 - Watercourses



Date: 11/6/2024
Data Sources: BLM, OGIC, ESRI, USGS, Umatilla Co.
Disclaimer: This map was prepared for the purpose of identifying the location of a water right only and is not intended to provide legal dimensions or location of property ownership lines.

Received
APR 04 2025
OWRD

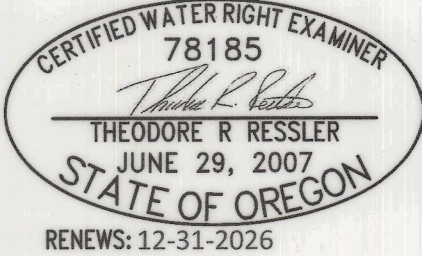

Claim of Beneficial Use - Point of Diversion Map 2 Transfer T-13525 (former Certificate 93872)

A Water Right in the Name of Farmland Reserve, Inc.
Umatilla County
Township 5 North, Range 30 East (W.M.)

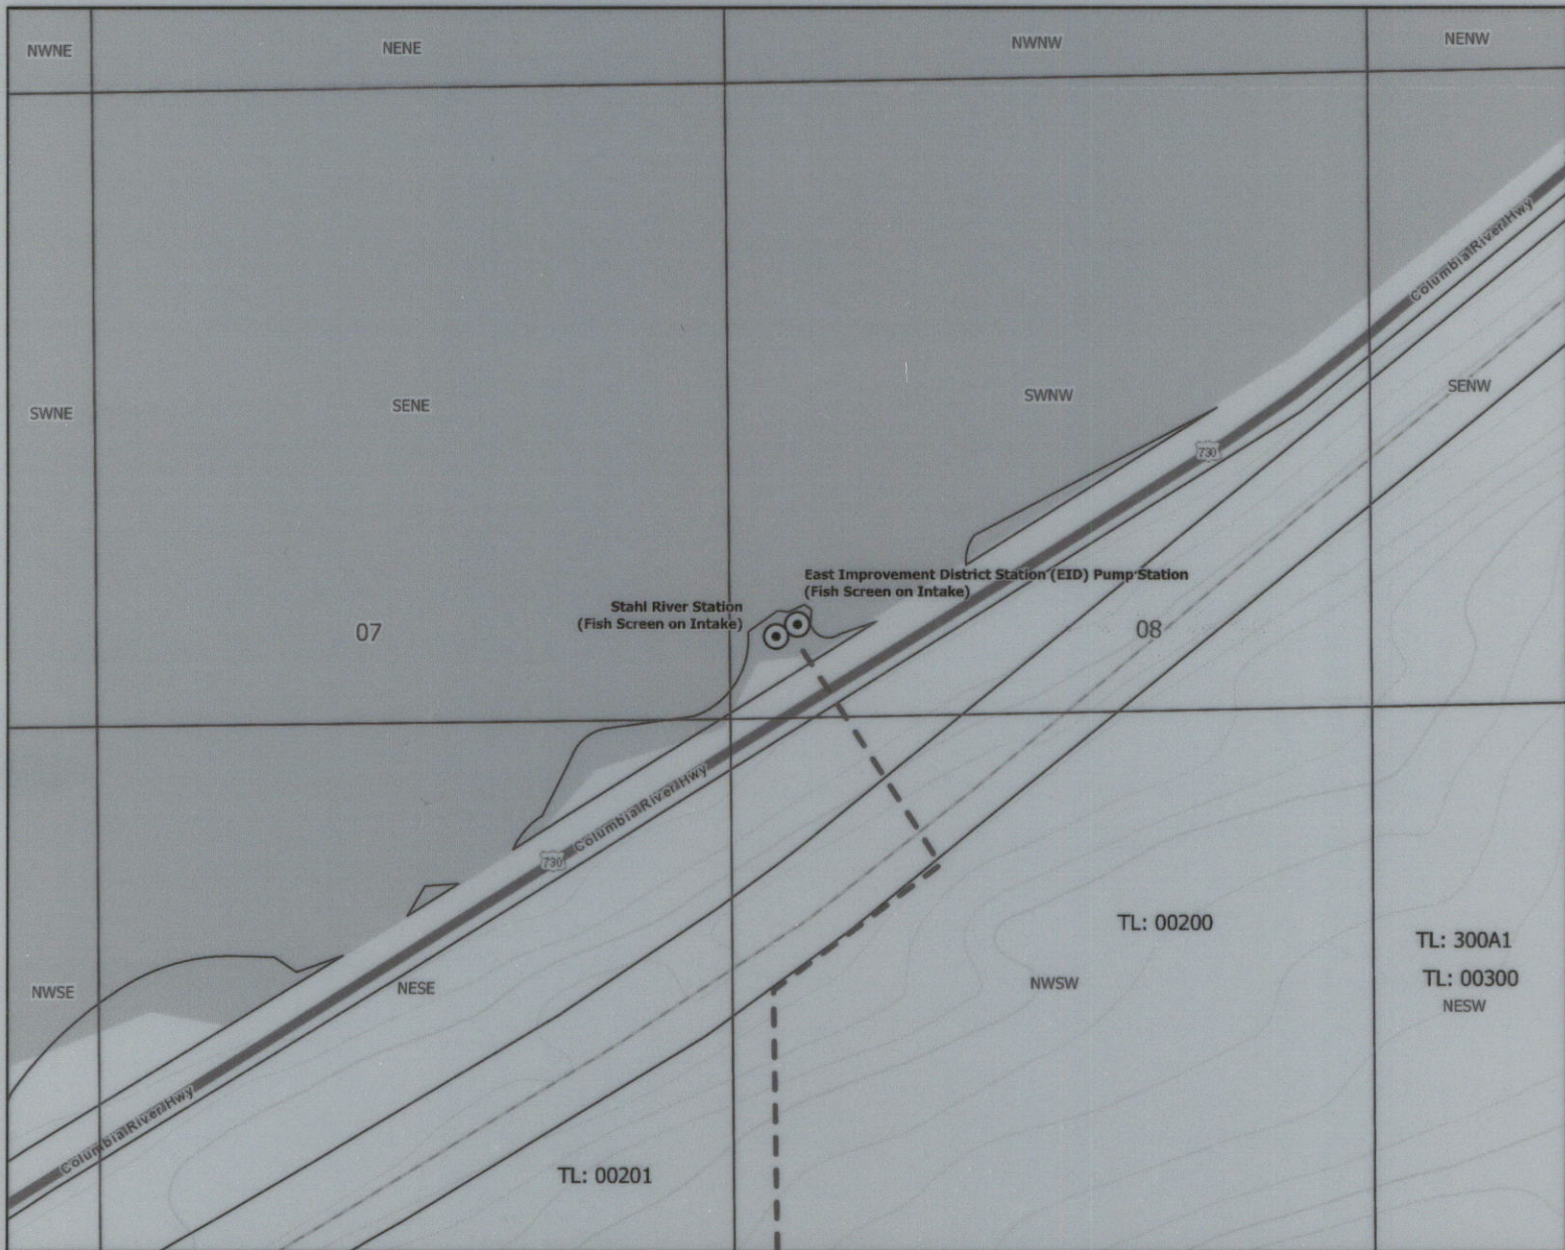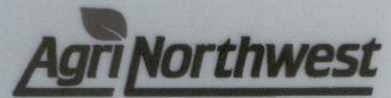


Legend

- ⊙ Point of Diversion (POD)
- Government Lot (GL)
- - Pipeline
- ~ Watercourse
- Tax Lot

POD Location Description

Stahl Pump Station: Located 2860 feet North and 70 feet East from the SW corner of Section 8, Township 5 North, Range 30 East (W.M.)

East Improvement District (EID) Pump Station: Located 2910 feet North and 120 feet East from the SW corner of Section 8, Township 5 North, Range 30 East (W.M.)

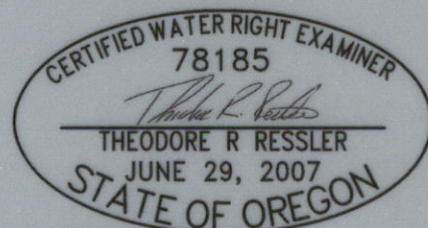

DISCLAIMER

This map was prepared for the purpose of identifying the location of a water right only and it is not intended to provide legal dimensions or location of property ownership lines.

MAP NOTES

Data Sources: BLM, ODFW, OGIC, ESRI, USGS, Morrow and Umatilla Co.'s

Current as of: 11/27/2024

Received

APR 04 2025

OWRD



0 200 400 Feet
1" = 400 feet