

Claim of Beneficial Use - Place of Use Map

Transfer T-13525 (former Certificate 95662)

A Water Right in the Name of Farmland Reserve, Inc.

Morrow County



Township 4 North, Range 26 East (W.M.)



LEGEND

- Place of Use (30.58 acres)
- Tax Lots
- Roads
- Railroads
- Watercourses
- Pipelines

Received
APR 04 2025
OWRD

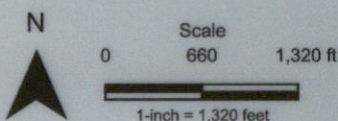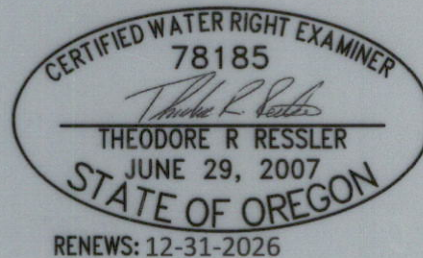

Date: 11/6/2024
Data Sources: BLM,OGIC, ESRI, USGS, Morrow Co.
Disclaimer: This map was prepared for the purpose of identifying the location of a water right only and is not intended to provide legal dimensions or location of property ownership lines.

