


COLUMBIA IMPROVEMENT DISTRICT C/O KEITH TIEGS  
 2025 PERMANENT TRANSFER APPLICATION AMENDED 12/2/25  
 INVOLVING CERT 94872  
 T3N, R26E, W.M. MORROW CO.  
 FROM MAP

E-RECEIVED  
 DEC 2, 2025  
 OWRD

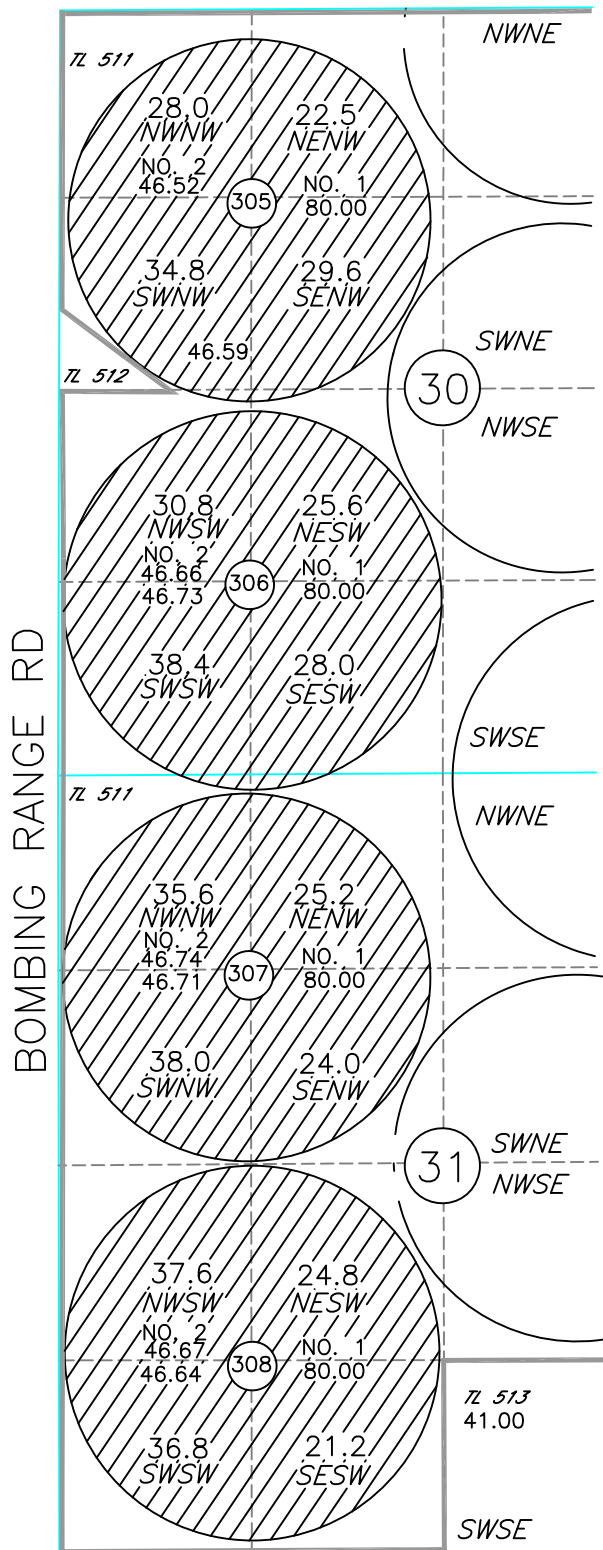


INDEX


480.9 AC.  
 CERT 94872

TAX LOT BOUNDARY

\*This area is currently involved in a 2025 one-year district temporary transfer (T-14599). The permanent change in the place of use will be effective starting the 2026 irrigation season

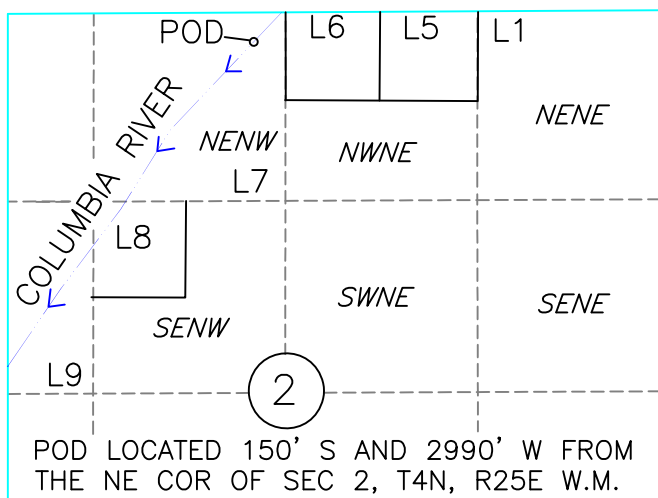


POD LOCATED 150' S AND 2990' W FROM THE NE COR OF SEC 2, T4N, R25E W.M.

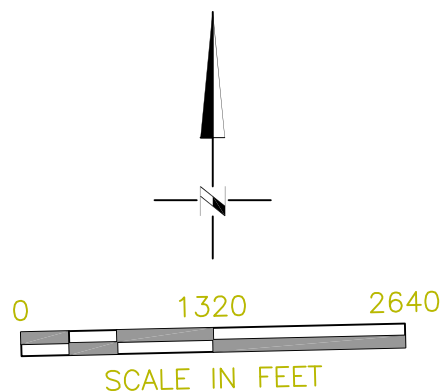

NOTE:  
 THE PURPOSE OF THIS MAP IS TO IDENTIFY THE APPROXIMATE LOCATION OF THE WATER RIGHT. IT IS NOT INTENDED TO PROVIDE INFORMATION RELATIVE TO THE LOCATION OF PROPERTY OWNERSHIP BOUNDARY LINES.

T.48&5N., R.25E., W. M.

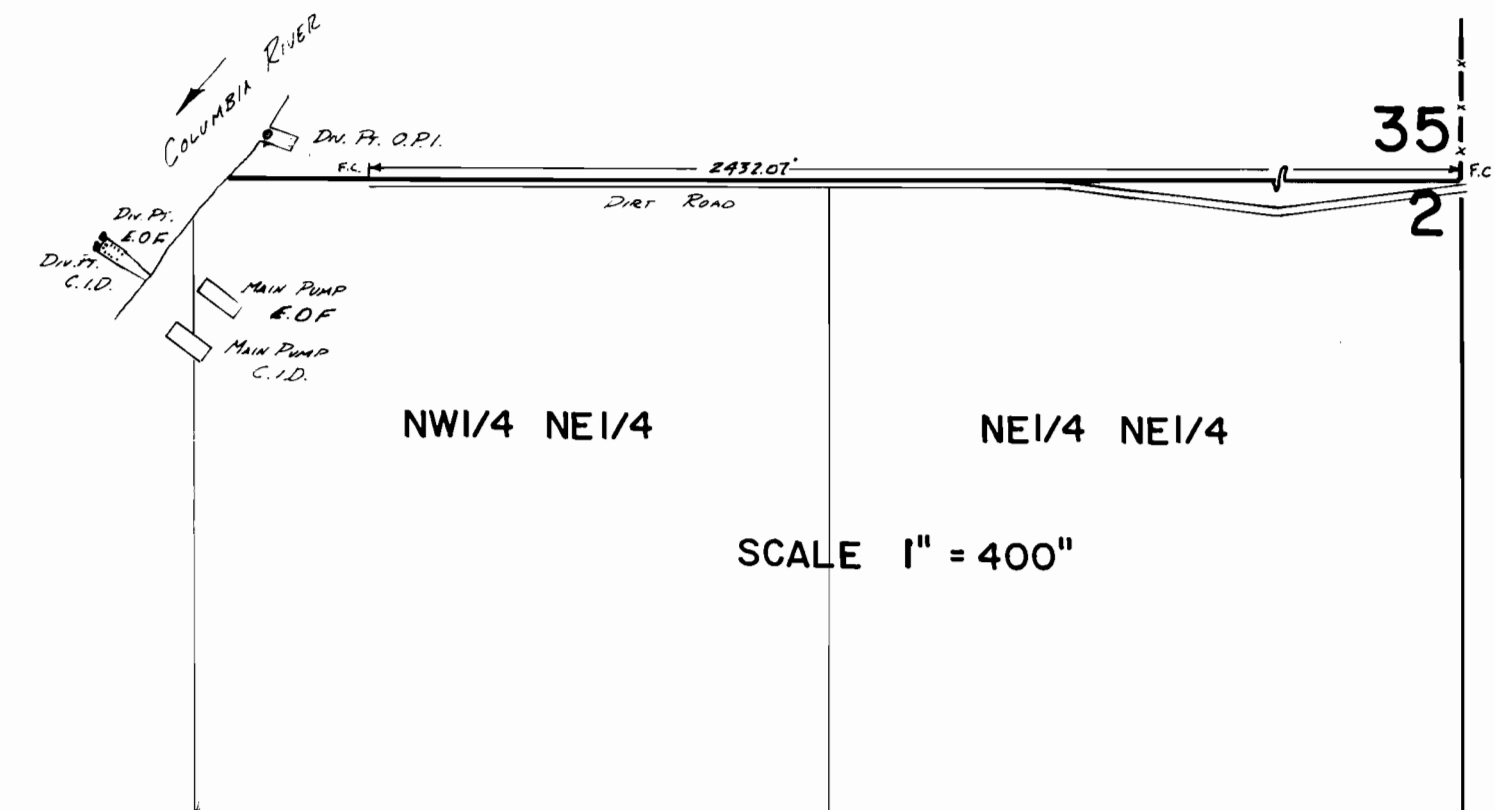

Div. Pt. O.P.I. Loc: 85' N. + 2640' W. FROM SE COR SEC 35  
Div. Pt. E.O.F. Loc: 120' S. + 2980' W. FROM NE COR. SEC 2  
Div. Pt. C.I.D. Loc: 150' S. + 2995' W. FROM NE COR. SEC 2

## FINAL PROOF SURVEY UNDER


Application No. 51650 Permit No. ....  
IN NAME OF

Surveyed Jan. 14, 1983, by V.L. Church




E-23-5

T. 2 & 3 N., R. 26 E., W.M.

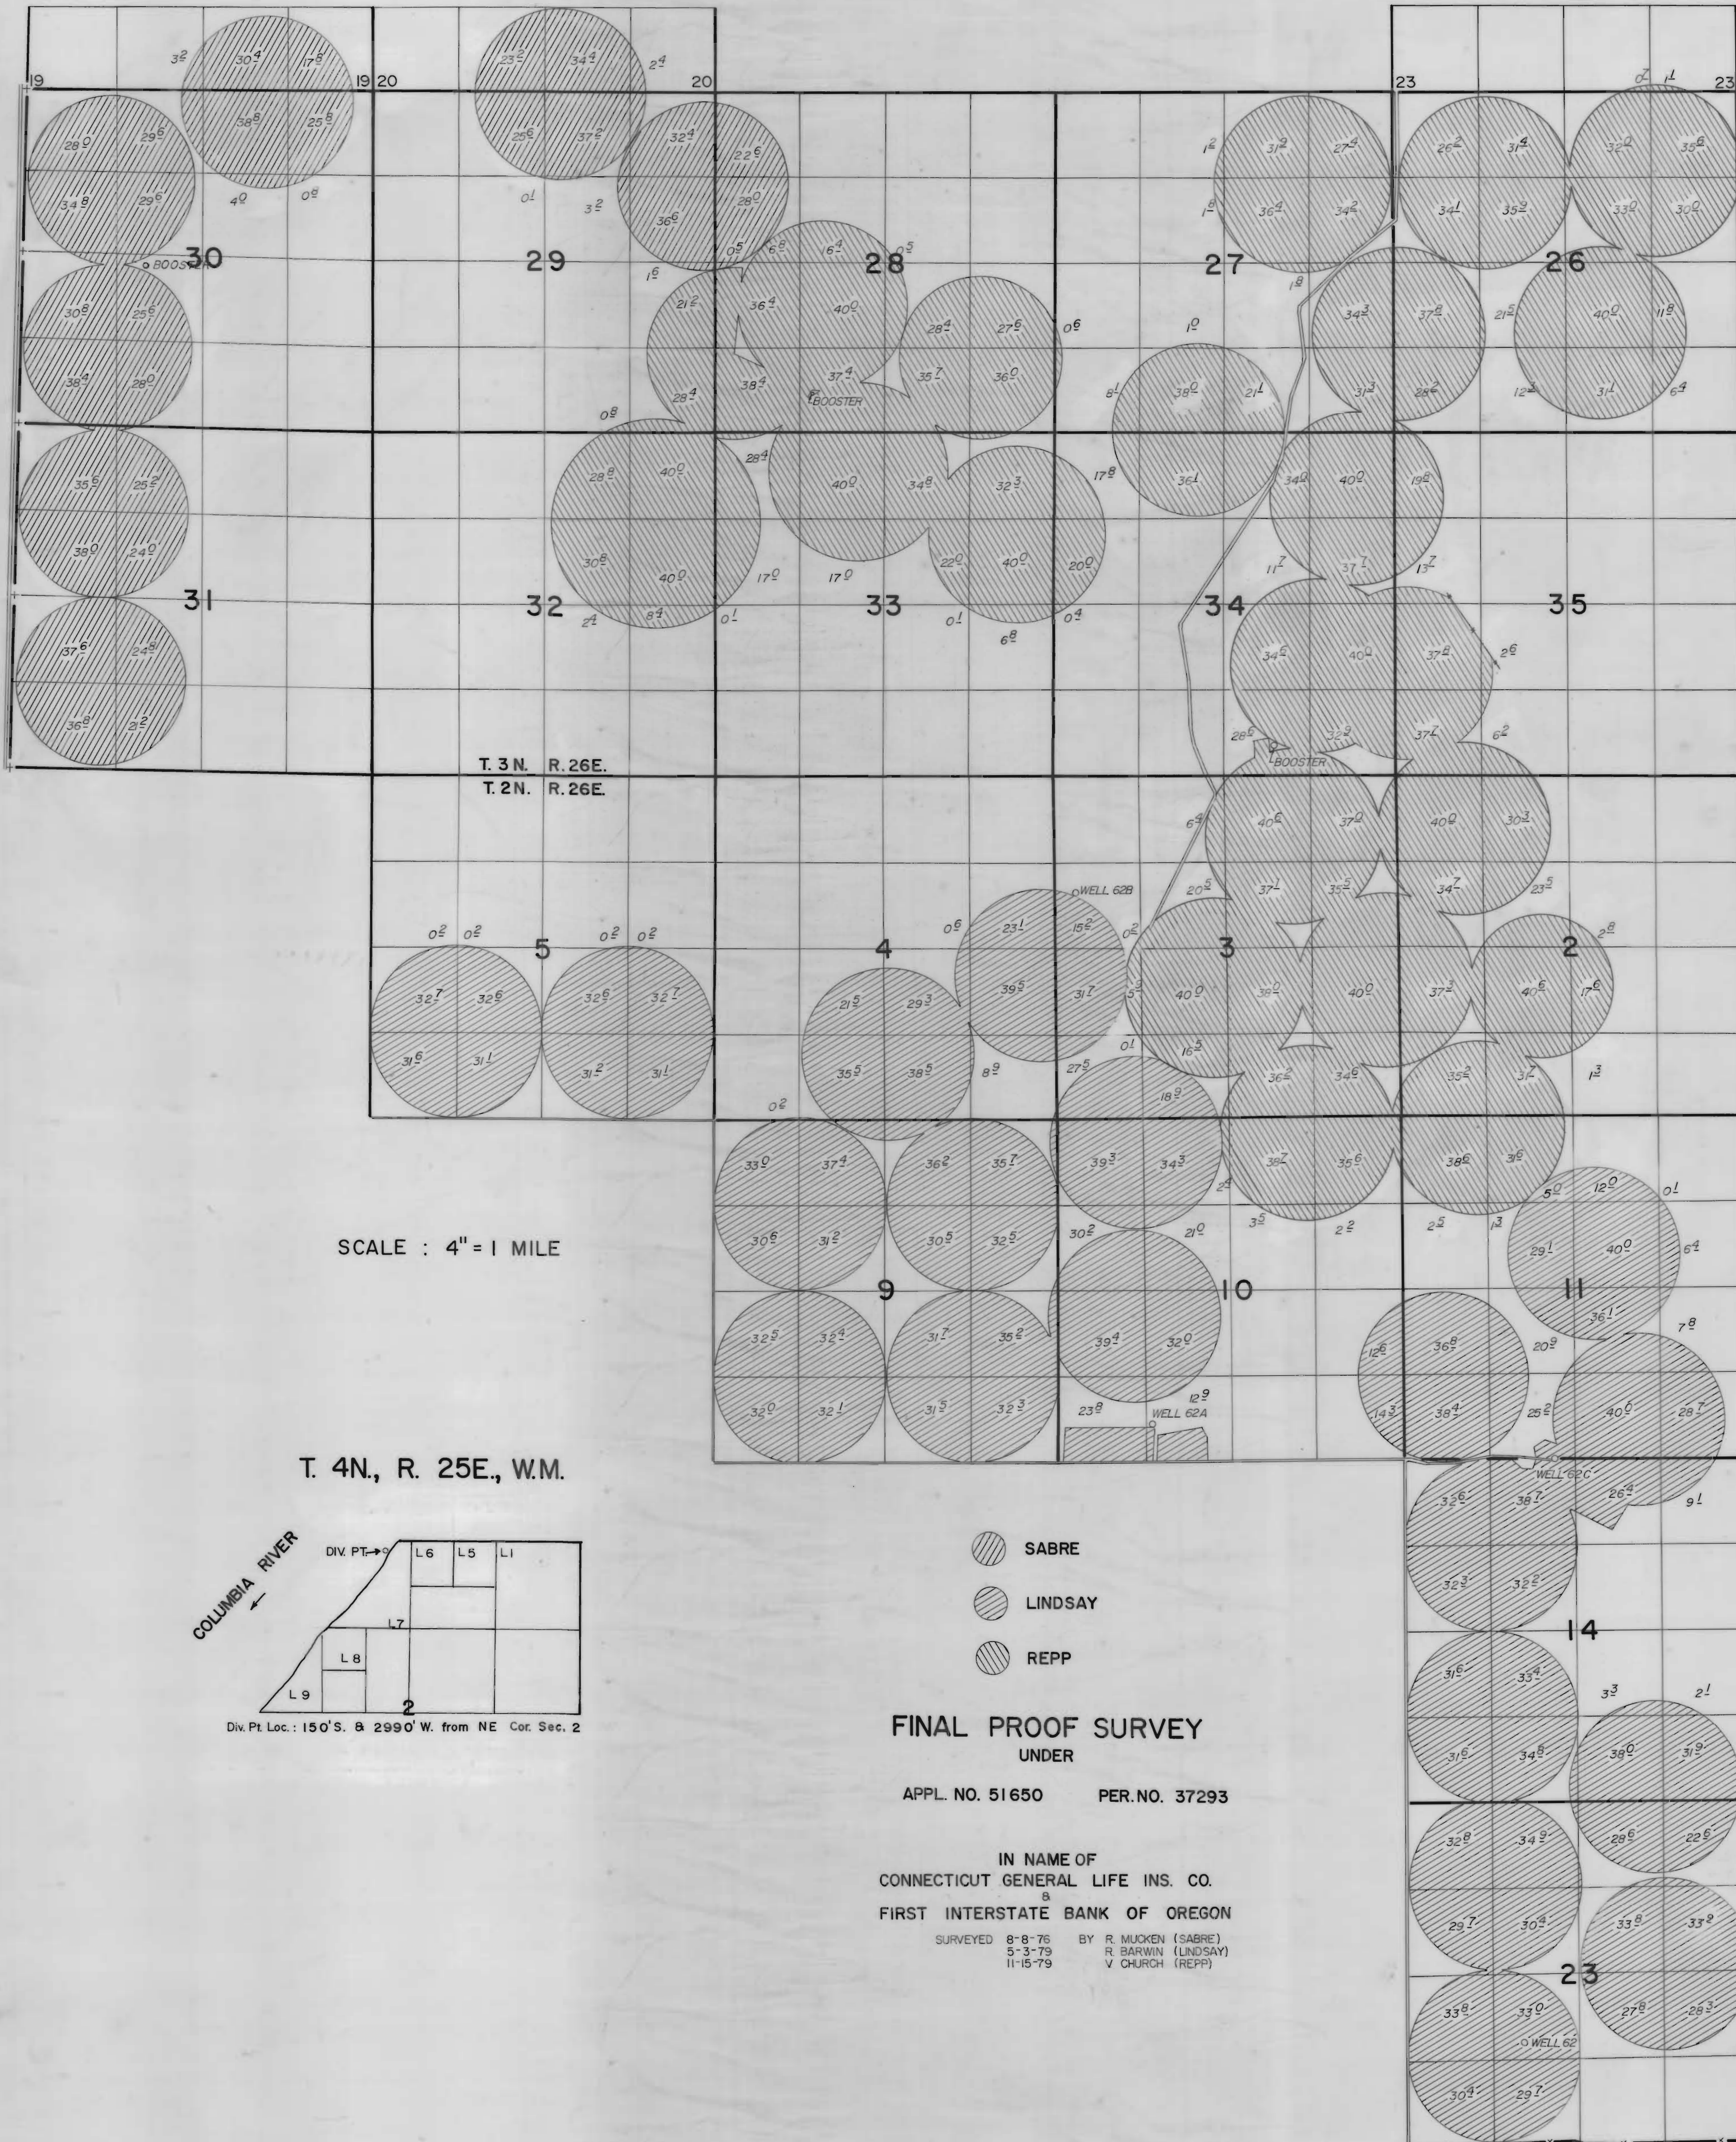

SCALE : 4" = 1 MILE

T. 4N., R. 25E., W.M.

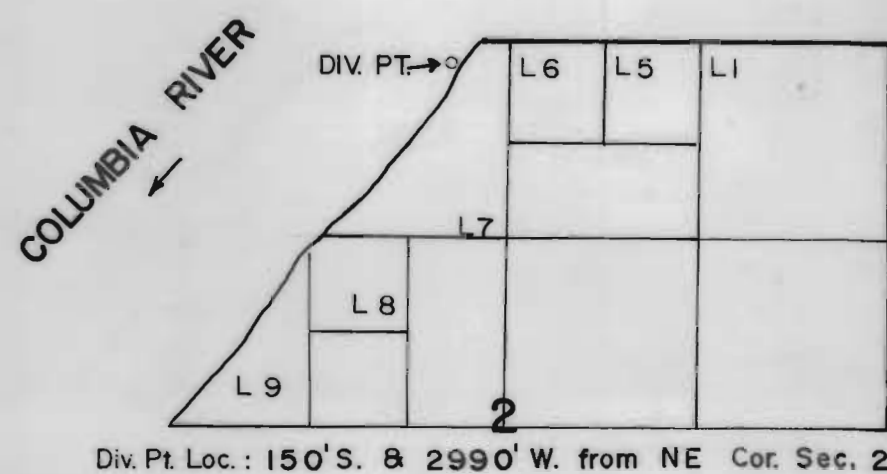

- SABRE
- LINDSAY
- REPP

FINAL PROOF SURVEY  
UNDER

APPL. NO. 51650 PER. NO. 37293

IN NAME OF  
CONNECTICUT GENERAL LIFE INS. CO.  
&  
FIRST INTERSTATE BANK OF OREGON

SURVEYED 8-8-76 BY R. MUCKEN (SABRE)  
5-3-79 R. BARWIN (LINDSAY)  
11-15-79 V. CHURCH (REPP)



TL 1700

TL 1506

TL 511

TL 1513


Remaining  
Primary TR  
OFF  
T-13266

--- Tax Lot  
Lines

3N-26E Primary  
T-13266-RR-c.83517


North  
↑

T. 3 N. R. 26 E.  
T. 2 N. R. 26 E.

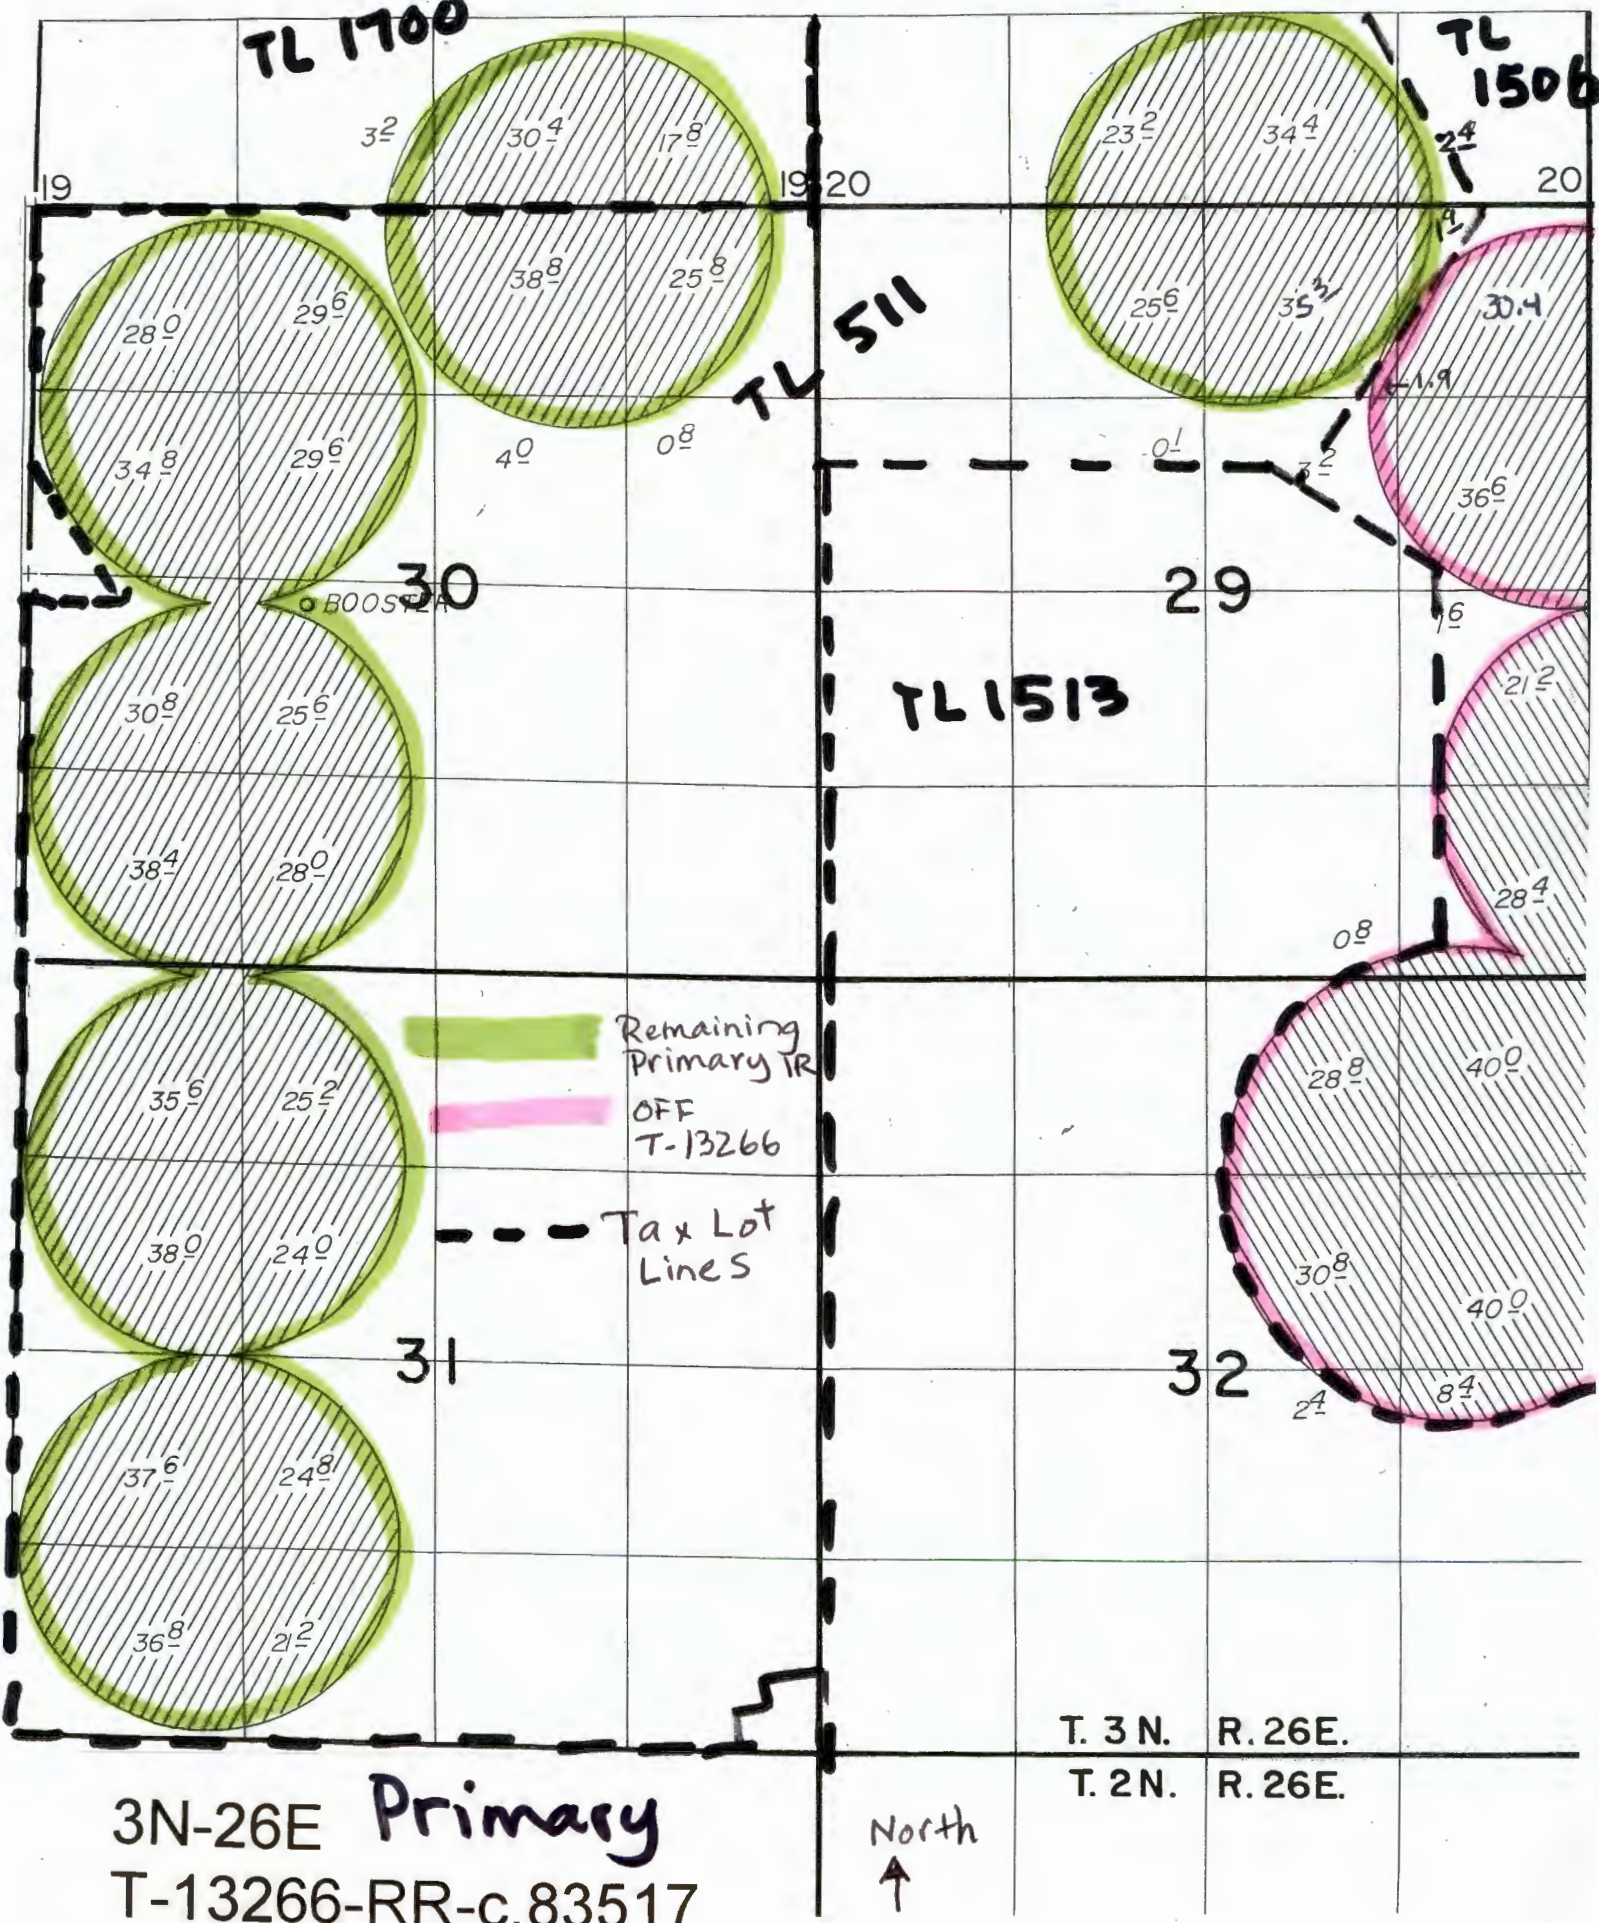




|         |          |
|---------|----------|
| T. 3 N. | R. 26 E. |
| T. 2 N. | R. 26 E. |

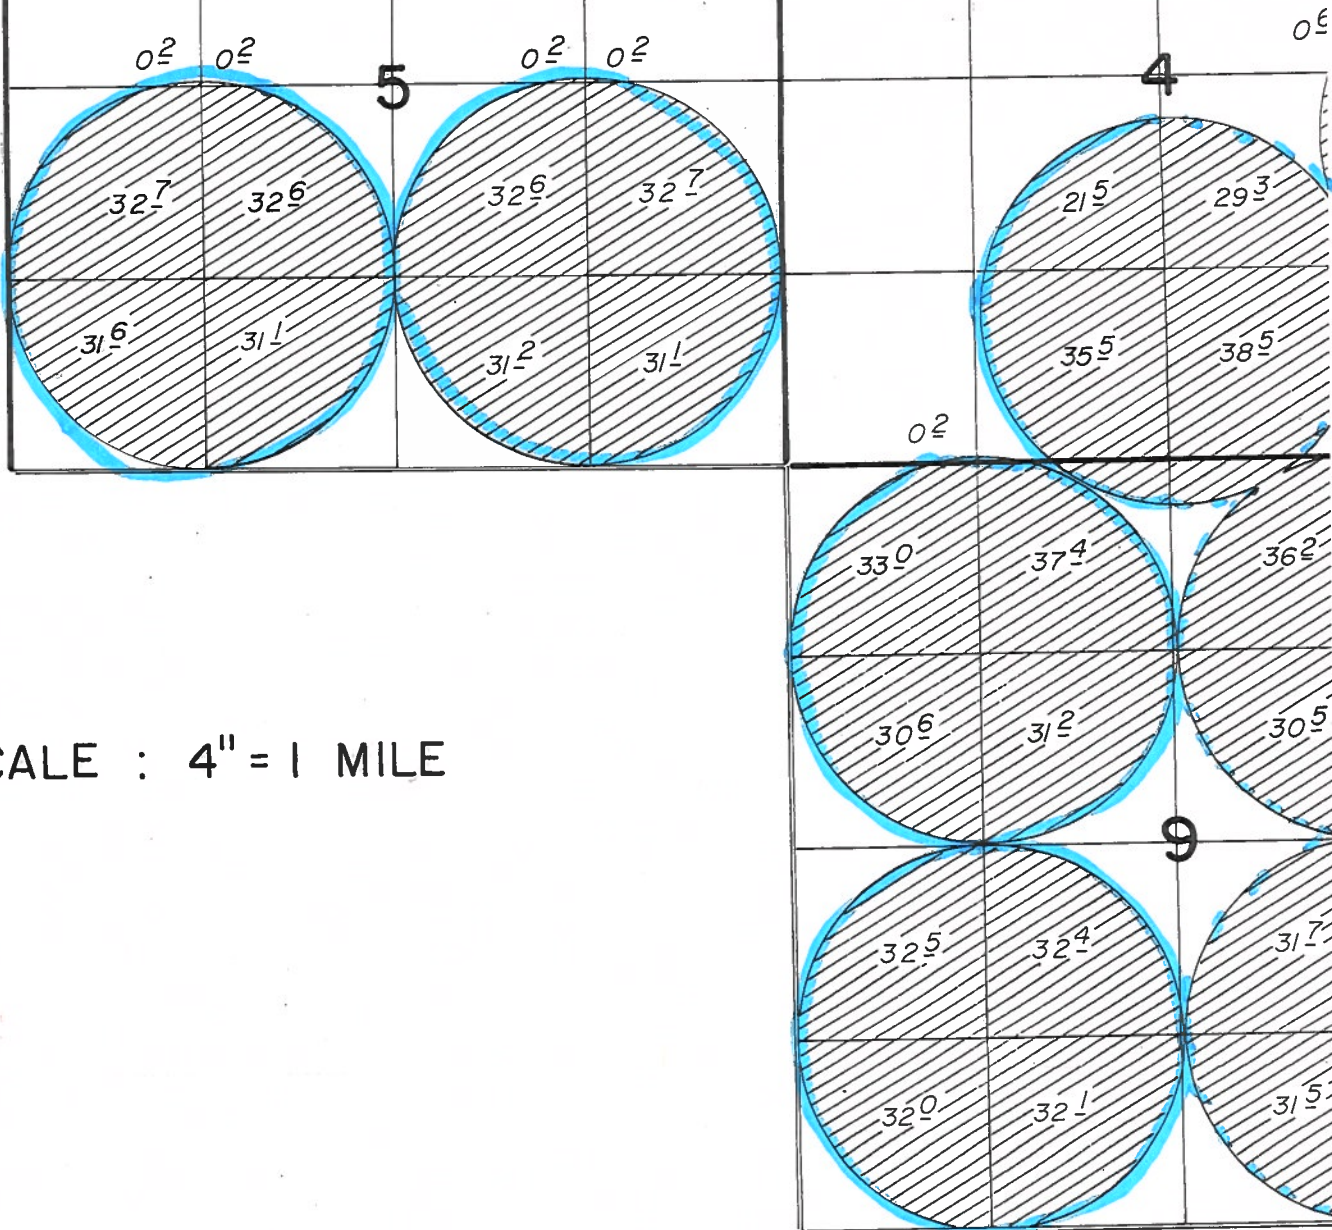

SCALE : 4" = 1 MILE

T. 4N., R. 25E., W.M.

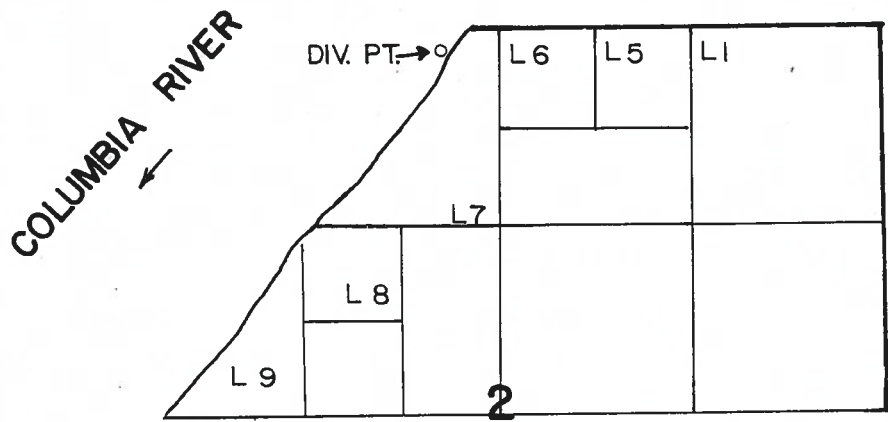

Div. Pt. Loc. : 150' S. & 2990' W. from NE Cor. Sec. 2

# FINA

APPL.


## CONNECT

FIRST |

SL

2N-26E (Supplemental IR)  
T-13266-RR-c.83517  
p.2 of 2



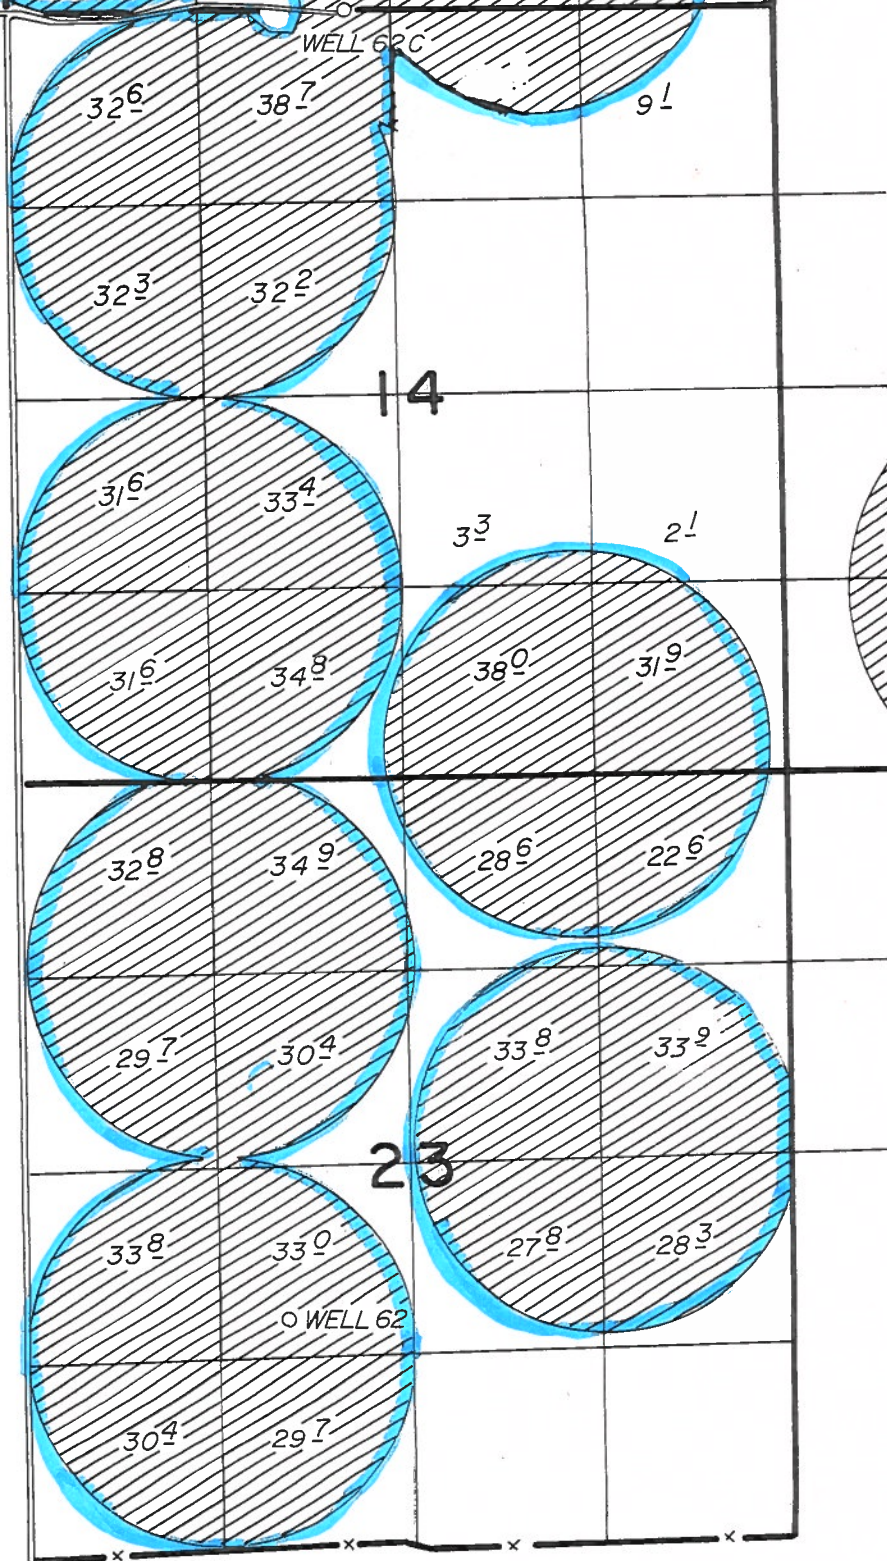

 **REPP**

## Remaining Right Supplemental