


T 5 S, R 2 W, WM

MARION COUNTY

Bourgean
DLC No. 68

TAX LOT:
5 2W 02 500
5 2W 02 600

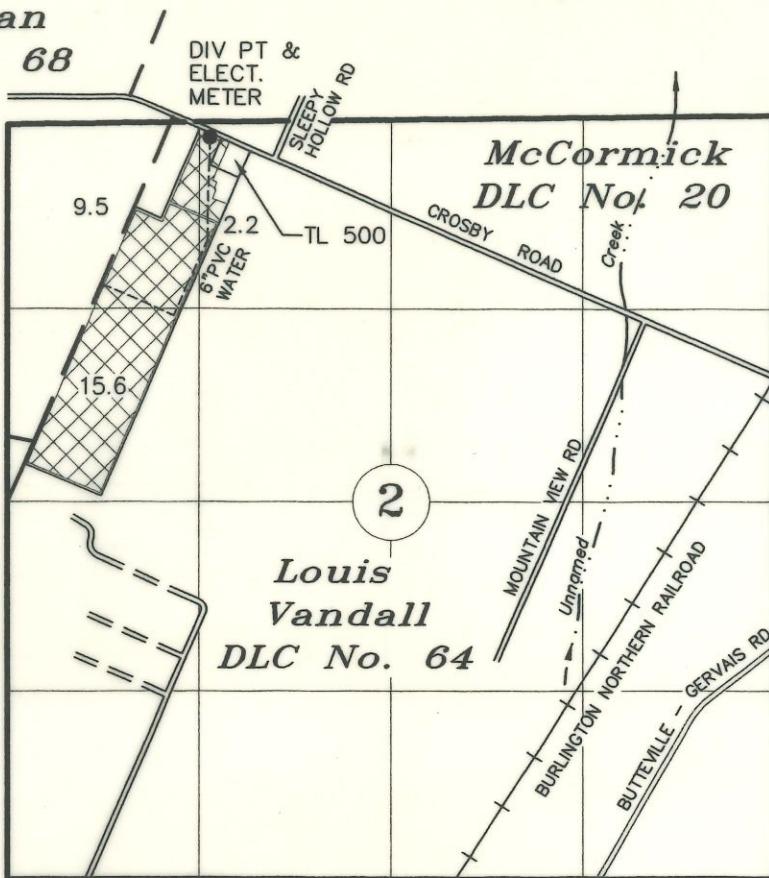

DIV. PT.: 149' S AND 246' E OF THE NW CORNER LOUIS VANDALL DLC No.64,

FINAL PROOF SURVEY

UNDER

Application No.

G-14805

Permit No.

G-13622

RECEIVED

OCT 05 2006

WATER RESOURCES DEPT.
SALEM, OREGON


IN THE NAME OF

KEVIN CROSBY

JUNE 22, 2006

SCALE: 1" = 1320'

NOTE: This map is not intended to provide legal dimensions or locations of property ownership lines.

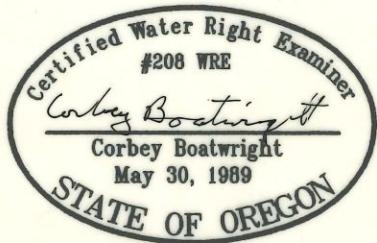

EXPIRES 12-31-07