

Zachary Welch

Mandolin Creek Pond 1, Pond 2, and Pond 3 Exhibit Map

Oct 8, 2023


Taxlot 1300, Map 11705

Reservoirs located in
the NW 1/4 of the NE 1/4 of Section 8
Township 11 South, Range 7 West, W.M.
Benton County, Oregon

Scale
330'

Legend

- Taxlot Boundary
- - - Section Boundary
- - - Dam
- 8" culvert/standpipe
- - - Emergency spillway
- ⊗ 1/4 Corner Monument
- Buildings

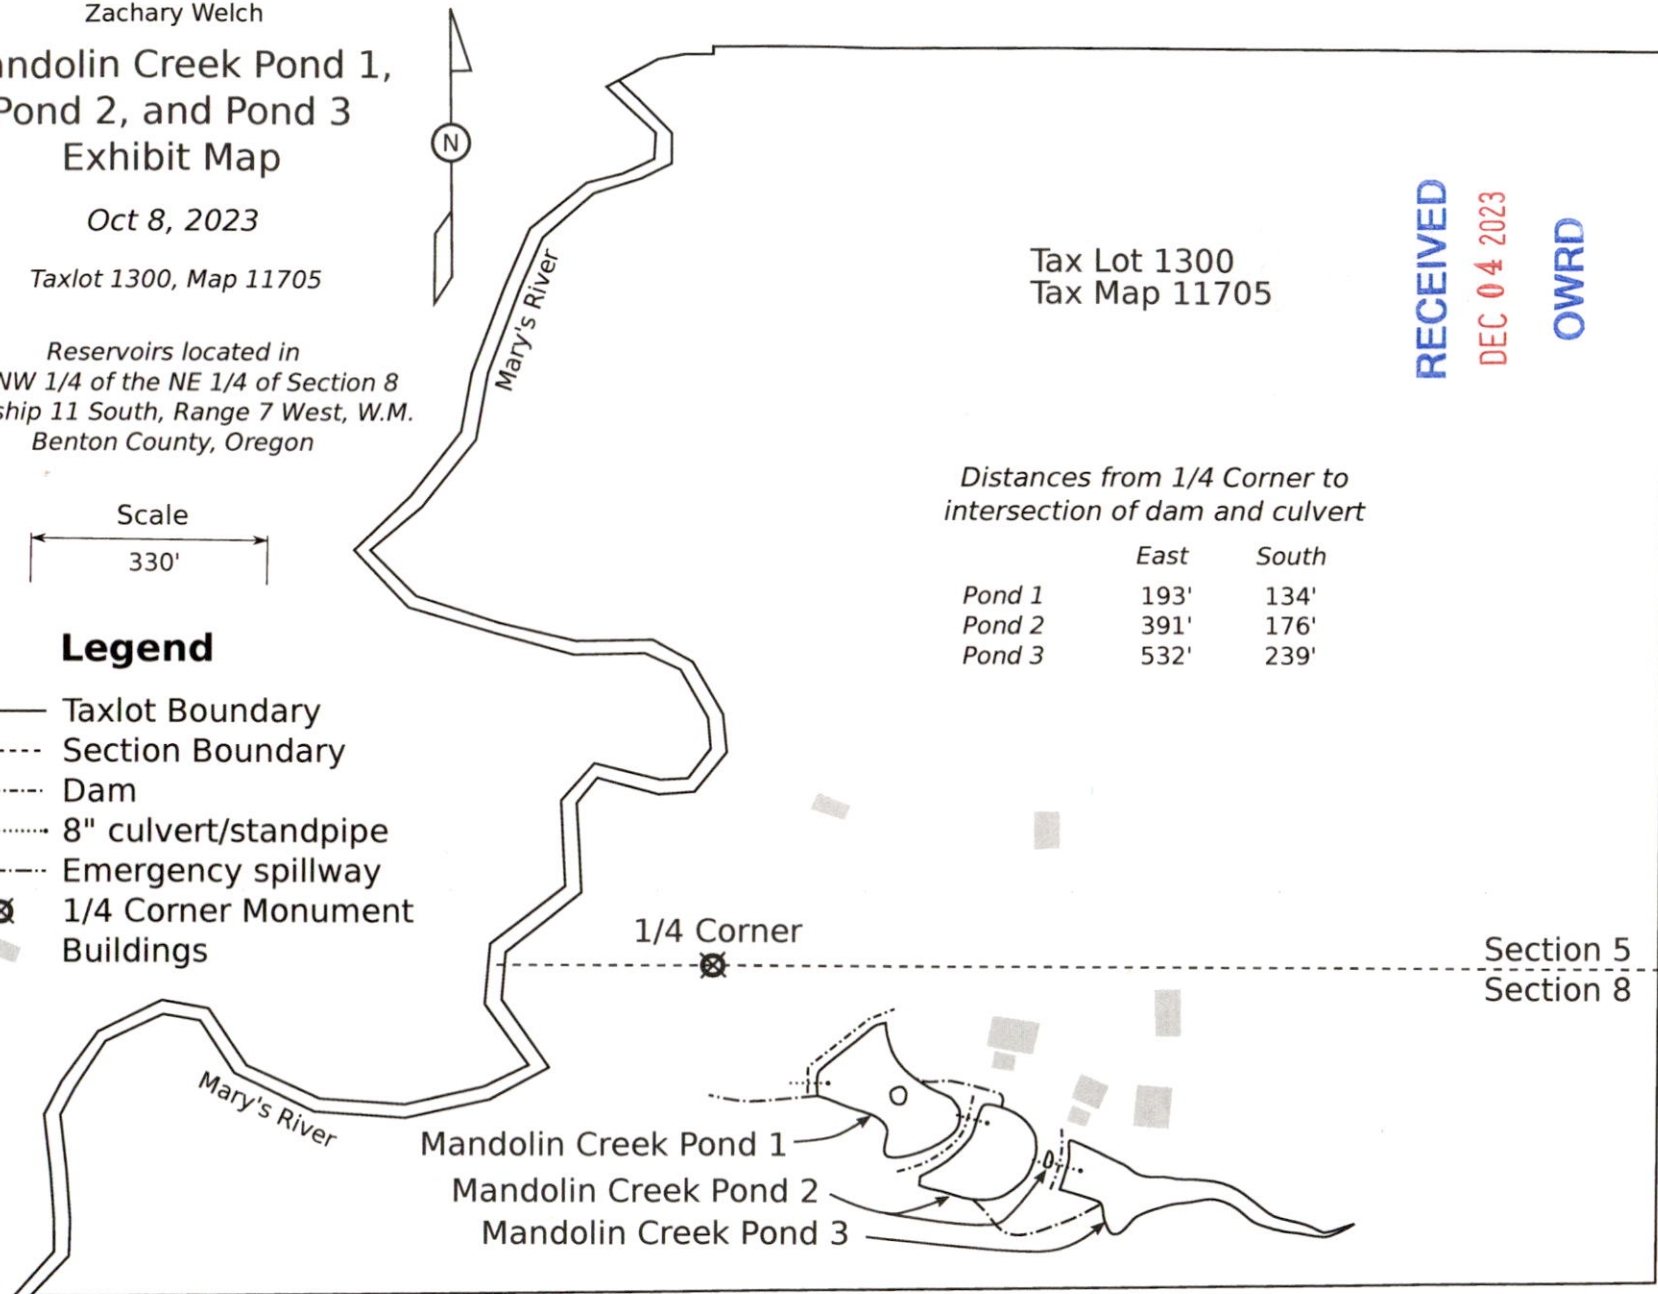

RECEIVED

DEC 04 2023

OWRD