


# Claim of Beneficial Use - Parr - Application G-17550, Permit G-17108

Township 4S, Range 2E, Section 31, W.M.

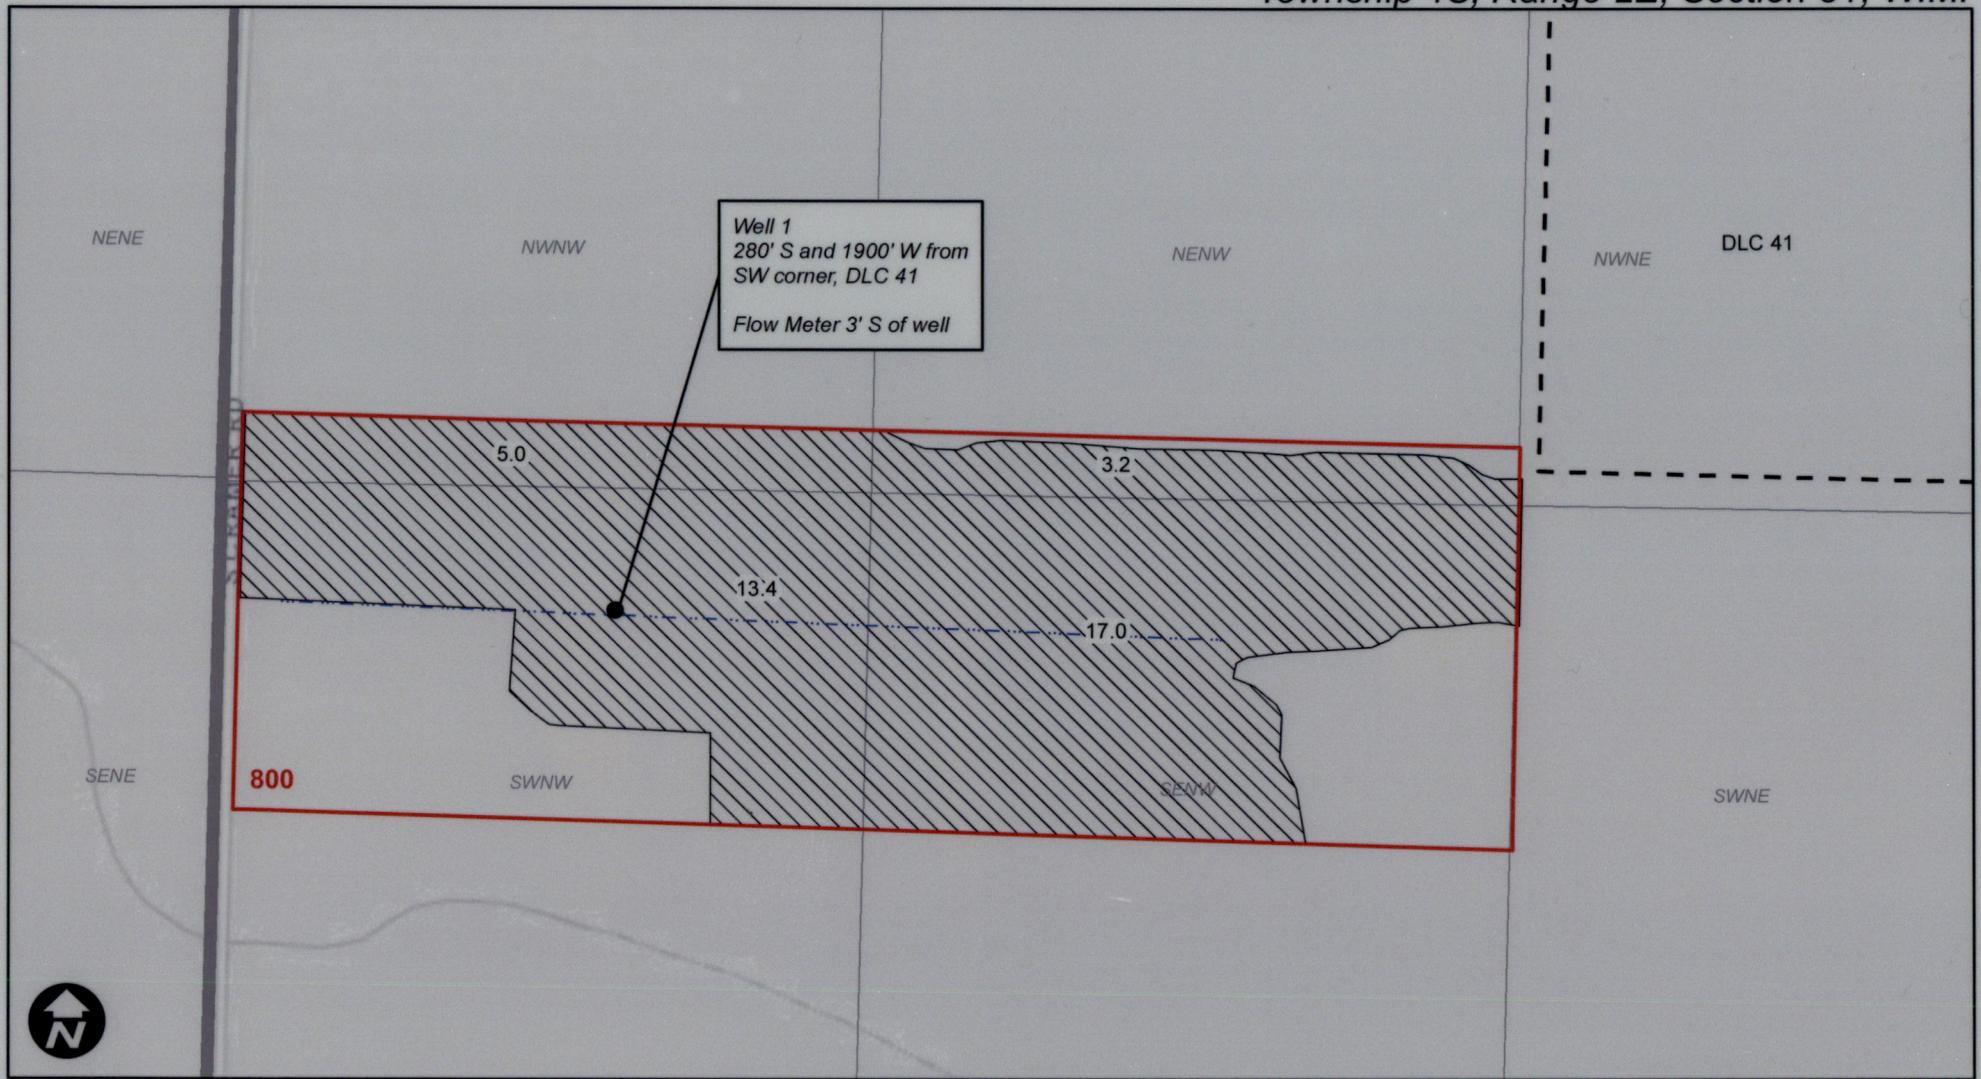

0 200 400 800 Feet

This map is not intended to provide legal dimensions or locations of property lines.

## Legend

- Developed POU
- Mainline
- Taxlot
- DLC

RECEIVED

NOV 18 2022

OWRD



EXPIRES: 12-31-2022