
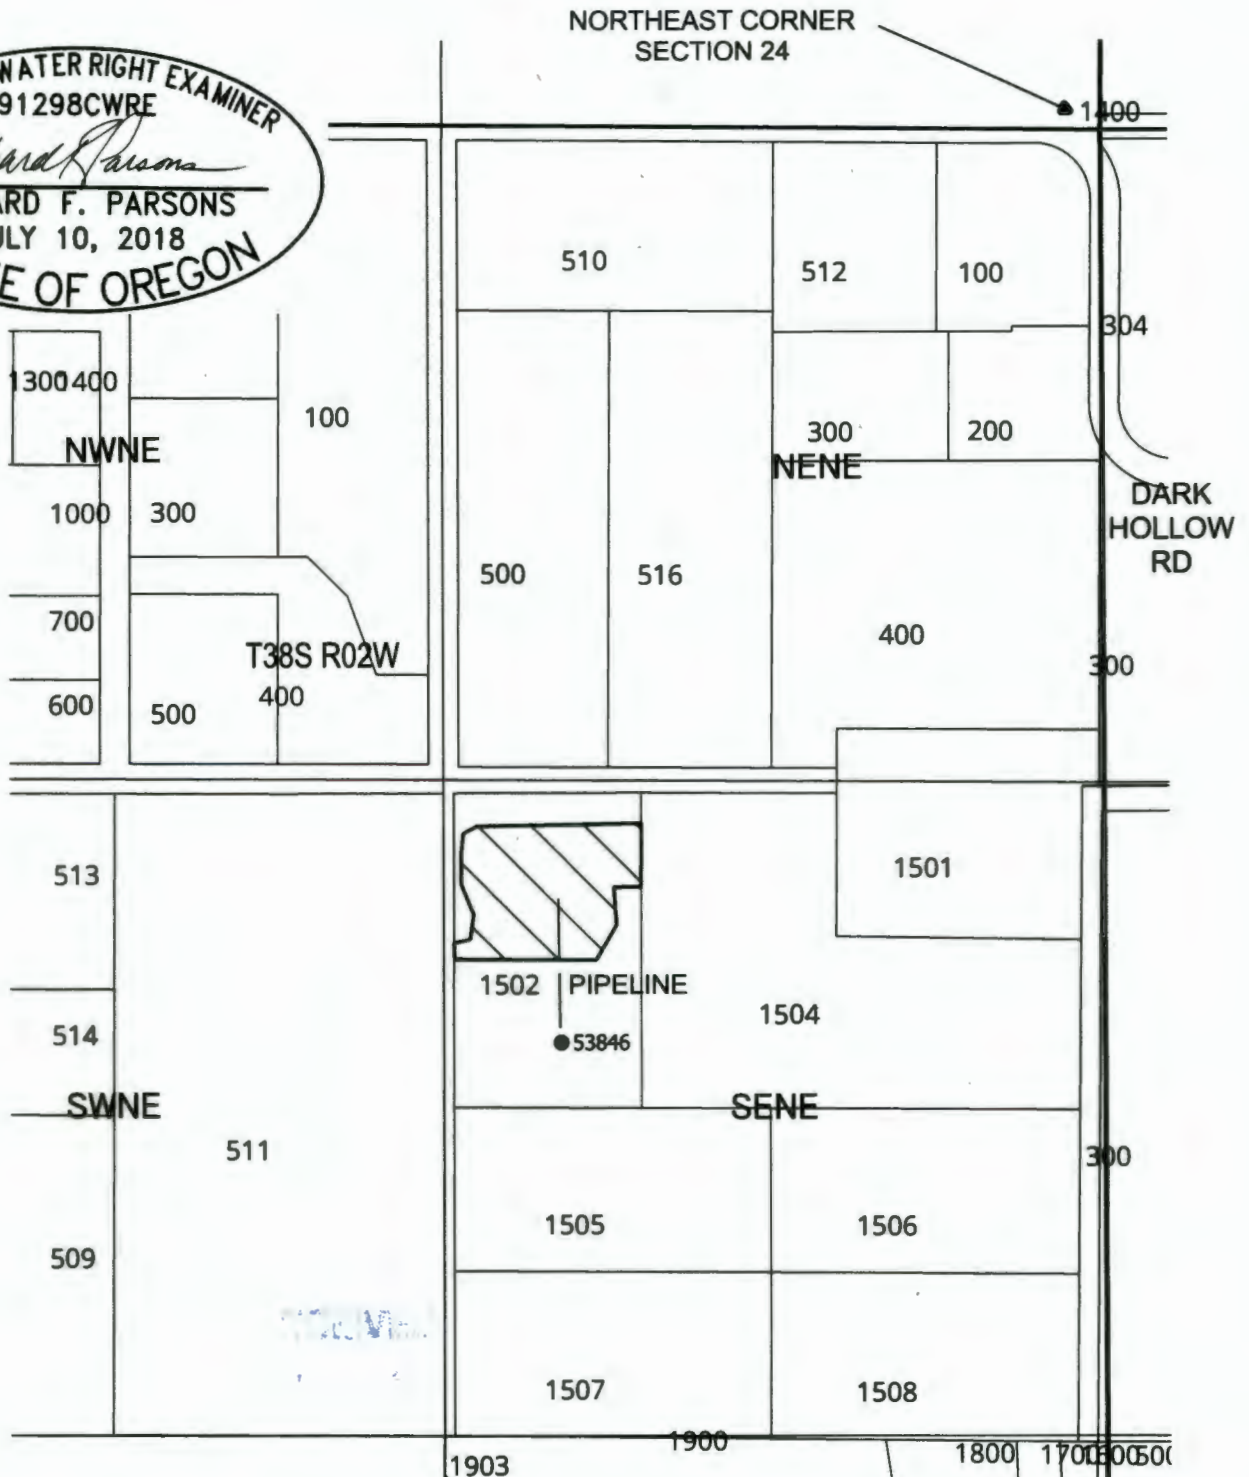


DUANE AND TERISE PAULSEN
6434 DARK HOLLOW RD
MEDFORD, OR 97501

GROUND WATER RIGHT
CLAIM OF BENEFICIAL USE
APPLICATION G-18307
PERMIT G-17976

SITUATED IN SECTION 24
TOWNSHIP 38 S
RANGE 2 W, W.M.
JACKSON COUNTY

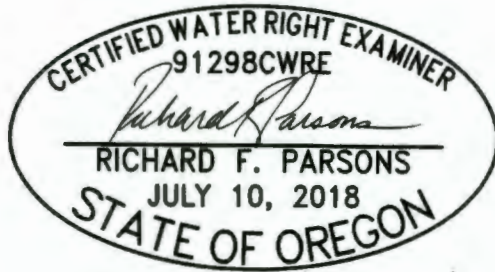

This map is not intended to provide
legal dimensions or locations of
property ownership lines

JACK 53846 and METER
1143' W 1823' S FROM
NE CORNER SECTION 24



G-17976 POU
2.0 ACS SE NE SECTION 24



1" = 400 feet

ParsonsWater Consulting LLC
rick.parsons@parsonwater.com
541.499.0257 303.667.5067