

Osprey Corner, LLC - Cert. 14428

Township 10S, Range 3W, W.M.


cancellation:
 $0.4 + 0.7 + 2.8 + 1.8 = 5.7$

Received by OWRD

APR 09 2025

Salem, OR

Cert. 14428 final proof survey incorrectly uses county road as section line. For the purposes of this voluntary cancellation/diminution and to remain consistent with the certificate, the acreages are based on the county road and lines 1320' W and S of the county road.

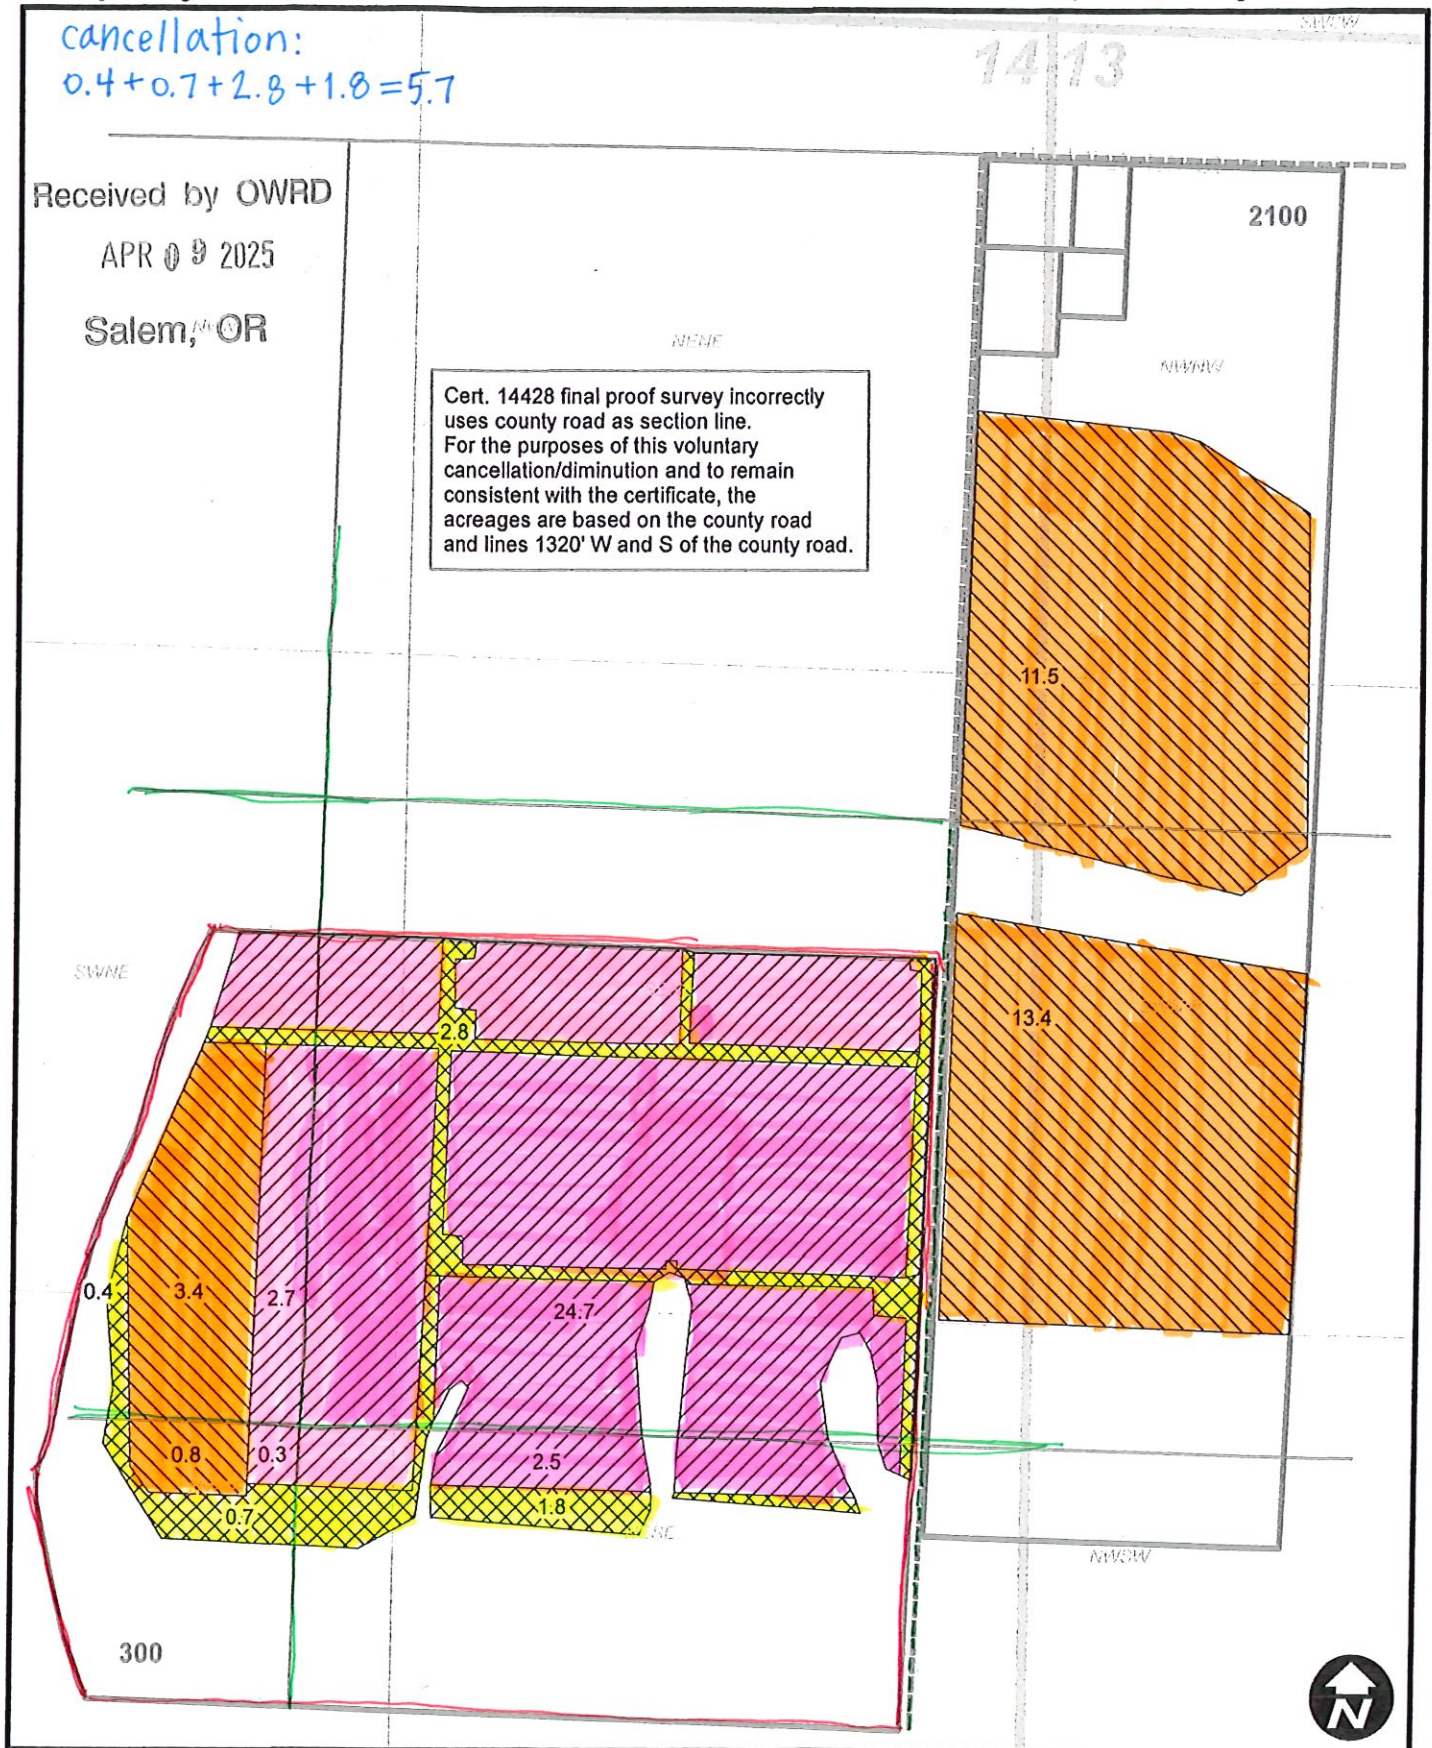

Legend

- Cert. 14428 Diminish
- Cert. 14428 No Change
- 1320' Line
- Cert. 14428 Cancel
- County Road
- Taxlot

Osprey Corner, LLC - Cert. 14428

Township 10S, Range 3W, W.M.

Received by OWRD

APR 09 2025

Salem, OR

NWNE

NENE

Cert. 14428 final proof survey incorrectly uses county road as section line. For the purposes of this voluntary cancellation/diminution and to remain consistent with the certificate, the acreages are based on the county road and lines 1320' W and S of the county road.

NWNW

SWNE

SWSE

SWNW

NWSW

SESE




Legend

- Cert. 14428 Diminish
- Cert. 14428 Cancel
- Cert. 14428 No Change
- 1320' Line
- County Road
- Taxlot

0 200 400 800 Feet

T. 10 S..R. 3 W. W.M.

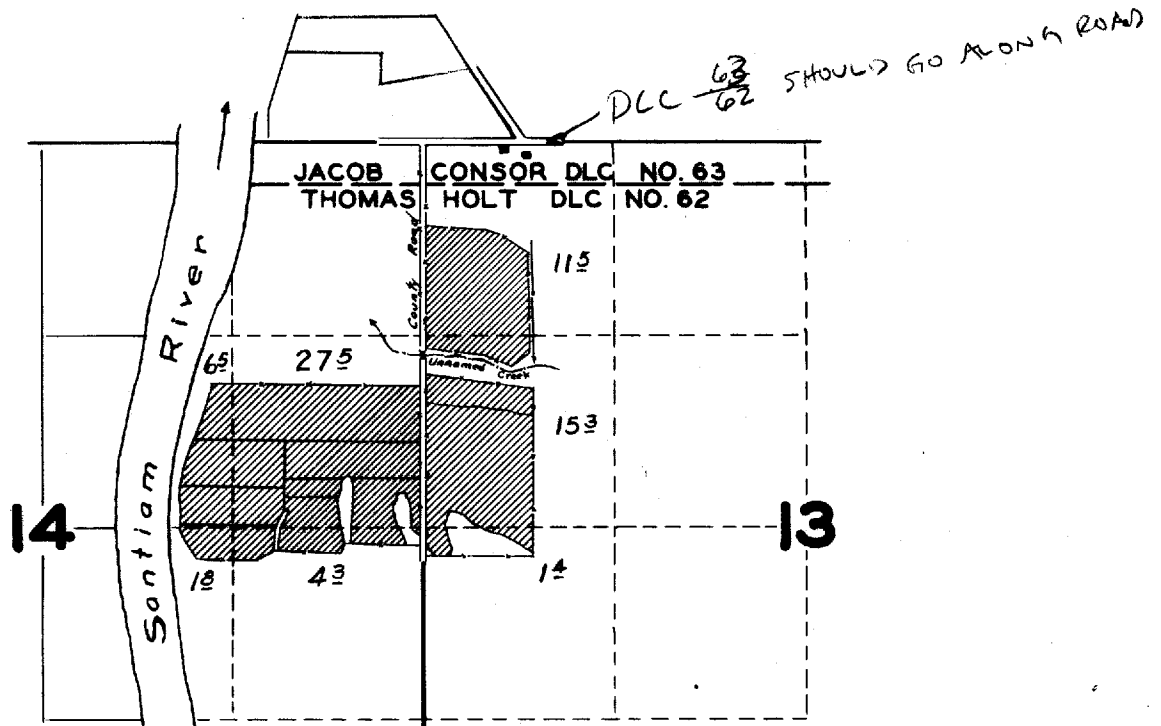

FINAL PROOF SURVEY

UNDER

Application No. 17430 Permit No. 13123

IN NAME OF

John Calahan

Surveyed July 9, 1947, by Geo. D. Naderman