


T5S, R3W WM, Sections 4 & 5
 Yamhill County, Oregon
 Application S-70109 Permit S-54760

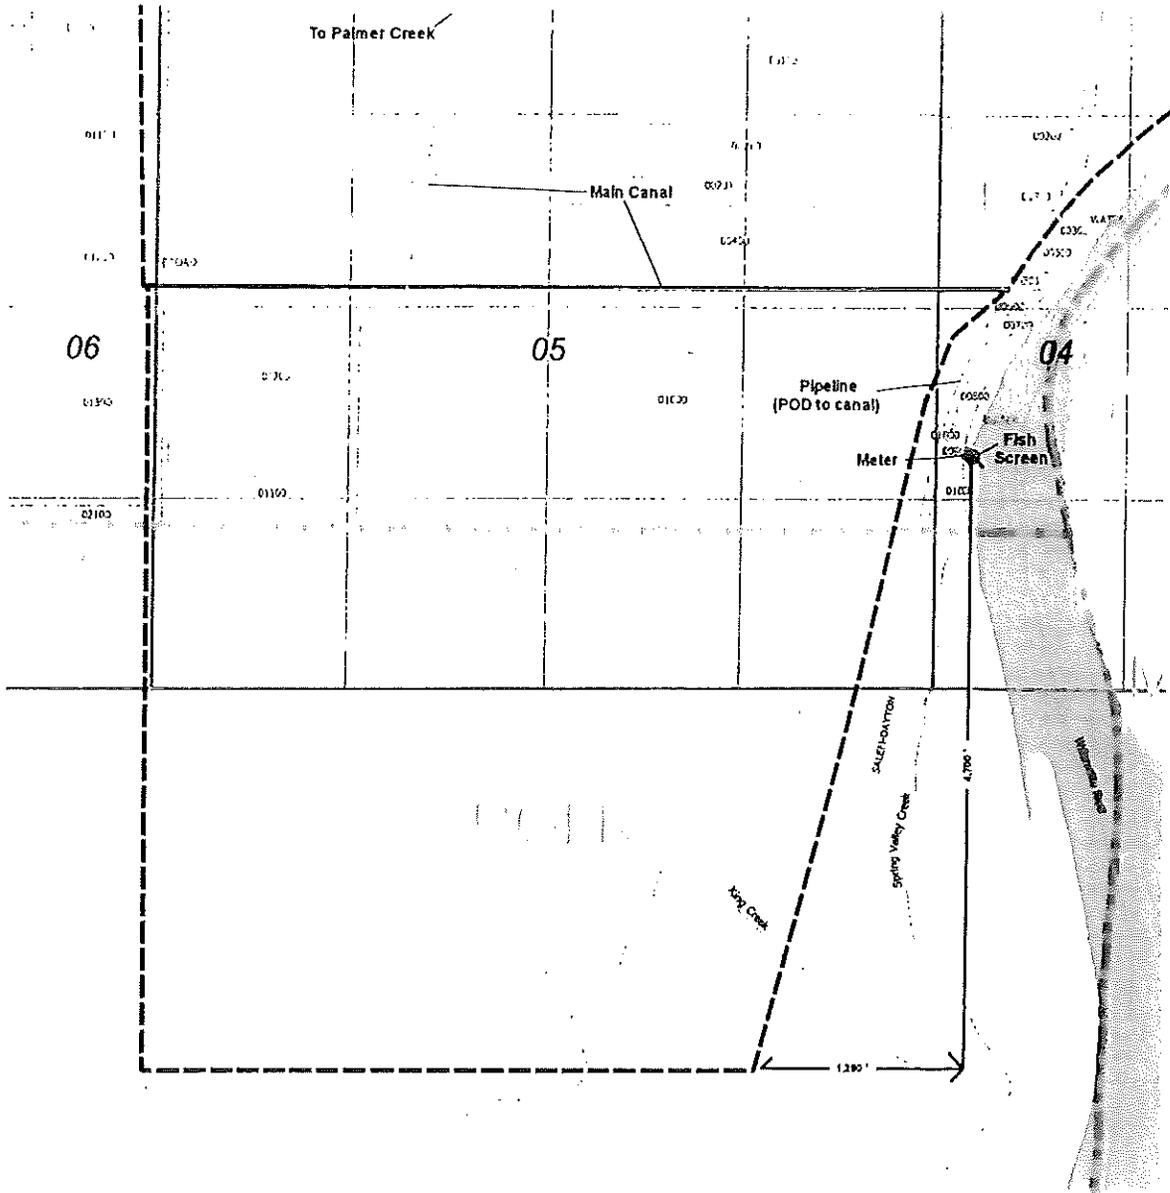

POD is located 4,700' N and 1,290' E from the SE corner of DLC 58, T6S, R3W, Sec. 4, NW 1/4 SW 1/4

0 330 660 990 1320 ft



1 inch = 1,320 feet


Explanation

- Point of diversion
- DLC
- Tax Lots
- Roads
- Streams


MAD 1983 HARN
 Datum of 1983
 Prepared August 21, 2019

Sources: BLH CadNSDI PLSS, roads, county lines & tax lots (Pacific Hydro-Geology), Oregon Spatial Data Library water features, DLC lines, et al. Locations of proposed diversions and points of use provided by client.

This map was prepared for the purpose of identifying the location of a water right only and is not intended to provide legal dimensions or locations of a property.

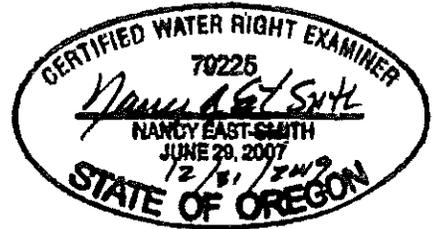


T5S, R3W WM, Section 7
 Yamhill County, Oregon
 Application S-70109 Permit S-54760

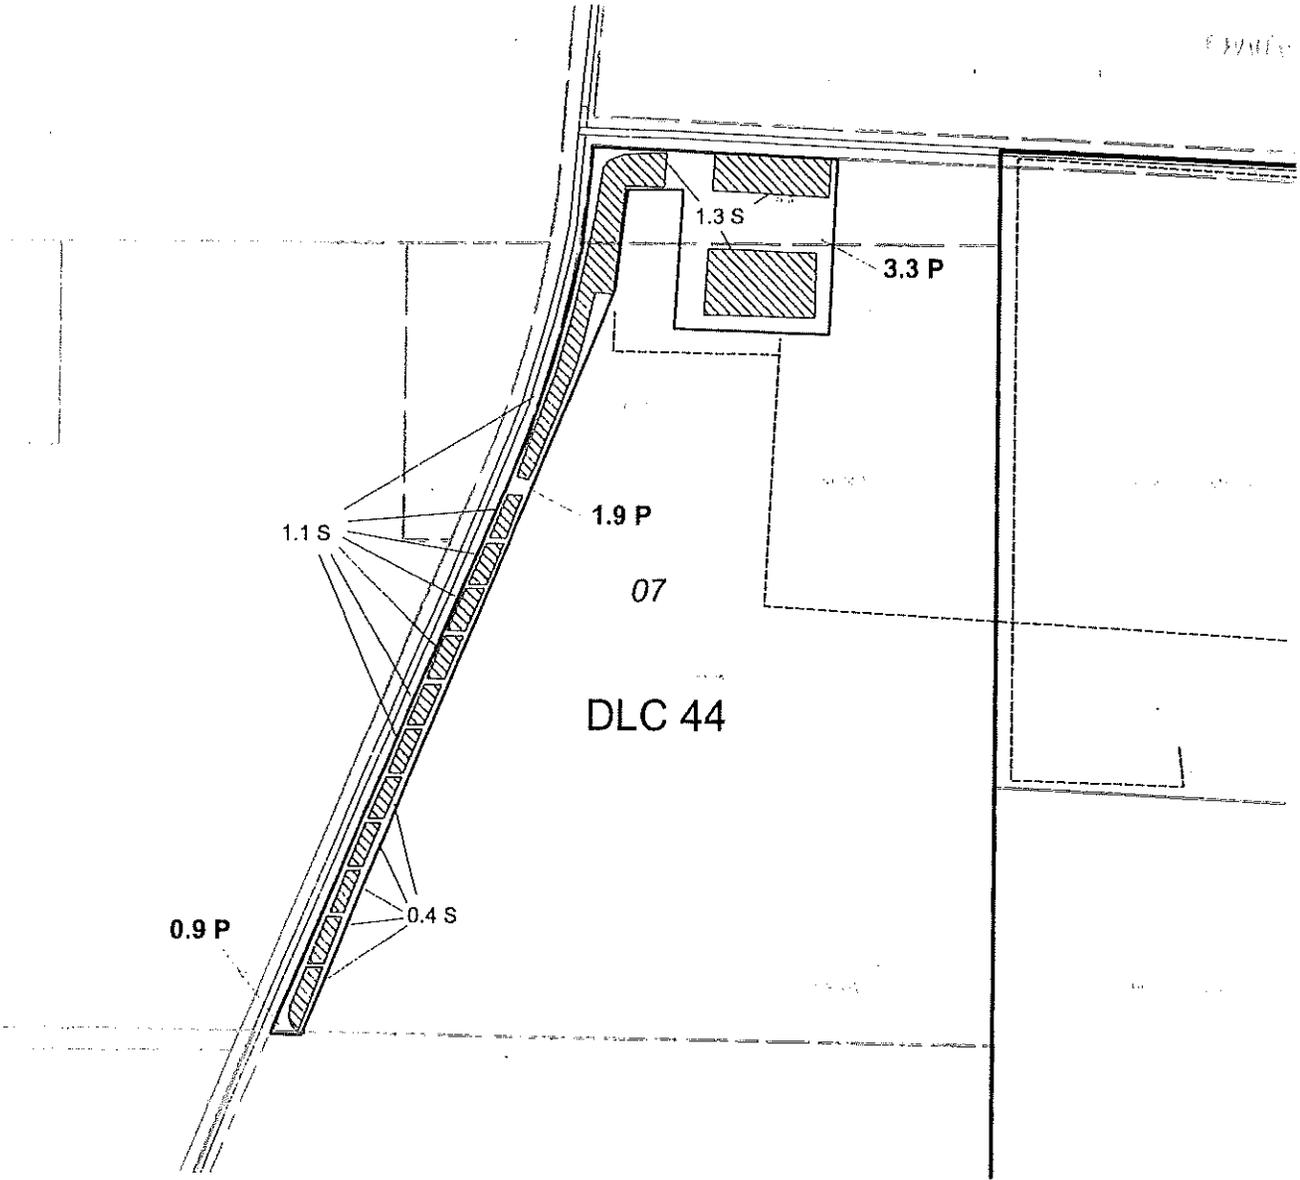

Explanation

-  Agricultural Use (Primary = 6.1 Acres)
-  Containerized Nursery Stock Irrigation (Supplemental = 2.8 Acres)
-  Donation Land Claims


County Tax Lots
 Roads

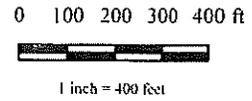

NAD 1983 HARN
 Datum of 1983
 Prepared May 13, 2025


Sources: BLM CadNSDI PLSS, roads, county lines & tax lots (Pacific Hydro-Geology), Oregon Spatial Data Library, water features, DLC lines, et al. Locations of proposed wells and points of use provided by client.

This map was prepared for the purpose of identifying the location of a water right only and is not intended to provide legal dimensions or locations of a property.

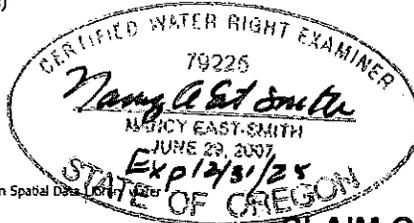

CLAIM OF BENEFICIAL USE
 Revised April 24th, 2025
 Map 2 of 3 - Place of Use Detail
 Palmer Creek Water Improvement
 District

T5S, R3W WM, Section 7
 Yamhill County, Oregon
 Application S-70109 Permit S-54760

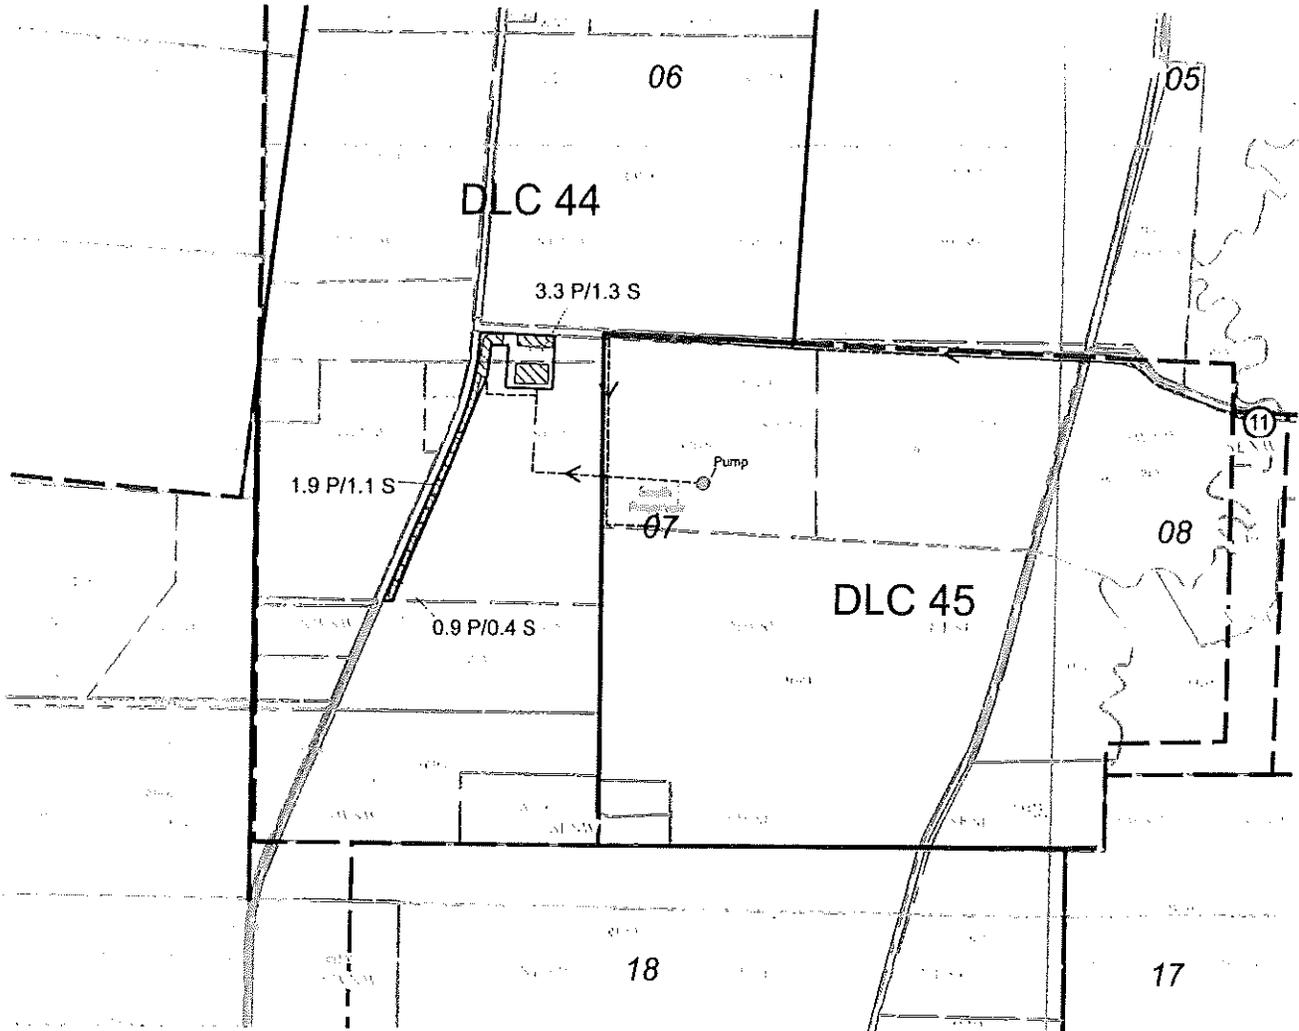

Explanation

Agricultural Use (Primary = 6.1 Acres)

Containerized Nursery Stock Irrigation (Supplemental = 2.8 Acres)

Donation Land Claims

County Tax Lots

Waterbody

Mainline Piping to Place of Use

Streams

Roads

Member Pump

Pump

NAD 1983 HARN
 Datum of 1983
 Prepared May 13, 2025


Sources: BLM CadNDSI PLSS, roads, county lines & tax lots (Pacific Hydro-Geology), Oregon Spatial Data Library water features, DLC lines, et al.

This map was prepared for the purpose of identifying the location of a water right only and is not intended to provide legal dimensions or locations of a property.

0 330 660 990 1,320 ft



1 inch = 1,320 feet

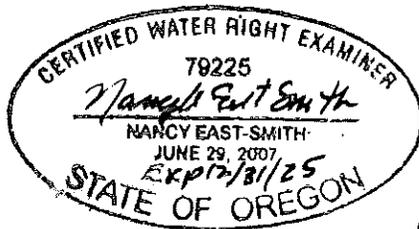

CLAIM OF BENEFICIAL USE
 Map 1 of 3
 Revised April 24th, 2025
 Palmer Creek Water Improvement
 District

EnviroLogic Resources, Inc.