


T. 1 S. R. 3 W. W. M.

Partial Cancellation Request Certificate 38755.

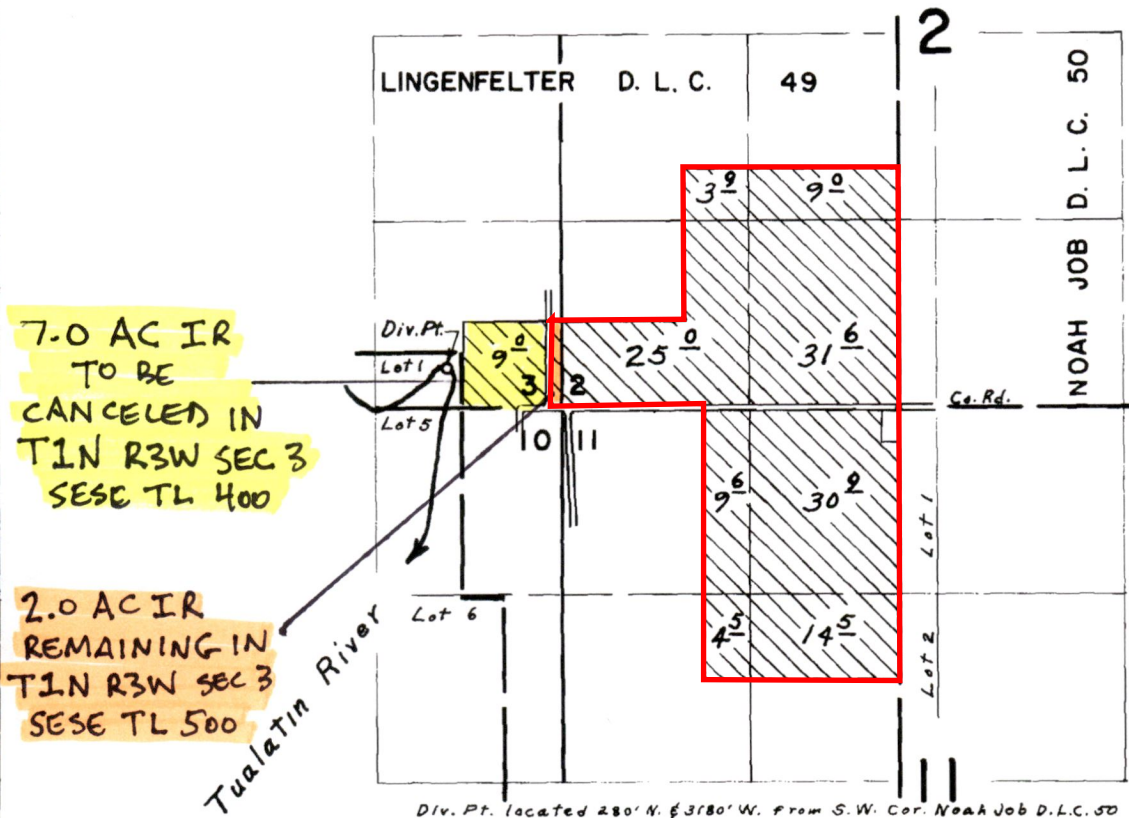

FINAL PROOF SURVEY UNDER

Application No. 41929 Permit No. 30877
IN NAME OF

DANIEL F. HERING

Surveyed April 20, 1971, by L. E. Gould

Received
MAY 15 2025
OWRD