


LEGEND

- Point of Appropriation (POA)
- ▨ Place of Use (POU)
- Property Lines
- ~ Streams
- ~ Conveyance Mains

POD Location Description

Tualatin River POD Located 900 feet South and 650 feet West from the center of Section 18 (NESW), Township 2 South, Range 1 West, W.M.

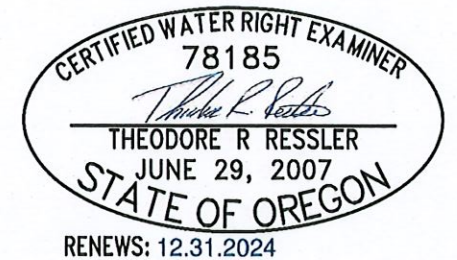

Date: 7/18/2023
Data Sources: BLM, OWRD, USGS, Washington County
Disclaimer: This map is not intended to provide legal dimensions or property ownership lines.

Claim of Beneficial Use Permit S-51982, Application S-73365

A Water Right held by AGC properties, LLC
Washington County

Received
DEC 20 2024

