


Received

JAN 06 2025

OWRD

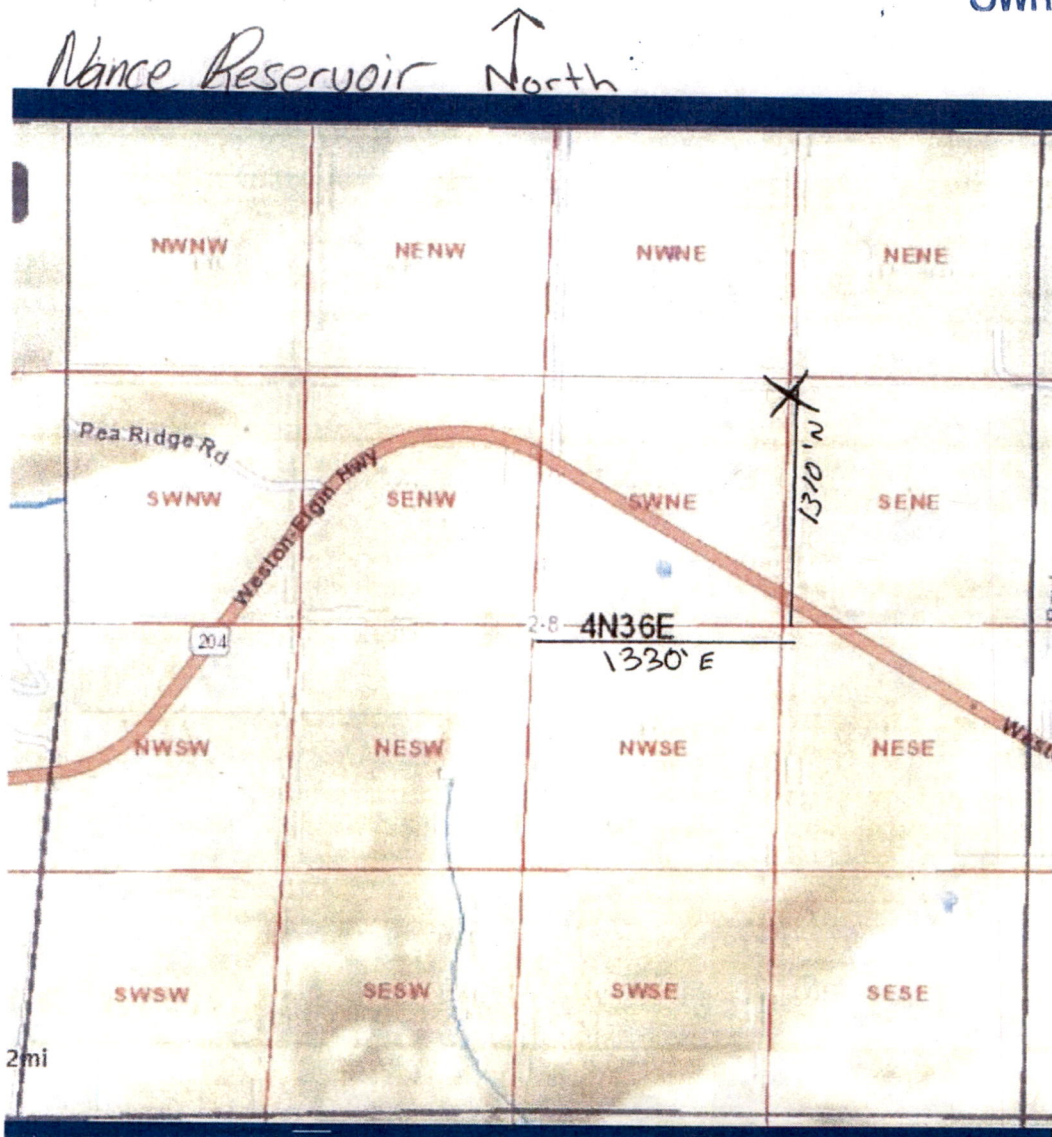

4N 36E Section 28

Scale 1" = 1,000 feet

Tax lot map attached - Tax Lot 2000

1330' E and 1310' N from Center of Section 28

4N 36E Section 28 SENE

X = Reservoir

RECEIVED

AUG 28 2019

OWRD

RECEIVED

AUG 19 2019

OWRD

Received

JAN 21 2025

OWRD

R-8873C