


# Claim of Beneficial Use Map

## Application G-13706, Permit G-18361

### Drost Land Company LLC

T 40 S, R 11 E, WM  
Sections 2 & 3

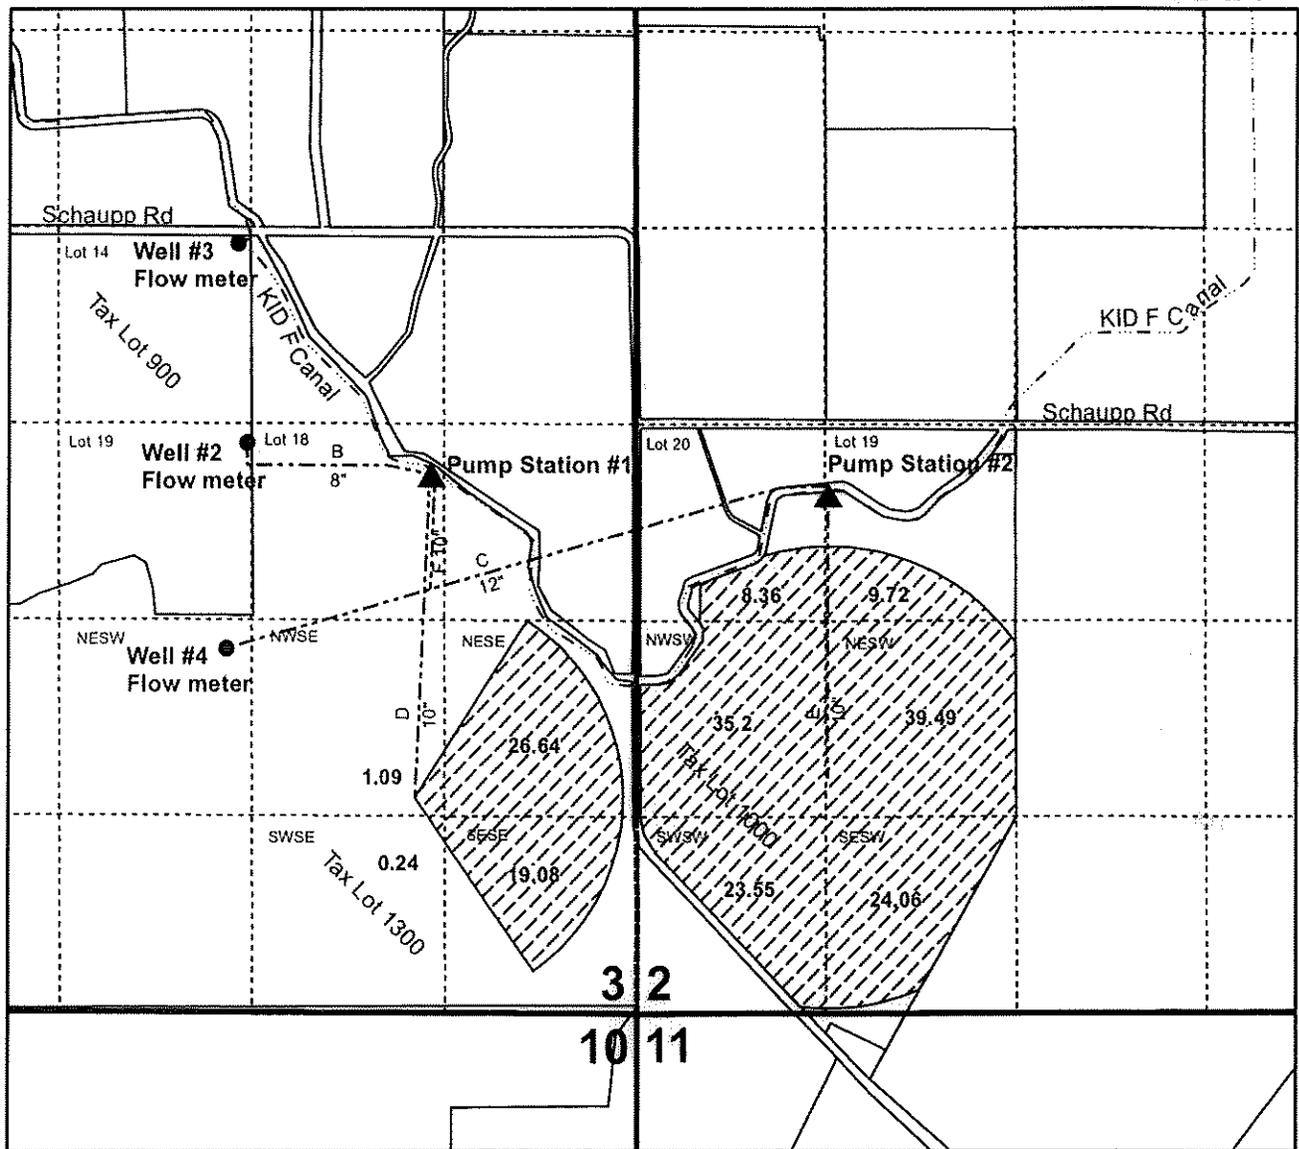

### Legend

Supplemental 187.43 ac

● Wells used

▲ Pump station

----- Pipeline




1 inch = 1,320 feet

Well #2 and Flow meter  
3960.4 ft North & 2646.5 ft West  
Fm SW Cor. Sec 2

Well #3 and Flow meter  
5328.9 ft North & 2695 Ft West  
Fm SW Cor. Sec. 2



Well #4 and Flow meter  
2550.5 ft North & 2805 ft West  
Fm SW Cor. Sec 2

All in T 40 S, R 11 E, WM

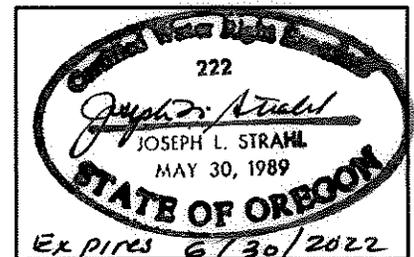


**Note:** This map is not intended to provide legal dimensions or locations of property ownership lines.

**T40S R11E, WM  
KLAMATH COUNTY, OR**

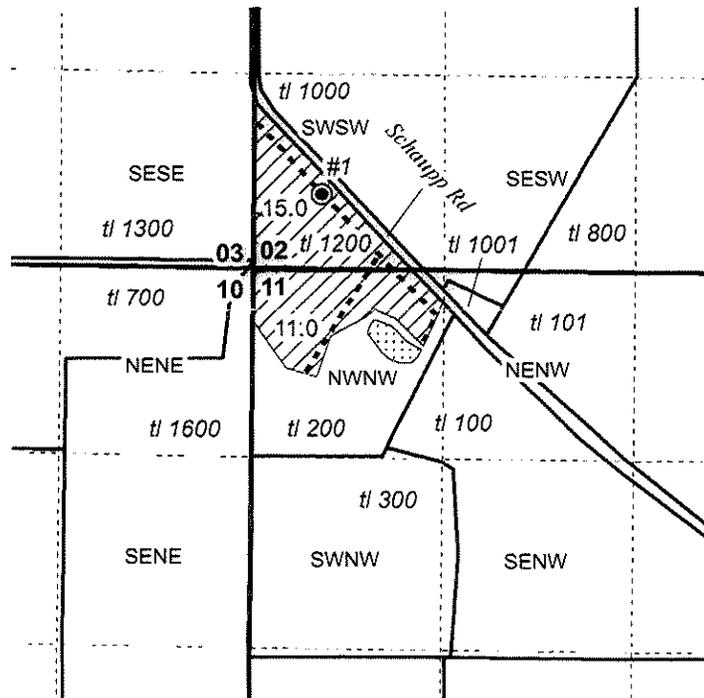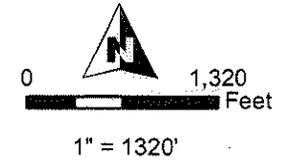

- Well & Meter
- Pipeline
- Pond
- POU Irrigation
- Section
- Tax Lot
- Quarter Quarter

**Well Location:**  
Well #1 (KLAM 10988):  
480' N, 485' E of SW Cor Sec 2

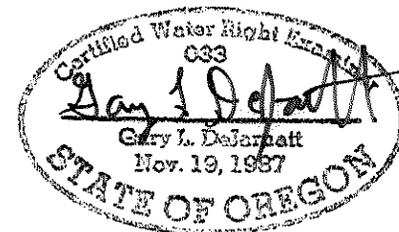

**RENEWAL DATE 12/31/2025**



**PARTIAL CLAIM OF BENEFICIAL USE MAP  
DEREK WRIGHT**

Date: 5/17/2024

A Portion of Ap G-13706/T-13237 Permit G-18361

Project #24004

This map is not intended  
to provide legal dimensions  
or locations of property  
ownership lines.

**WATER RIGHT SERVICES, LLC**  
PO BOX 1830, BEND, OR 97709  
**WWW.OREGONWATER.US 541-389-2837**  
johnshort@usa.com CCB # 197121