

LEGEND

- | | |
|--|--|
| | SECTION LINE |
| | 1/4 1/4 LINE |
| ===== | TAX LOT LINE |
| ~~~~~ | CANAL |
| ----- | BURIED PIPE |
| ----- | ABOVE GROUND PIPE |
| ----- | ROAD |
| | RAILROAD |
| ==== | RIVER |
| ----- | GLO MEANDER LINE |
| ← | FLOW DIRECTION |
| 7 8
18 17 | SECTION CORNER |
| TL
0000 | TAX LOT
NUMBER |
| W | POA (WELL) |
|  | IRRIGATED UNDER
PERMIT G-16071 |
| SENE | 1/4 1/4 SECTION |
| 28.0
LOT 5 | IRRIGATED ACRES
GOVERNMENT LOT NUMBER |
| 40.0
NENE | IRRIGATED ACRES
1/4 1/4 SECTION |

WELL LOCATIONS:

POA-1 (WELL #1) IS LOCATED IN NW1/4 SW1/4 , SECTION 17, T41S, R11W.
W.M.; 1320' NORTH & 100' EAST FROM THE SW CORNER, SECTION 17.


POA-2 (WELL #2) IS LOCATED IN SE1/4 NW1/4, SECTION 17, T41S, R11W.
W.M.: 1430' NORTH & 2430' EAST FROM THE SW CORNER, SECTION 17.

NOTES:

1. THIS MAP WAS PREPARED FROM FIELD MEASUREMENTS, NAIP 2019 AERIAL PHOTOGRAPH, OREGON GLO MAPS, KLAMATH RIVER ADJUDICATION CLAIM MAPS AND KLAMATH COUNTY TAX MAPS.
 2. THE PURPOSE OF THIS MAP IS TO IDENTIFY THE LOCATION OF THE WATER RIGHT ONLY, AND IS NOT INTENDED TO PROVIDE DIMENSIONS OR LOCATION OF PROPERTY LINES.
 3. THE PRIORITY DATE FOR THIS PERMIT IS SEPTEMBER 8, 2005.

APPLICATION

APPLICANT

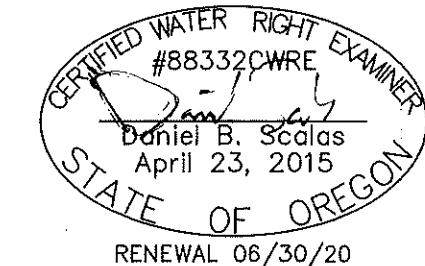

**CLAIM OF BENEFICIAL USE
AND FINAL PROOF MAP**

FOR
AUDRIC ENTERPRISES
T41S, R11E, SECS. 8, 9, 16, & 17, WM
KLAMATH COUNTY, OREGON
PERMIT No. G-16071
APPLICATION No. G-16531