



Well Locations:

Well #1 (L-94006): 2570' N, 2640' W of SE Cor Sec 1, T25S R30E, WM
 Well #2 (L-119897/HARN 52518): 2670' N, 90' W of SE Cor Sec 1, T25S R30E, WM
 Well #3 (L-109962/HARN 51942): 2760' N, 2830' E of SE Cor Sec 6, T25S R31E, WM


T25S R30E & T25S R31E, WM
 HARNEY COUNTY, OR

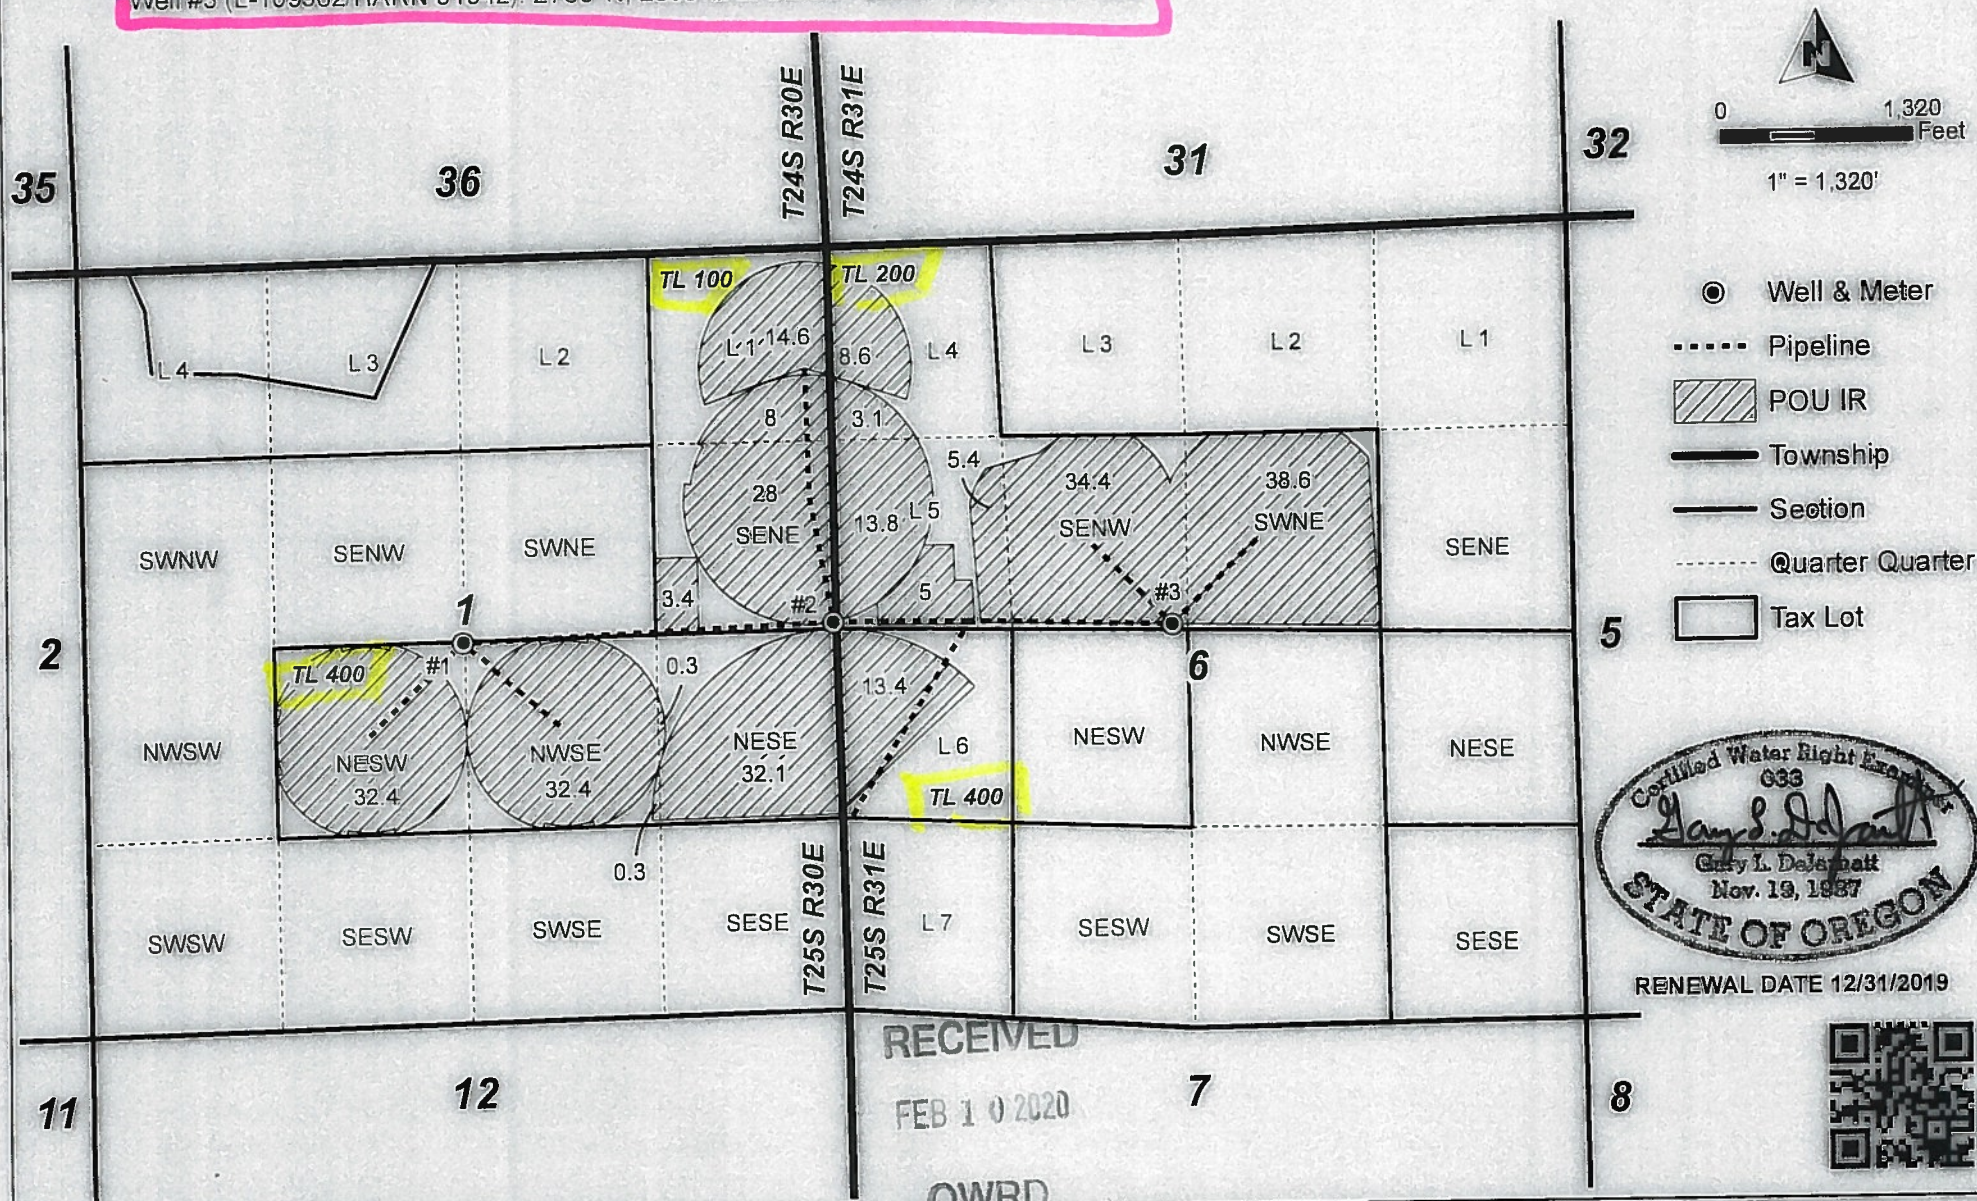

- Well & Meter
- Pipeline
- ▨ POU IR
- Township
- Section
- Quarter Quarter
- Tax Lot

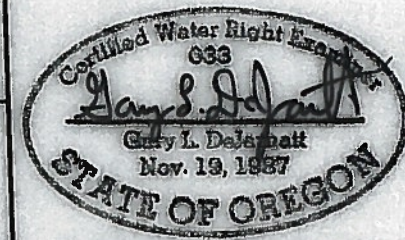

RENEWAL DATE 12/31/2019

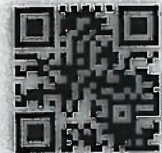

CLAIM OF BENEFICIAL USE MAP
 BRYAN AND CORISSA WRIGHT

App G-16751

Permit G-16295

Date: 12/26/2019

Project #19010

This map is not intended
 to provide legal dimensions
 or locations of property
 ownership lines.

WATER RIGHT SERVICES, LLC
 PO BOX 1830, BEND, OR 97709
 WWW.OREGONWATER.US CCB # 197121
 johnshort@usa.com 541-389-2837