


CLAIM OF BENEFICIAL USE MAP

TRANSFER: T-12966
ADDITIONAL POINT OF DIVERSION


FOR
JAMIE ERLICHT
10208 BRIARWOOD DRIVE
LOS ANGELES, CA 90077

SITUATED IN
SECTION 29, TOWNSHIP 35 SOUTH, RANGE 1 WEST, W.M.
JACKSON COUNTY, OREGON

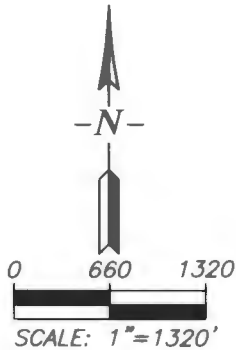

This map is not intended to
provide legal dimensions or
locations of property
ownership lines.

EHM-September 3, 2024

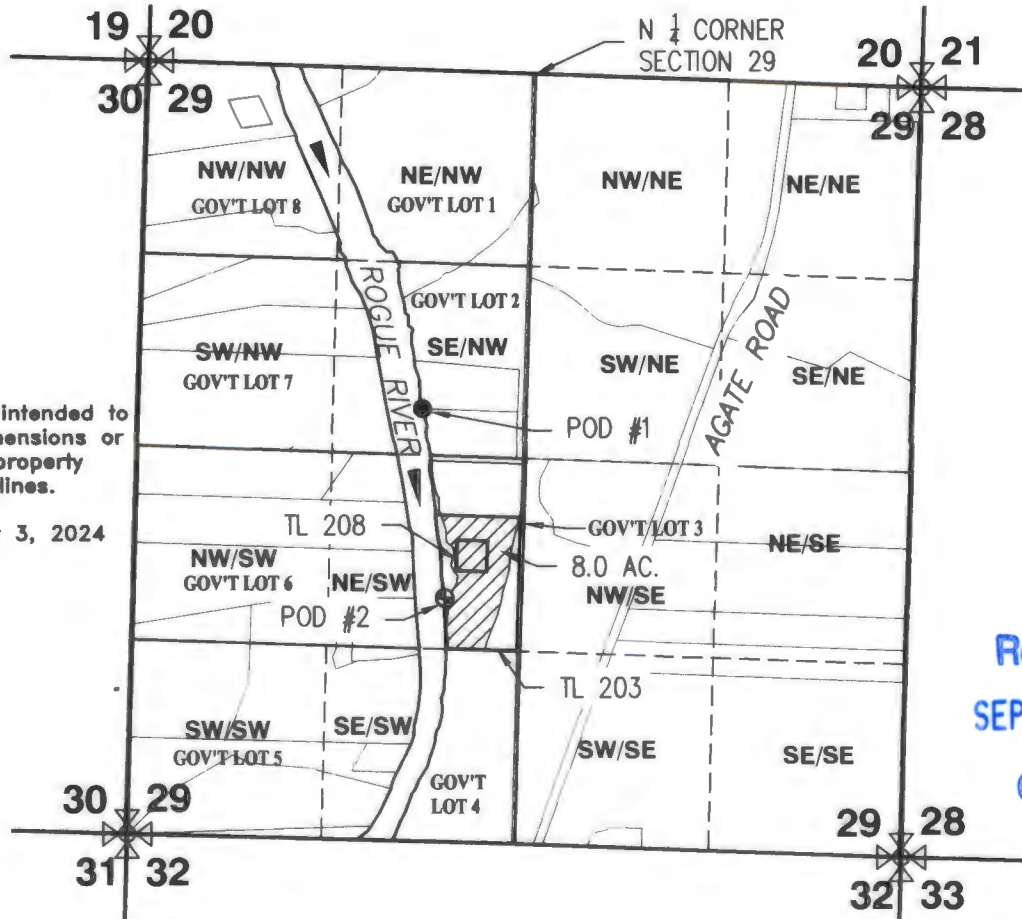

Received
SEP 13 2024
OWRD

LEGEND

- POD #1 (ORIGINAL POINT OF DIVERSION, NOT TO BE USED) 2300' SOUTH AND 680' WEST OF NORTH QUARTER CORNER SECTION 29
- ⊕ POD #2 (POINT OF DIVERSION IN USE) FISH SCREEN, PUMP AND METER LOCATED AT BANK OF RIVER. 3600' SOUTH AND 632' WEST OF NORTH QUARTER CORNER SECTION 29

 PLACE OF USE - IRRIGATION
----- 1/4-1/4 SECTION LINE



RENEWS: 12/31/2024

ROGUE CIVIL LLC
emalepsy@roguecivil.com 541-621-2868

WATER RIGHT TRANSFER APPLICATION MAP

CERTIFICATES: 43573 - PRIORITY DATE 12/15/1919

43575 - PRIORITY DATE 3/24/1942

ADDITIONAL POINT OF DIVERSION

FOR

JAMIE ERLICHT


10208 BRIARWOOD DRIVE

LOS ANGELES, CA 90077

SITUATED IN


SECTION 29, TOWNSHIP 35 SOUTH, RANGE 1 WEST, W.M.

JACKSON COUNTY, OREGON

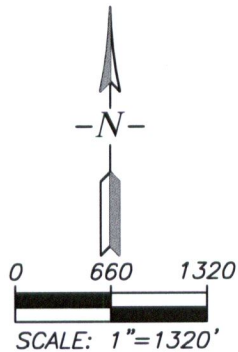

This map is not intended to provide legal dimensions or locations of property ownership lines.

EHM-June 19, 2018

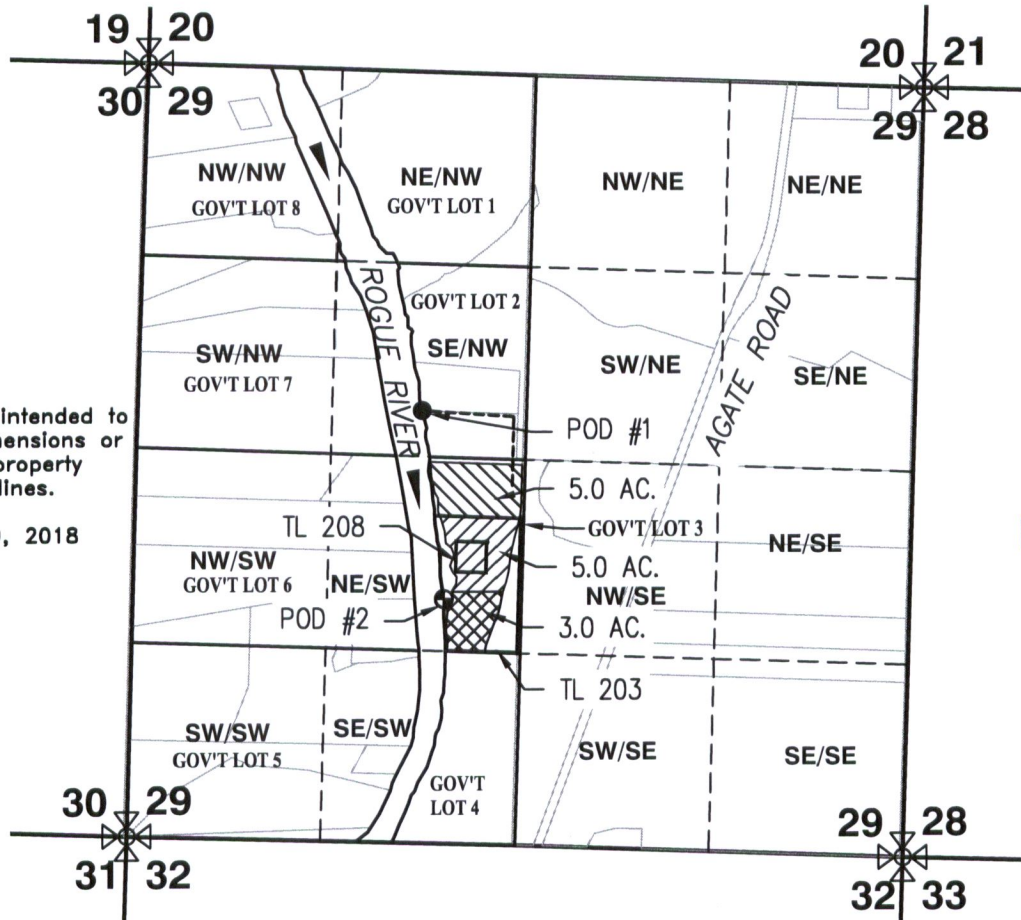

RECEIVED


JUL 06 2018

OWRD

LEGEND

- POD #1 (EX. POINT OF DIVERSION CERT'S 43573 & 43575) 2300' SOUTH AND 680' WEST OF NORTH QUARTER CORNER SECTION 29
- POD #2 (ADDITIONAL POINT OF DIVERSION CERT'S 43573 & 43575) 3600' SOUTH AND 632' WEST OF NORTH QUARTER CORNER SECTION 29

-  PLACE OF USE CERT. 43573 - NO CHANGES
-  PLACE OF USE CERT. 43573 - ADDITIONAL POD
-  PLACE OF USE CERT. 43575 - ADDITIONAL POD
- 1/4-1/4 SECTION LINE
- EX. WATERLINE (APPROXIMATE)

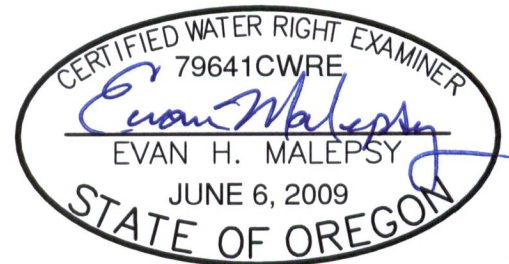

RENEWES: 12/31/2018

ROGUE CIVIL LLC
emalepsy@roguecivil.com 541-621-2868