

YONNA DRIVE

WILDHORSE CREEK

8" GATED PIPE

DRIVEWAY

RITTER ROAD

BURIED 6" PIPE
WITH RISERS

DIRT ROAD

FLOW METER

POA-1

TL 701

TL 500

TL 300

TL 500

TL 301

8.9
SE1W

30.5
NWSE

0.8
SWNE

ABOVE GROUND 6"
PIPE WITH RISERS



LEGEND

- SECTION LINE
- 1/4 1/4 LINE
- TAX LOT LINE
- CREEK
- GATED PIPE
- BURIED PIPE
- ROAD


- SECTION CENTER
- TAX LOT NUMBER
- POA (WELL)
- IRRIGATED ACRES
- IRRIGATED ACRES
- 30.5 NWSE 1/4 1/4 SECTION

RECEIVED BY OWRD

MAY 18 2016

SALEM, OR

Jeremiah Geaney
APPLICANT

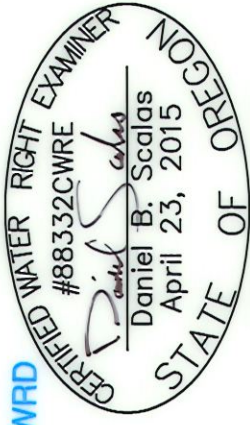

RENEWAL 06/30/16

WELL TIES

POA-1 WELL: 2690' NORTH & 2670' WEST FROM THE SOUTHEAST CORNER OF SECTION 6.

NOTES

- THIS MAP WAS PREPARED FROM FIELD MEASUREMENTS, 2005 NAIP AERIAL IMAGERY, AND KLAMATH COUNTY TAX MAP T38S, R11E, SEC. 6.
- THIS MAP IS FOR THE PURPOSE OF IDENTIFYING THE LOCATION OF THE WATER RIGHT ONLY AND IS NOT INTENDED TO PROVIDE LEGAL DIMENSIONS OR LOCATION OF PROPERTY OWNERSHIP LINES.
- FOR TAX LOT INFORMATION, SEE TAX MAP INCLUDED WITH THIS COBU.
- DATE OF PRIORITY FOR THIS CLAIM IS JUNE 19, 1995.

ADKINS



CONSULTING
ENGINEERING, LLP
2950 Shasta Way • Klamath Falls, Oregon 97603 • (541) 884-4666 • FAX (541) 884-5335
Oregon • California

**CLAIM OF BENEFICIAL USE
AND FINAL PROOF MAP**

FOR
JEREMIAH GEANEY
T38S, R11E, SEC. 6, W.M.
KLAMATH COUNTY, OREGON
APPLICATION No. G-14100
PERMIT No. G-12859