

CLAIM OF BENEFICIAL USE MAP


Received by OWRD

SECTION 9, TOWNSHIP 17 SOUTH, RANGE 21 EAST,
WILLAMETTE MERIDIAN, CROOK COUNTY, OREGON.
APP.# R-88155 PERMIT# R-15589

FEB 29 2024

Salem, OR

NOTE:
THIS MAP IS NOT INTENDED TO PROVIDE
LEGAL DIMENSIONS OR LOCATIONS OF
PROPERTY OWNERSHIP LINES.

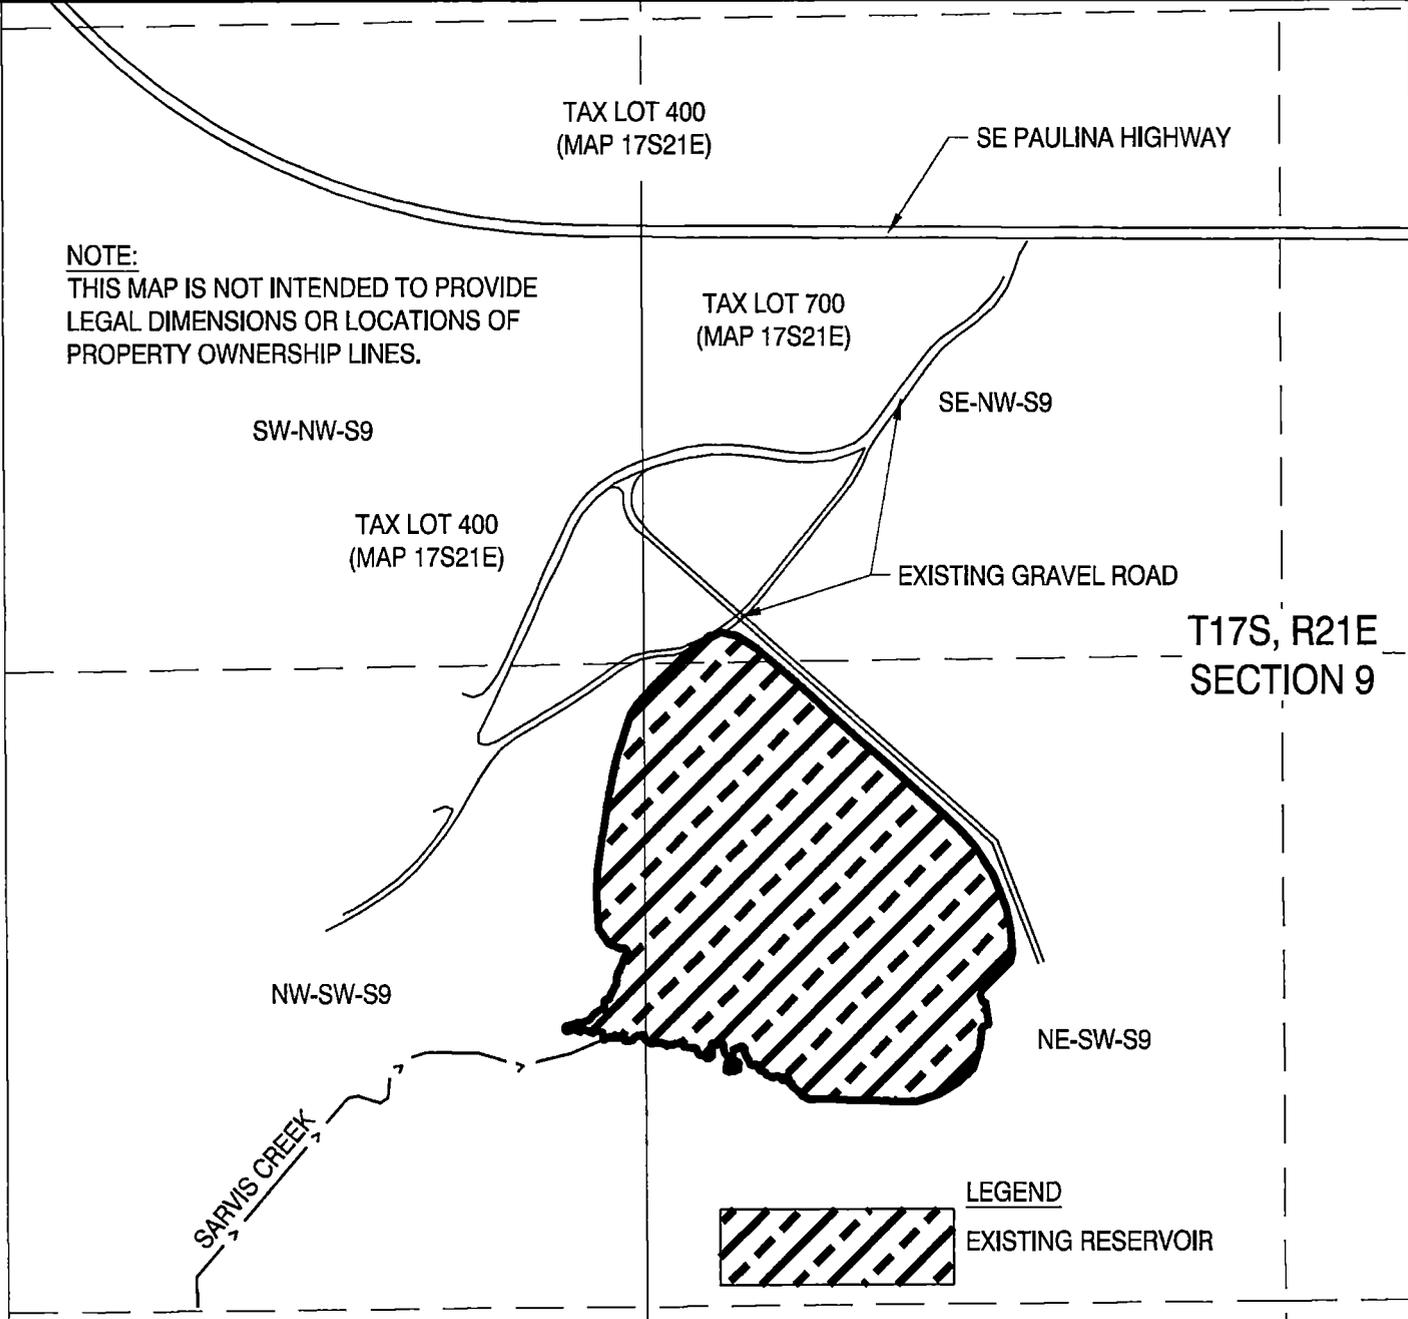

H.A. McCOY
ENGINEERING & SURVEYING LLC

1180 SW LAKE ROAD SUITE 201
REDMOND, OR 97756
(541) 923-7554

SCALE: 1" = 400'
FOR 8.5"x11" SHEETS



LEGEND

EXISTING RESERVOIR



EXP 12/31/2024

PROJECT: SARVIS DAM

DRAWN BY: JJW DATE: 02/28/2024 PAGE 1 OF 1 PROJECT#: 18-044