


T.4S. R.1W. Section 19, W.M.

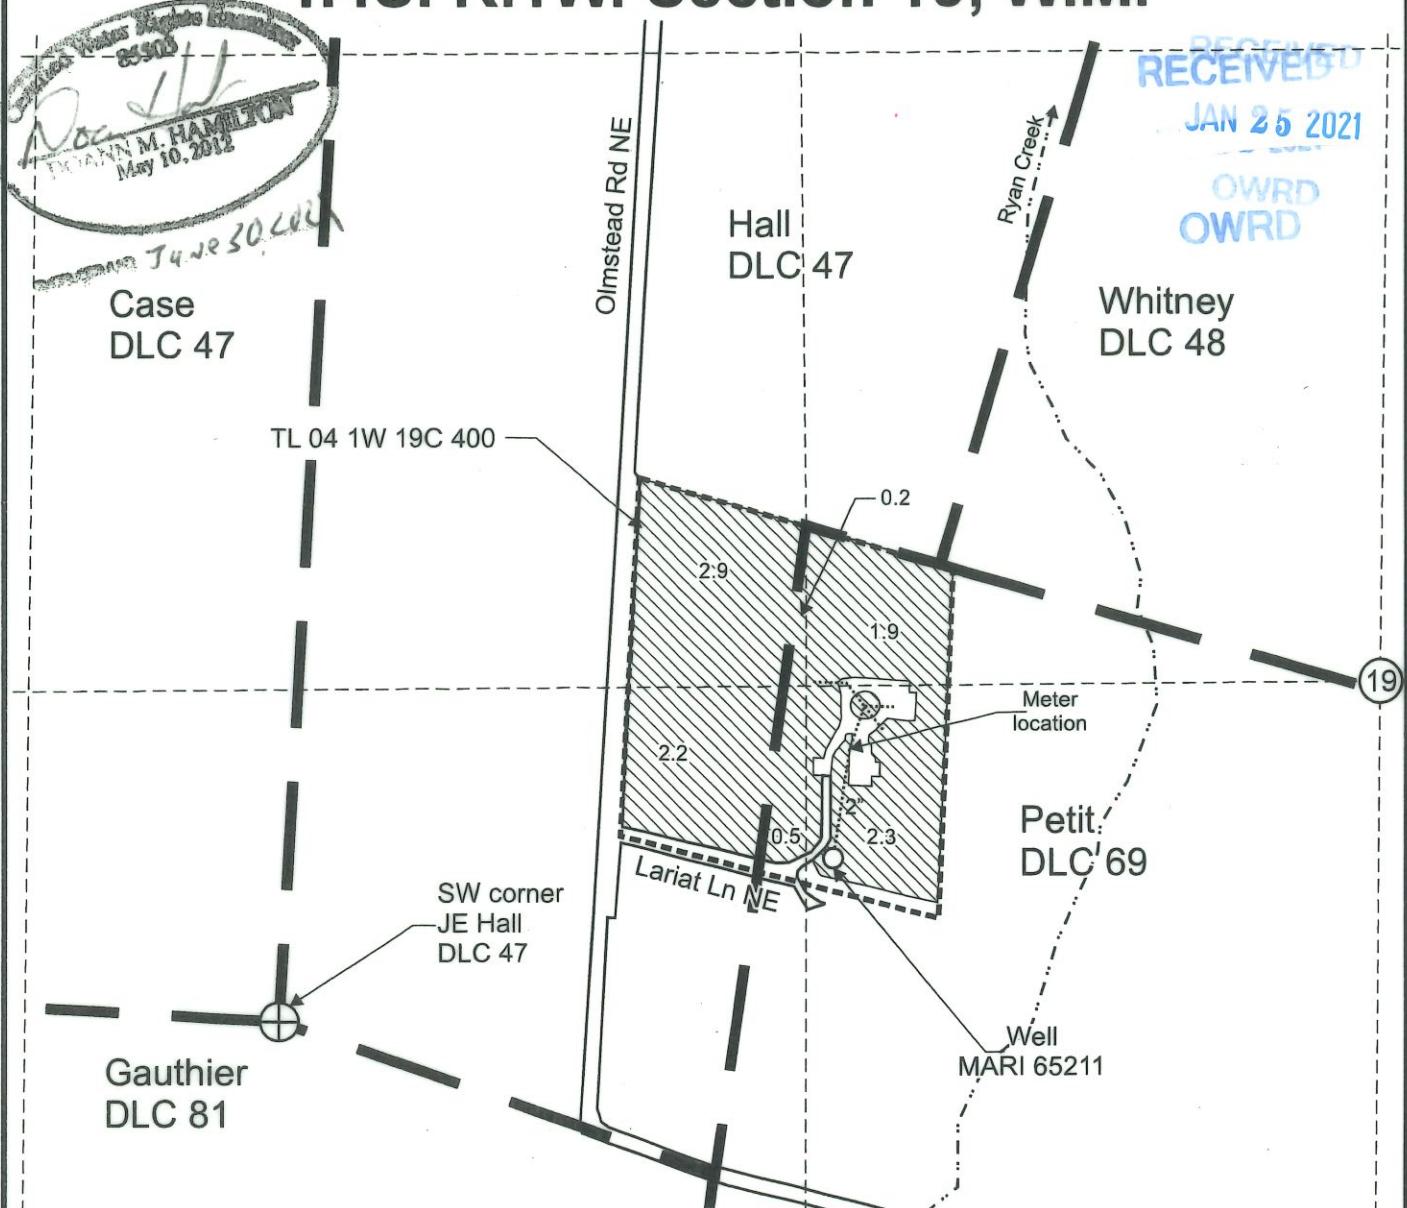

RECEIVED
JAN 25 2021

OWRD
OWRD



Well (MARI 65211) is located 340 feet north and 1,145 feet east from the SW corner, JE Hall DLC 47.


■ Area (10.0 Acres) irrigated under Application G-17716, Permit G-17155.

----- Tax lot boundary

— Donation Land Claim boundary

..... Water main line

Scale: 1" = 400'

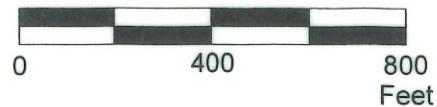

This map was prepared for the purpose of identifying the location of a water right only and is not intended to provide legal dimensions or location of property ownership lines.



Claim of Beneficial Use Map
Application G-17716, Permit G-17155