
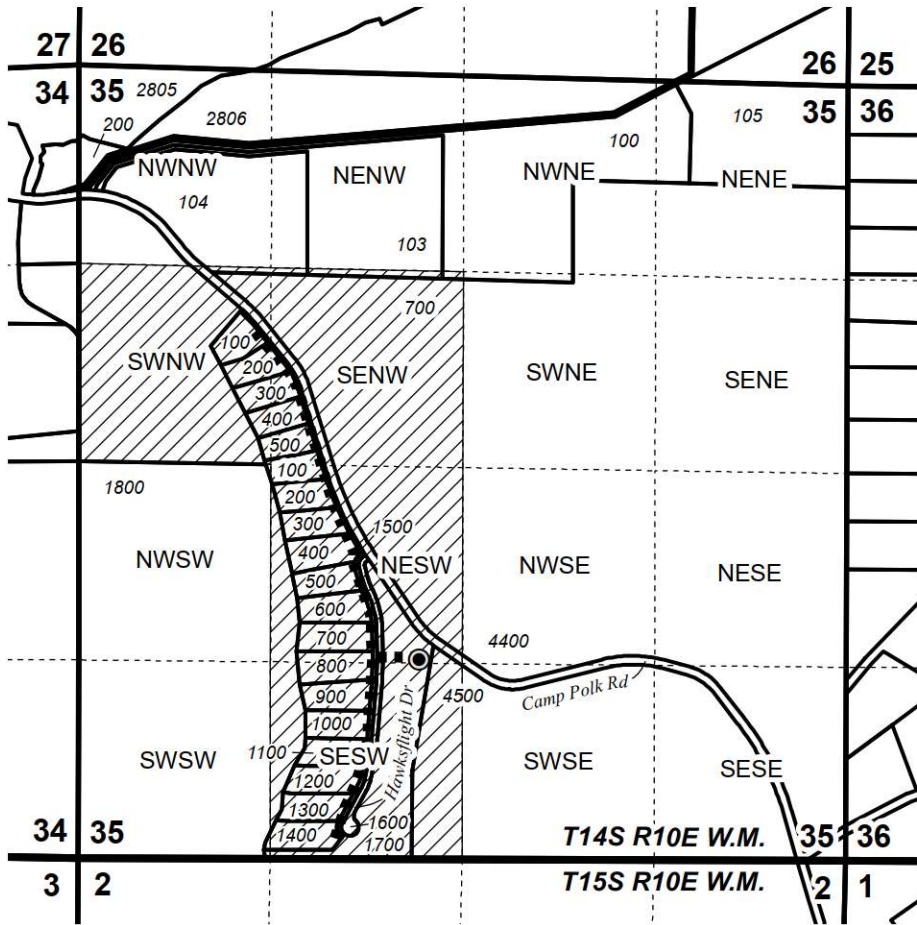


T14S R10E, WM DESCHUTES COUNTY, OR

- Well, Storage Tank, Pumps
- Pipeline
- ▨ POU QM
- ▭ Township
- ▭ Section
- Quarter Quarter
- ▭ Tax Lot

Well (DESC 0001) Location:
1372' N, 2343' E of SW Cor Sec 35

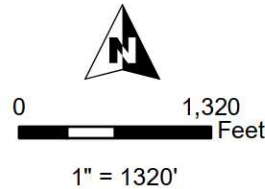

RENEWS: 06/30/2026



CLAIM OF BENEFICIAL USE MAP
Aspen Lakes Utility Company, LLC

This map is not intended
to provide legal dimensions
or locations of property
ownership lines.

WATER RIGHT SERVICES, LLC
PO BOX 1830, BEND, OR 97709
WWW.OREGONWATER.US CCB # 197121
johnshort@usa.com 541-389-2837