
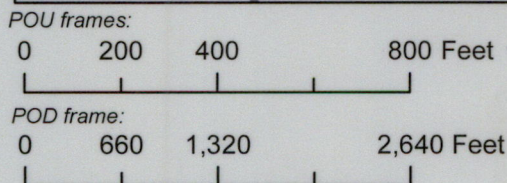
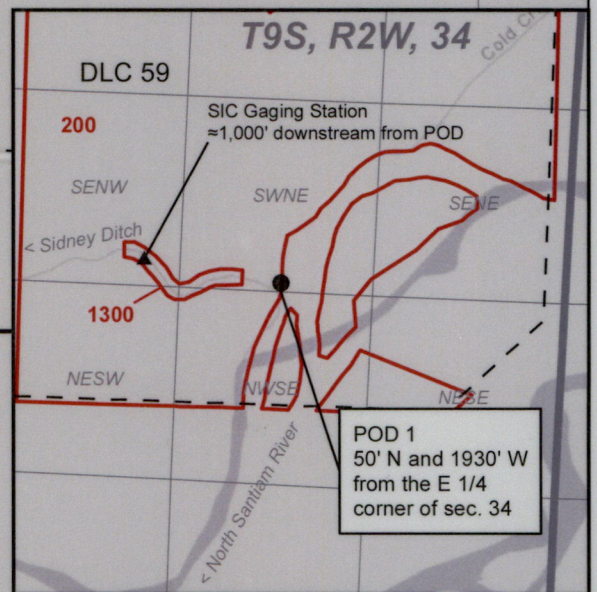


Sidney Irrigation Cooperative - Claim of Beneficial Use Transfer T-13050

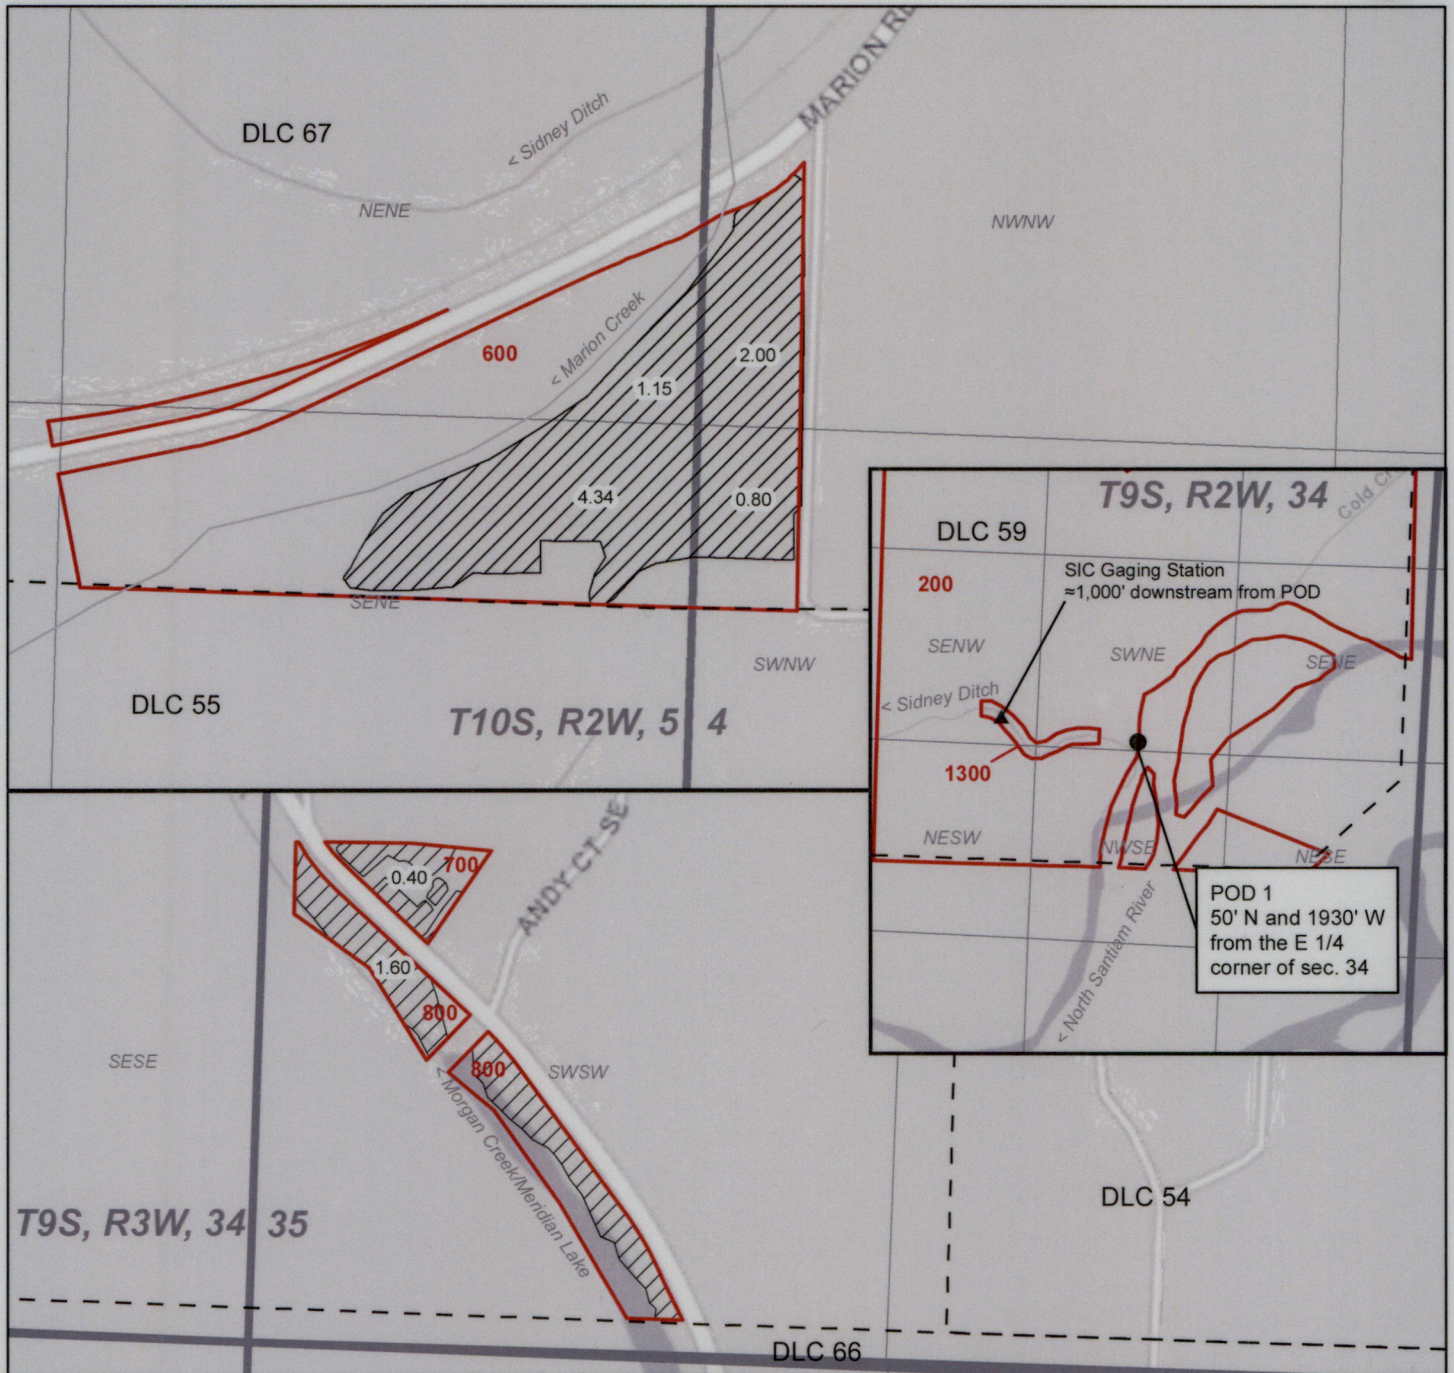

This map is not intended to provide legal dimensions or locations of property ownership lines.

Legend

- IR POU
- Taxlot
- DLC



Received by OWRD

JAN 31 2025

EXPIRES: 12-31-2026

Salem, OR