



# CLAIM OF BENEFICIAL USE MAP

TO CHANGE PLACE OF USE AND POINT OF APPROPRIATION  
PER T-12833 FOR GOLDEN RULE FARMS, INC.

SECTION 34, TOWNSHIP 26 SOUTH, RANGE 32 EAST, W.M.  
TAX LOTS: 1300, 1700, & 1800

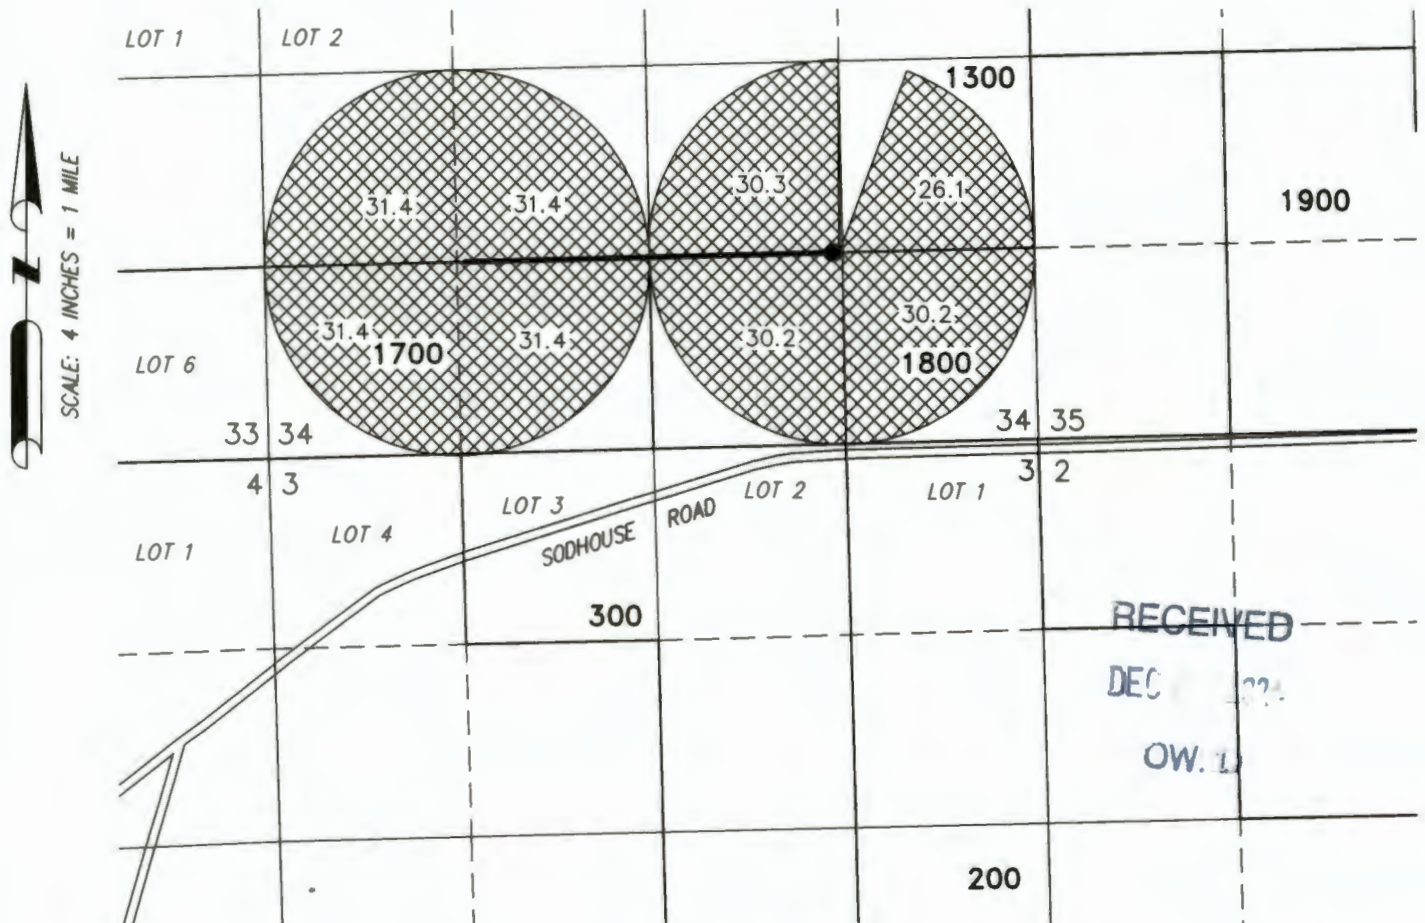

- WELL (HARN 52695)  
LOCATED IN THE SE 1/4 SE 1/4 SECTION 34, T26S R32E, W.M. AND  
1310 FEET NORTH AND 1260 FEET EAST FROM THE S 1/4 CORNER OF  
SECTION 34.  
FLOW METERS ARE LOCATED 5' WEST FROM EAST PIVOT AND 5' EAST  
FROM WEST PIVOT.

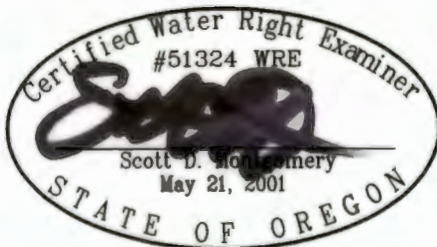

242.4 ACRES IR FROM WELL (G-17544), AS SHOWN.

RENEWAL DATE: 12/31/2024

THIS MAP IS FOR THE PURPOSE OF LOCATING A WATER RIGHT ONLY AND HAS NO  
INTENT TO PROVIDE LEGAL DIMENSIONS OR THE LOCATION OF PROPERTY LINES.

PREPARED FOR:

GOLDEN RULE FARMS, INC.  
P.O. BOX 255  
CHRISTMAS VALLEY, OR 97641

PREPARED BY:



ALL POINTS ENGINEERING AND SURVEYING, INC.  
P.O. BOX 767  
(541) 548-5833  
TERREBONNE, OR 97760  
www.APEandS.com