



SUPERSEDING

T 4 S R 39 E

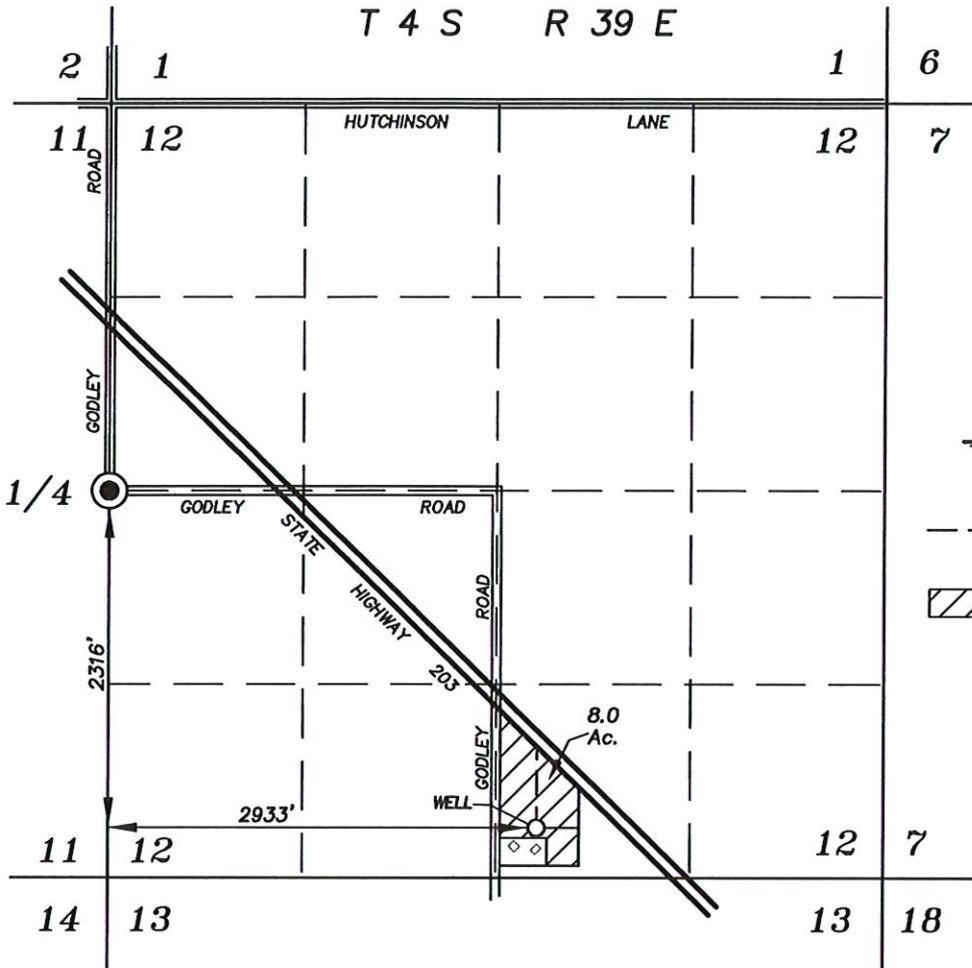

SCALE: 1"=1320'

- Existing 4" Mainline
-  Lands with primary rights from well.

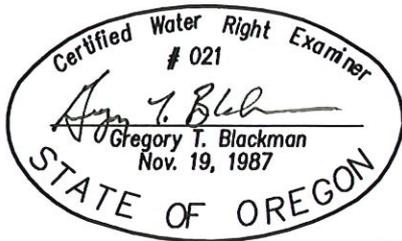

SUPERSEDING  
February 20, 2007

FINAL PROOF MAP OF  
IRRIGATION FROM A WELL  
FOR  
RAY & DONNA BATES  
BY

BAGETT - GRIFFITH & BLACKMAN  
2006 ADAMS AVENUE  
LAGRANDE, OREGON 97850

NOTE: The preparation of this map was for the purpose of identifying the location of the proposed water right and has no intent to provide dimensions or location of property ownership lines. Location information shown hereon was furnished by the applicant.

RECEIVED

FEB 22 2007

WATER RESOURCES DEPT  
SALEM, OREGON

Application No. G- 15999  
Permit Number G- 15552