


T.8S. R.2W. Section 10, W.M.

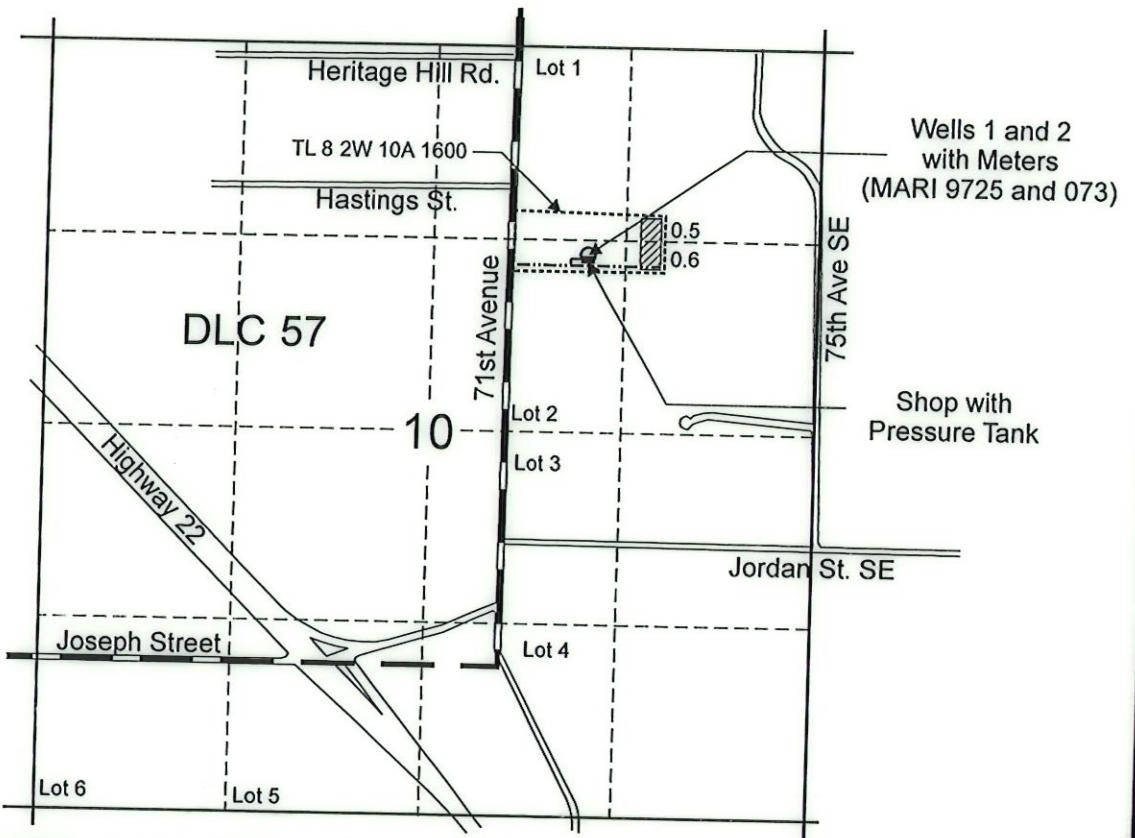

Well 1 (MARI 9725), is located 2,830 feet north and 550 feet east from the SE corner of DLC 57.
 Well 2 (MARI 073), is located 2,838 feet north and 550 feet east from the SE corner of DLC 57.

- Area (1.1 Acres) supplemental irrigated under Application G-16709, Permit G-16249.
- Tax lot boundary
- Donation Land Claim Boundary
- Irrigation main line, buried

RECEIVED

MAY 03 2012

WATER RESOURCES DEPT
SALEM, OREGON



Scale: 1" = 1,320'



0 1,320
Feet

This map was prepared for the purpose of identifying the location of a water right only and is not intended to provide legal dimensions or location of property ownership lines.

Claim of Beneficial Use Map Application G-16709, Permit G-16249

Larry Manning
T.8S. R.2W. Section 10, W.M.

Pacific Hydro-Geology Inc.

04/2012