D-29.9

FINAL PROOF SURVEY

FOR

MILDRED GARRETT
HC 60 BOX 4310
LAKEVIEW, OREGON 97630
(503) 947-2940

APPLICATION NO. 69868, R69872

PERMIT NO. 50968, R11221

TOWNSHIP 40 SOUTH, RANGE 16 EAST, W.M., LAKE COUNTY, OREGON

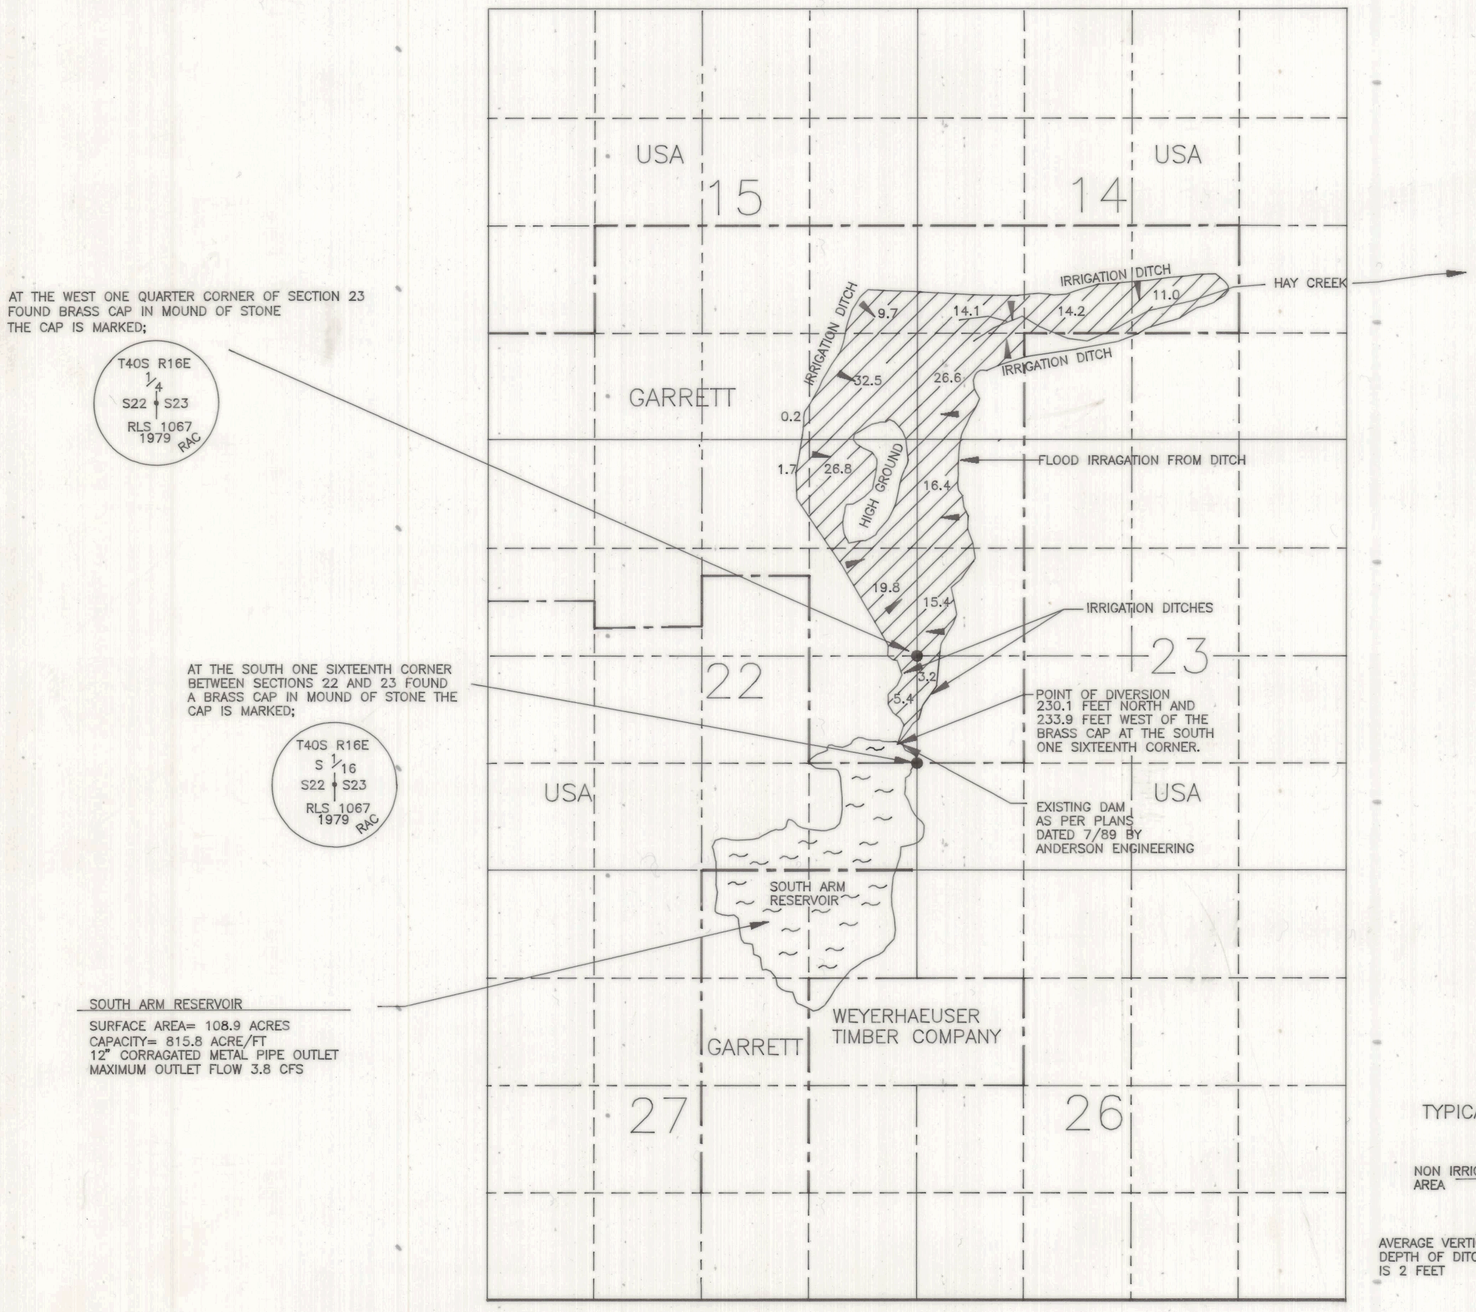

AT THE WEST ONE QUARTER CORNER OF SECTION 23
FOUND BRASS CAP IN MOUND OF STONE
THE CAP IS MARKED;

T40S R16E
1/4
S22 S23
RLS 1067
1979 RAC

AT THE SOUTH ONE SIXTEENTH CORNER
BETWEEN SECTIONS 22 AND 23 FOUND
A BRASS CAP IN MOUND OF STONE THE
CAP IS MARKED;

T40S R16E
S 1/16
S22 S23
RLS 1067
1979 RAC

SOUTH ARM RESERVOIR

SURFACE AREA= 108.9 ACRES
CAPACITY= 815.8 ACRE/FT
12" CORRAGATED METAL PIPE OUTLET
MAXIMUM OUTLET FLOW 3.8 CFS

Certified Water Right Examiner
#005
Darryl J. Anderson
Nov. 19, 1987
STATE OF OREGON
EXPIRES 12/31/95

N

SCALE: 1"=1320'

LEGEND

- SECTION LINE
- 1/4 SECTION LINE
- 1/16 SECTION LINE
- APPROXIMATE OWNERSHIP LINES

NOTE: PREPARATION OF THIS MAP IS FOR IDENTIFYING PROPOSED WATER RIGHTS ONLY. IT HAS NO INTENT TO PROVIDE LOCATIONS OR DIMENSIONS OF PROPERTY BOUNDARIES.

TOTAL ACREAGE BEING IRRIGATED= 197.0 ACRES
IRRAGATION OF PASTURE LANDS
AREA WAS GROWING GRASS

TYPICAL IRRIGATION DITCH CROSS SECTION

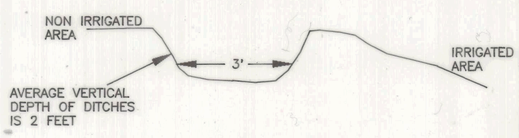

NO SCALE

PREPARED FOR:

MILDRED GARRETT
HC 60 BOX 4310
LAKEVIEW, OREGON 97630
(503) 947-2940

RECEIVED
AUG 12 1994
WATER RESOURCES DEPT.
SALEM, OREGON

PREPARED BY:

ANDERSON ENGINEERING AND SURVEYING
P.O. BOX 28
HC 64 BOX 24
LAKEVIEW, OREGON 97630
(503) 947-4407 FAX 947-2321

JULY 29, 1994 SHEET 1 OF 1